


1797

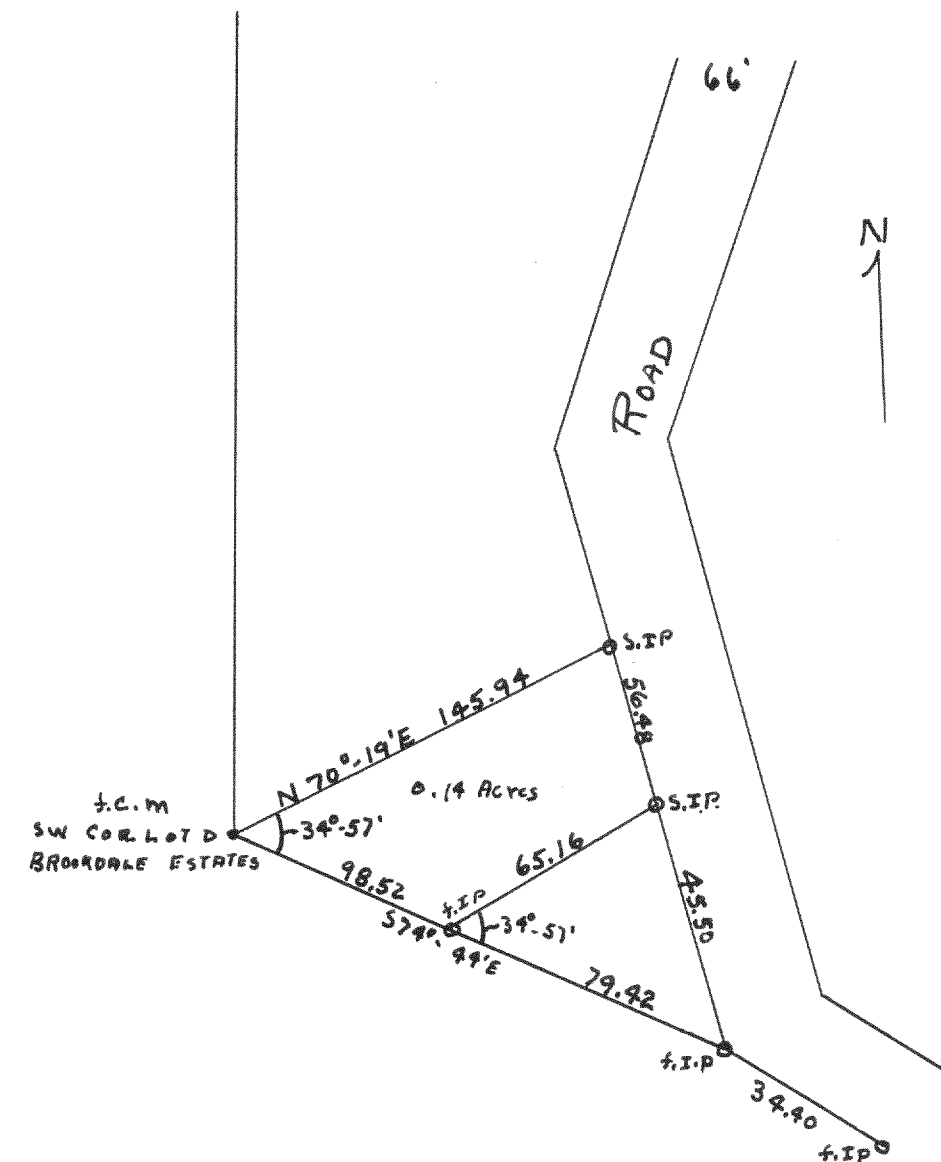


Plot of survey of two parcels of land located in the
W 1/2 of Section 4 T1N R1E of Walworth County Wisconsin

June 23, 1947

Lloyd L Jensen
County Surveyor
RS

1798

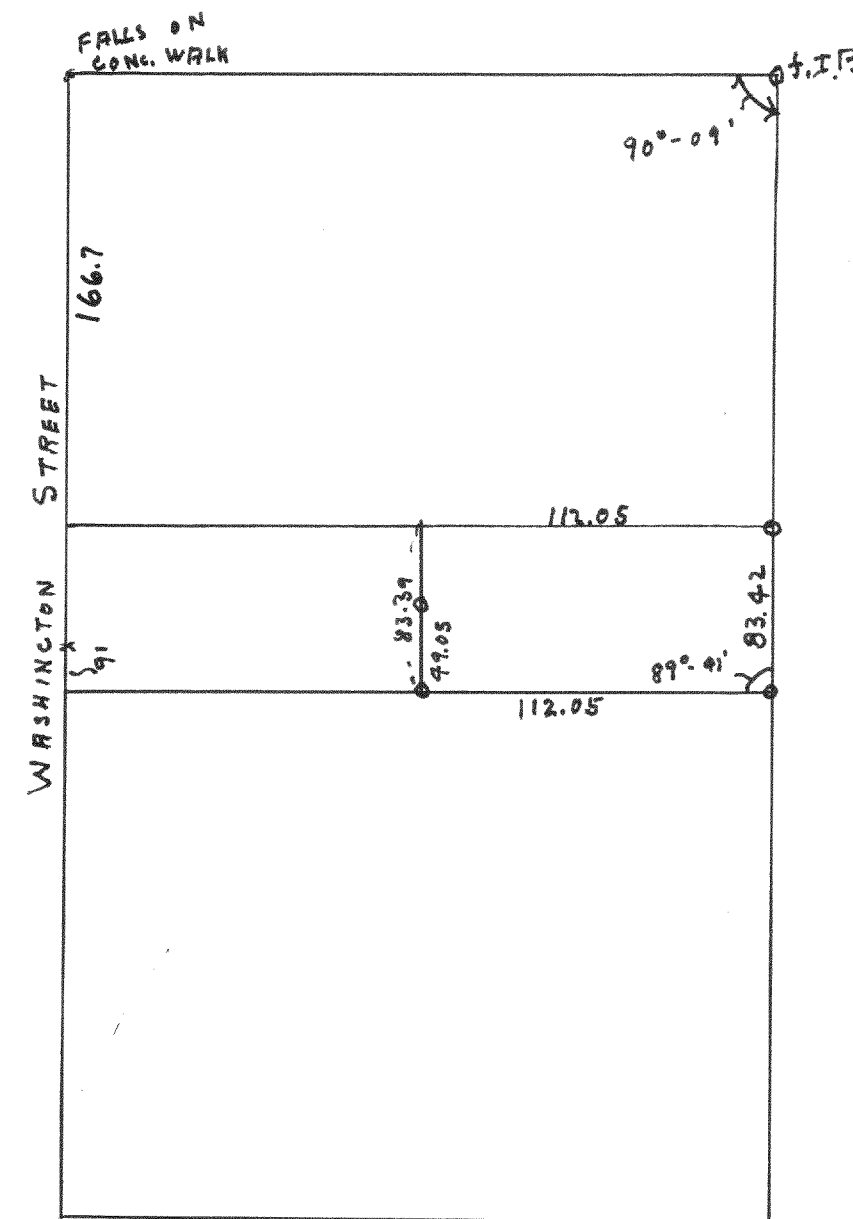

Plot of survey of the East 1/2 of Lot 4 Block 21 of original Plat of
the city of Elkhorn, Walworth County, Wisconsin

July 1947

Floyd L. Frisen
County Surveyor
~~1920~~