



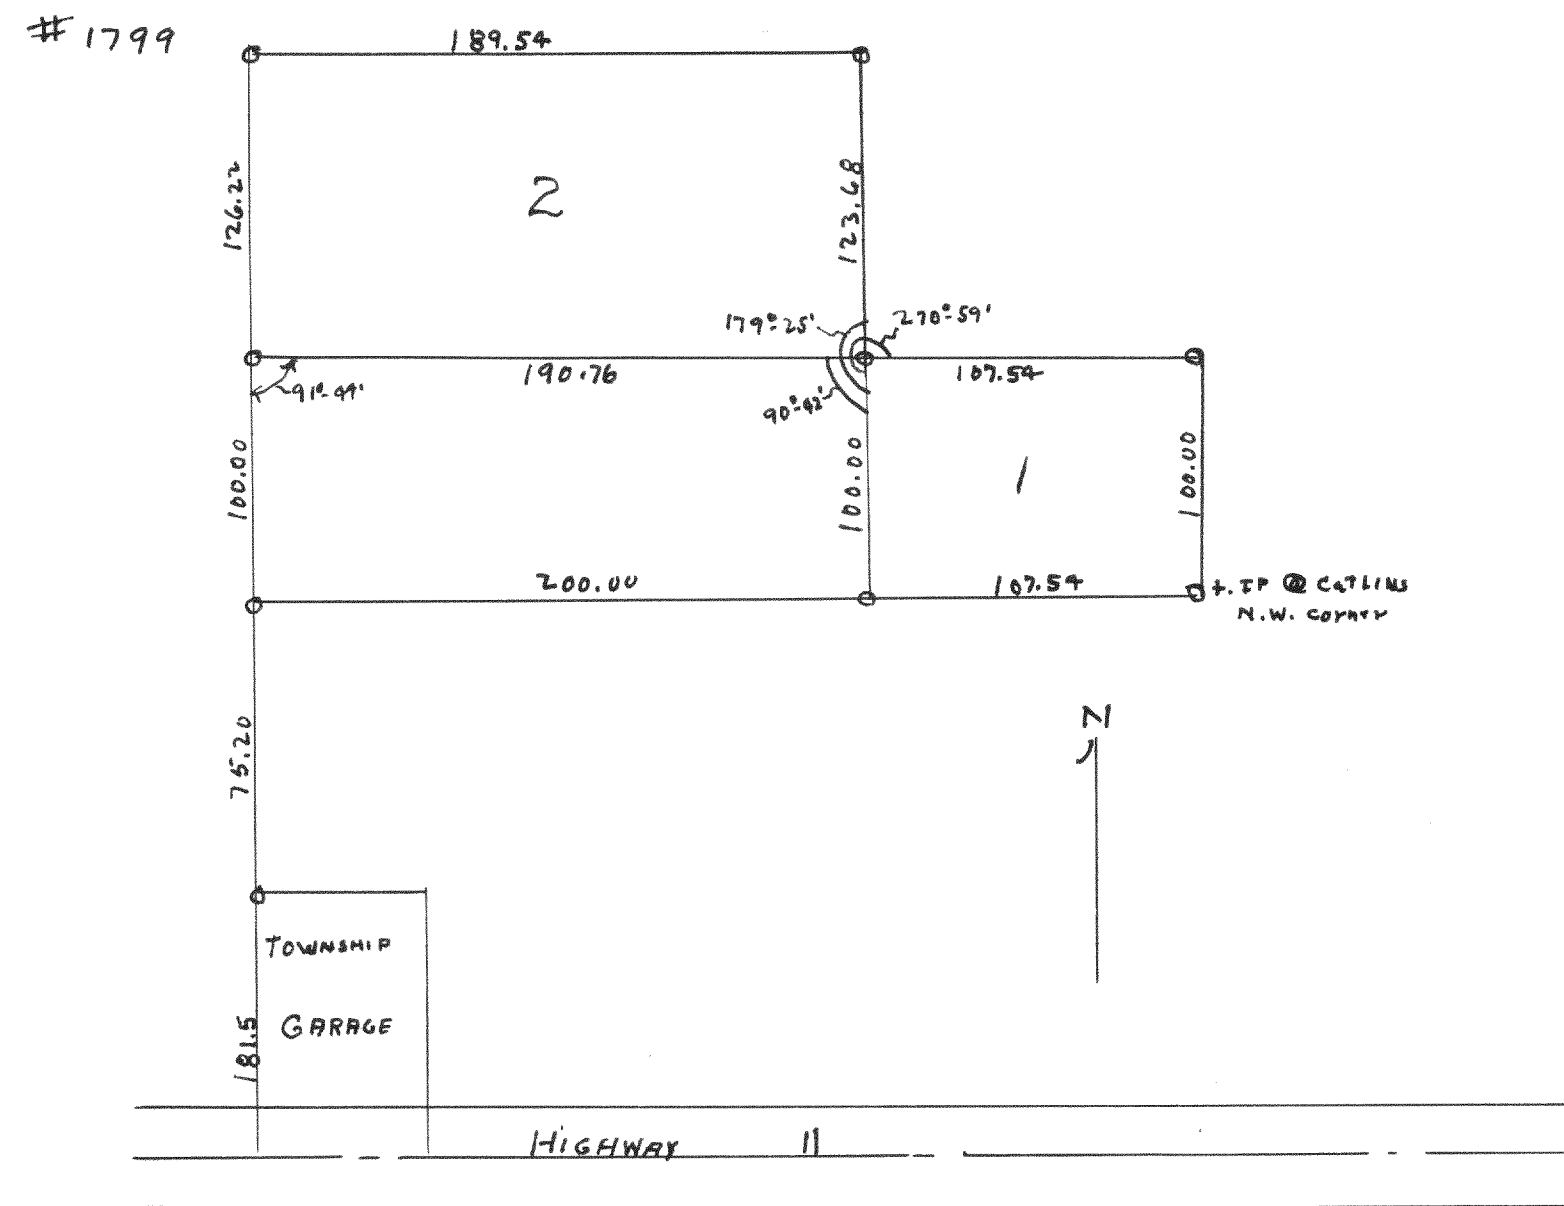

Plot of survey of parcels 1 and 2 located in the NE 1/4 of
Section 26 T3N R17E of Walworth County Wisconsin

July 16, 1947

Floyd S Jensen
County Surveyor
RST

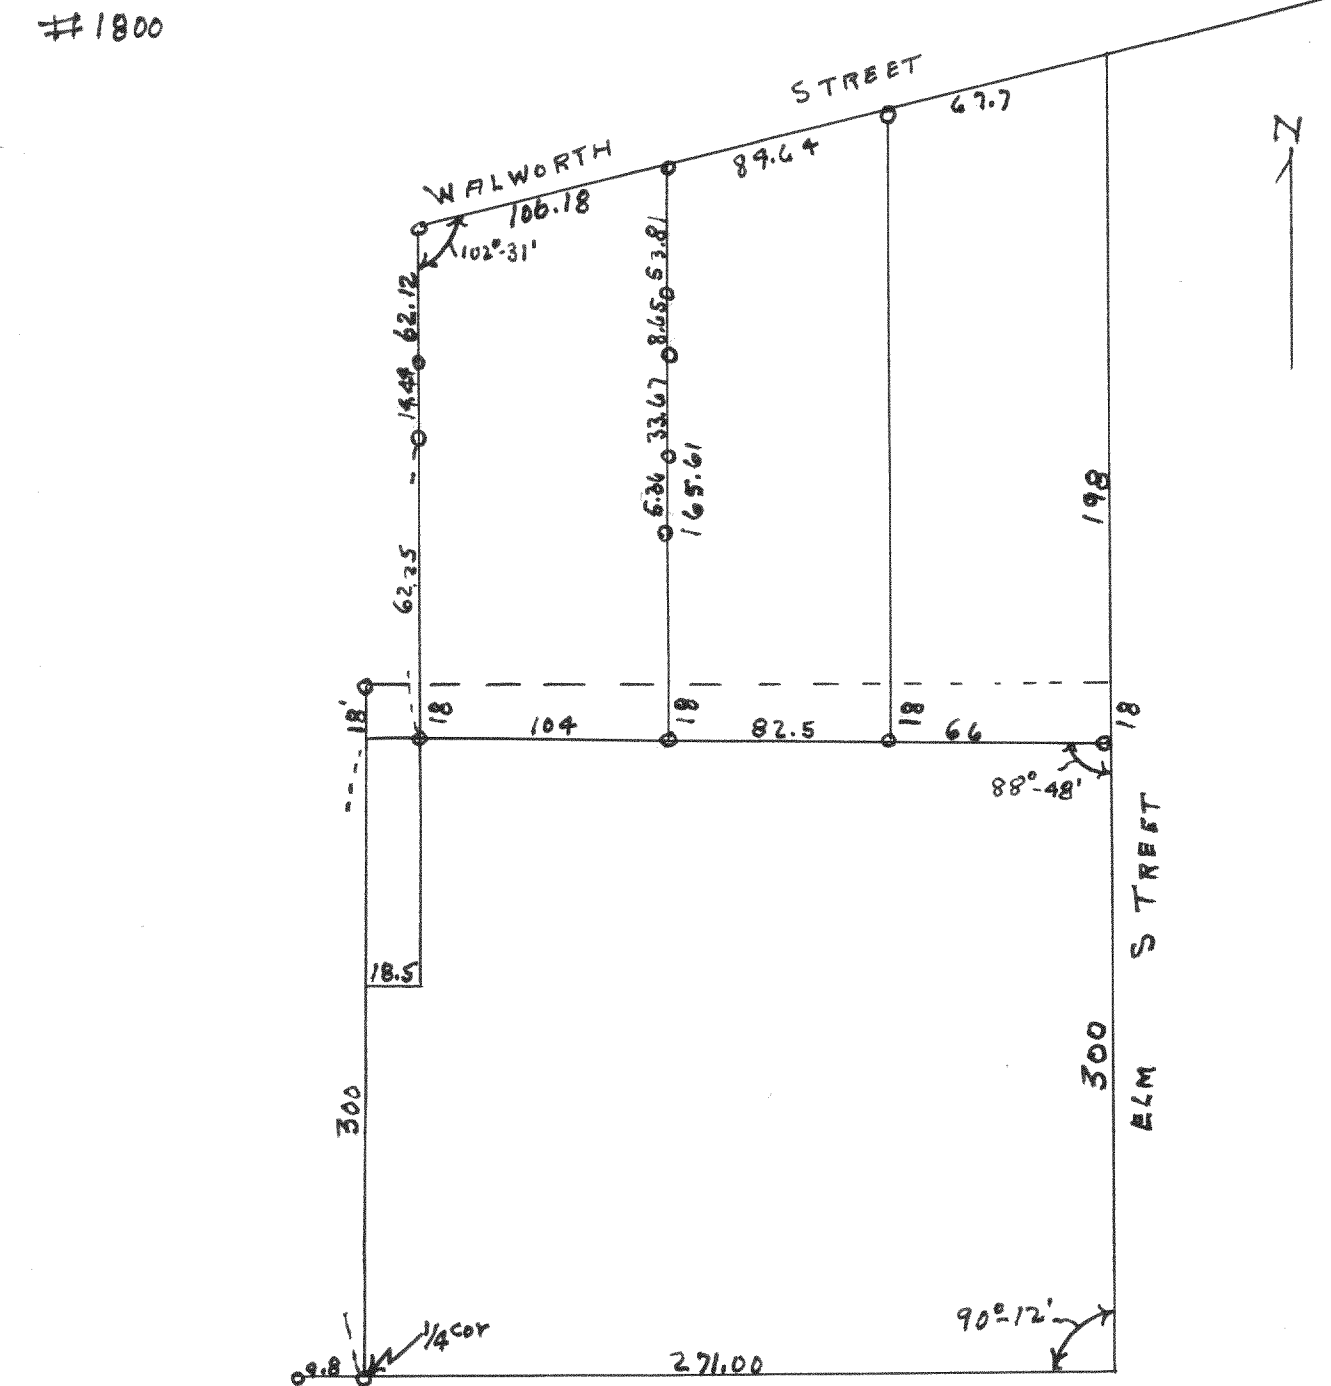

Plot of survey of Clyde M. Blakeslee land located on N. Malworth st
City of Elkhorn, Malworth County Wisconsin

May 5, 1947

Lloyd L Jensen
County Surveyor
-200