



1801

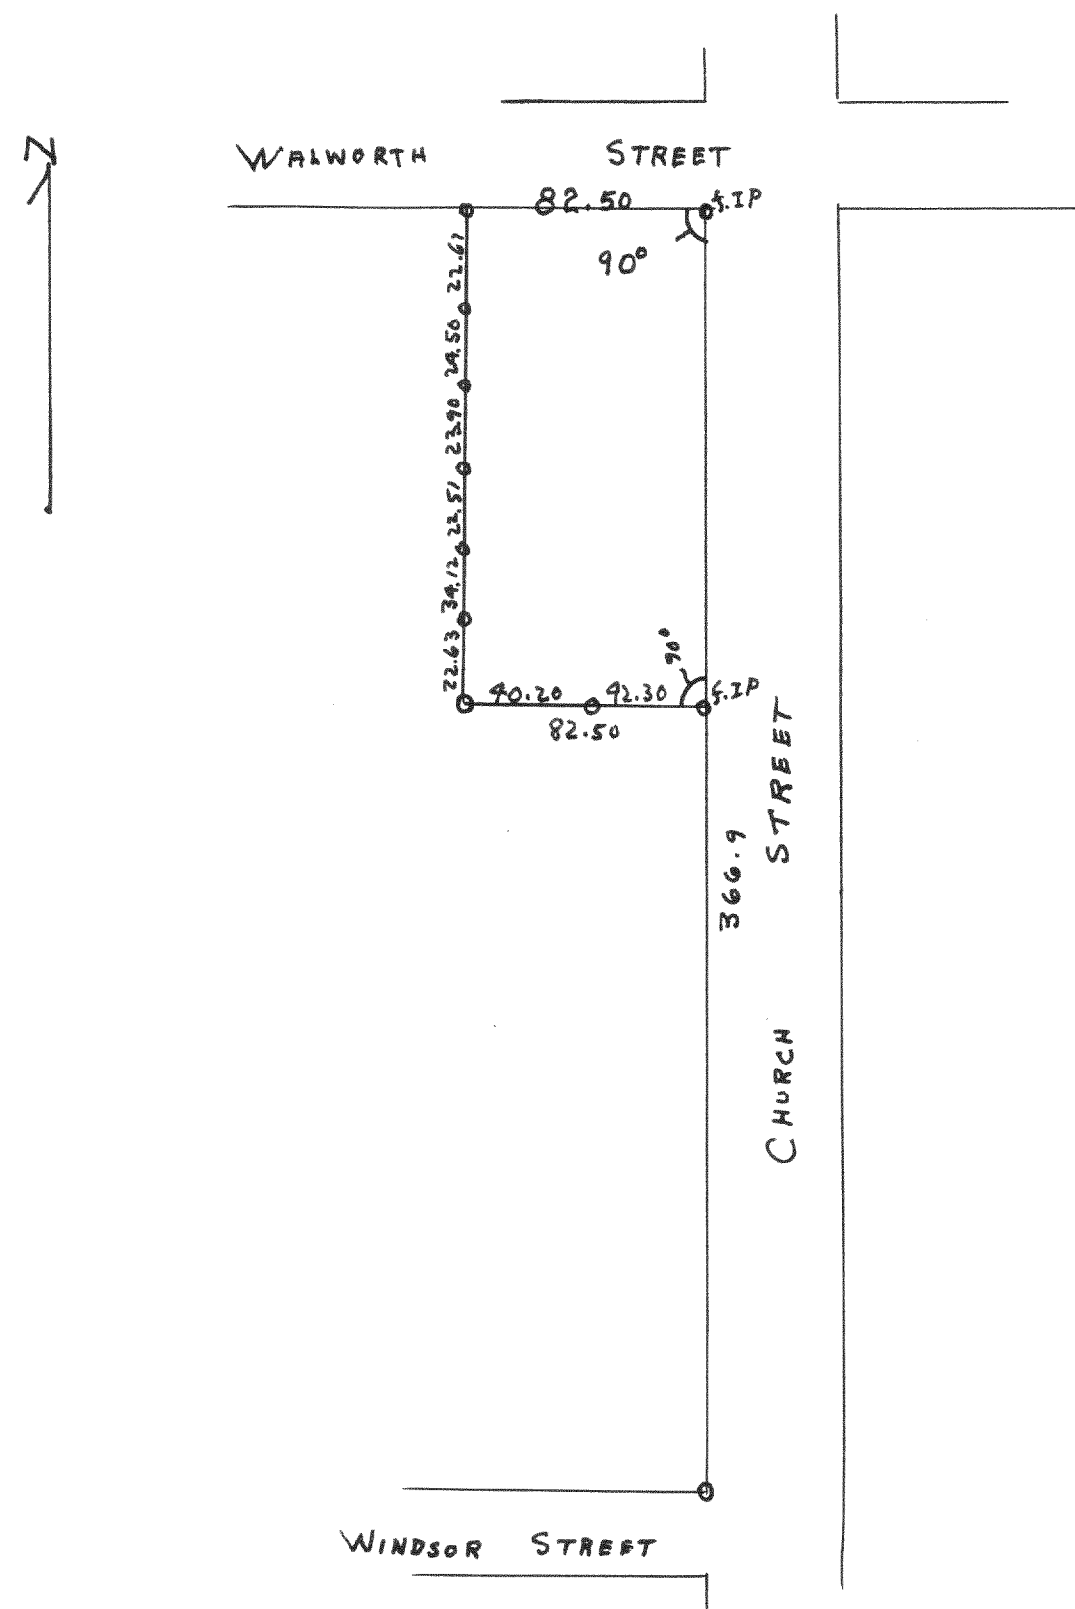

Plot of survey of the Deane Property located in
the City of Elkhorn, Walworth County Wisconsin
1947 Lloyd & Jensen
County Surveyor
LJS

#1802

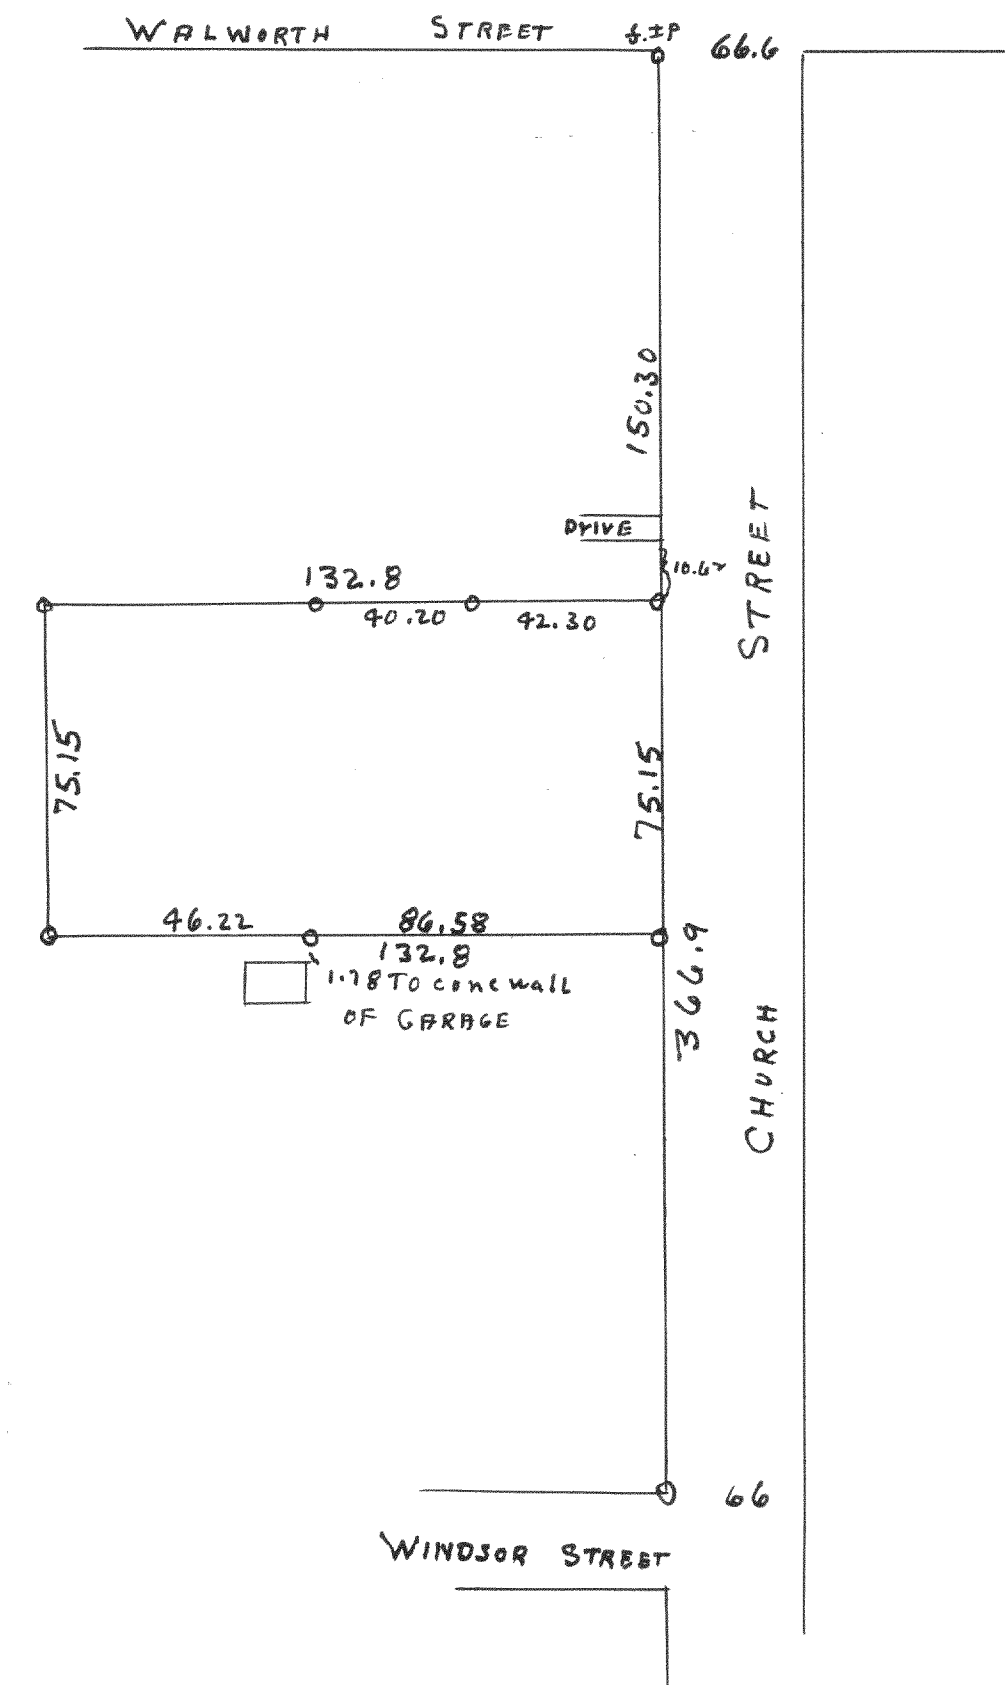

Plot of survey of bellevue property located in the city
of Elkhorn, Walworth County, Wisconsin
1947
Floyd S Jensen
County Surveyor
1948