


1807

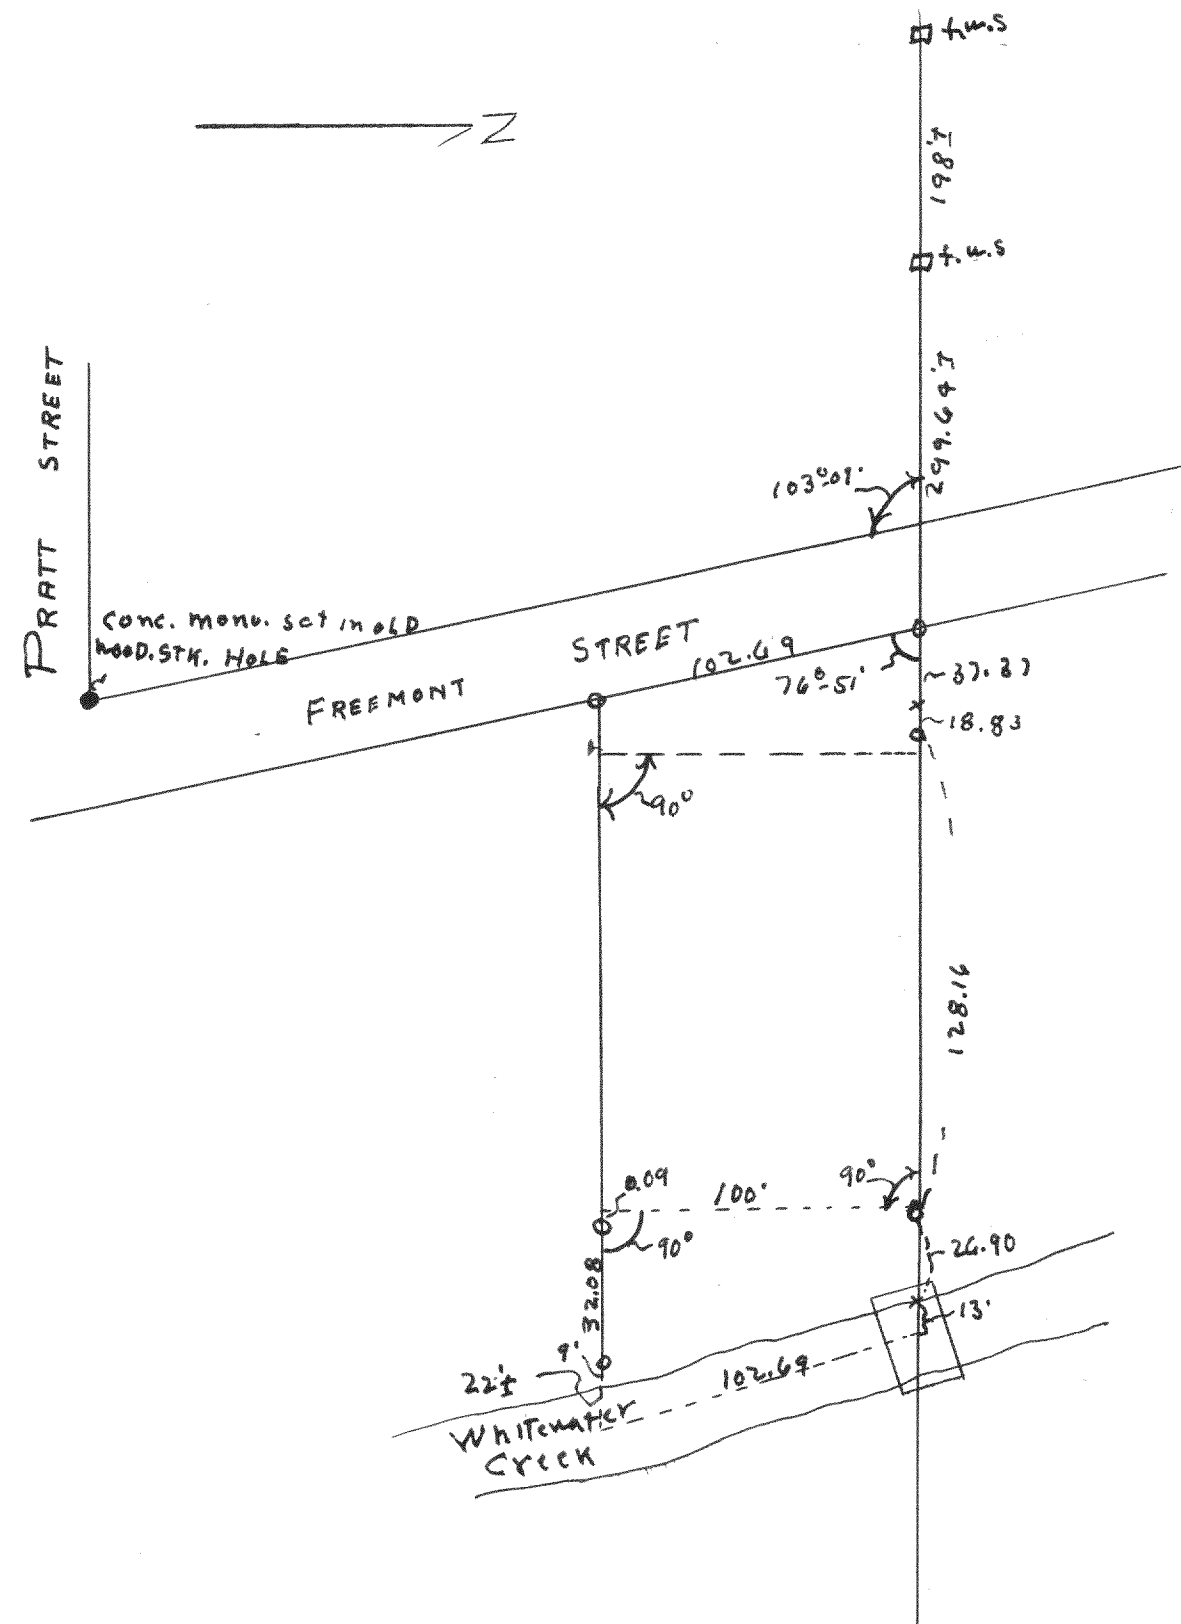


Plot of survey of a parcel of land located in the city of Whitewater, Walworth County, Wisconsin

Sept 29, 1947

Lloyd E Jensen
County Surveyor
LSJ

1808

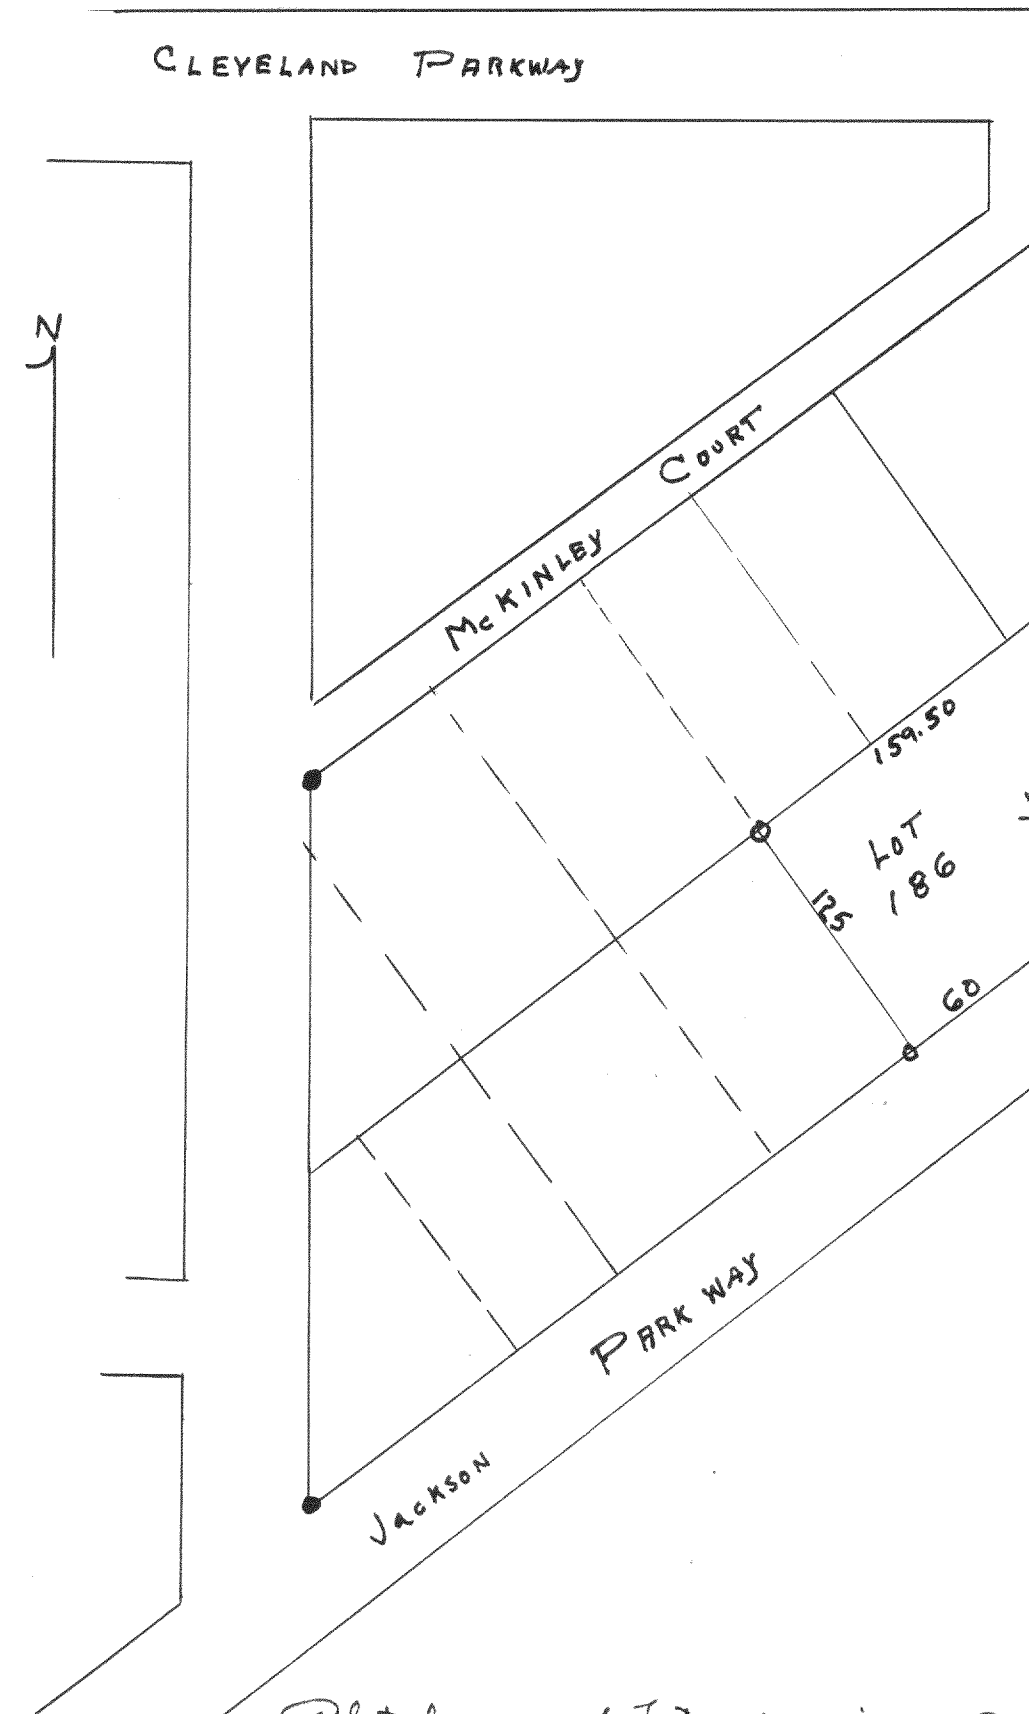

Plot of survey of Lot 186 original Plot of Cedar Point Park subdivision located in the Village of Williams Bay, Walworth County, Wisconsin

1947

Lloyd E Jensen
County Surveyor
LSJ