



H 1822

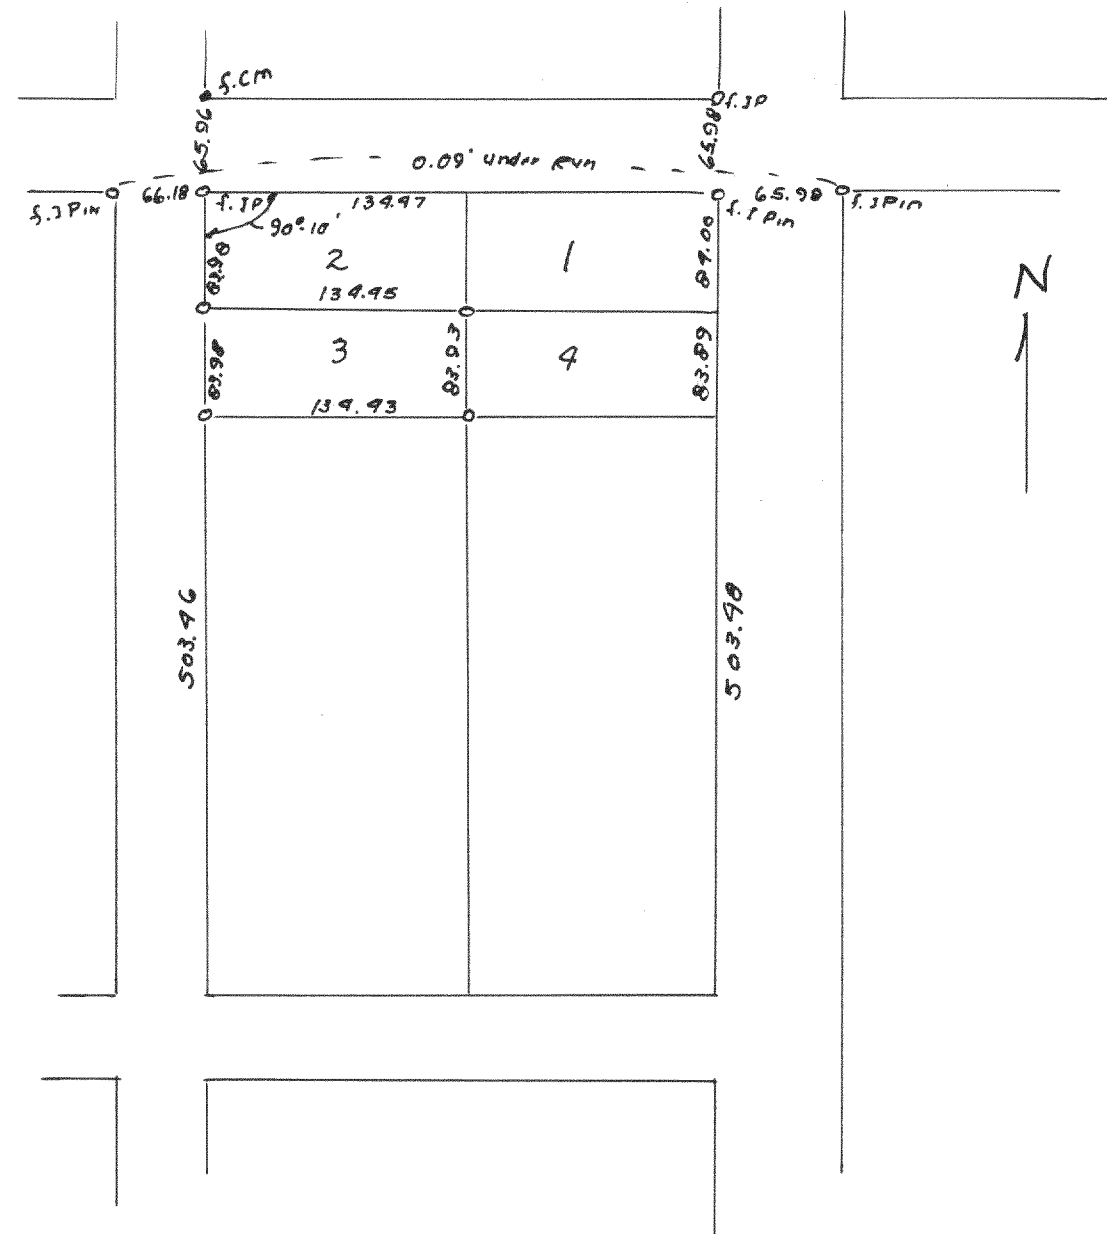

Plat of Survey of lot 3 of Davis Addition in the
City of Elkhorn, Walworth County
Sept 7, 1948
Lloyd L. Jensen
County Surveyor
Ct.

H 1823

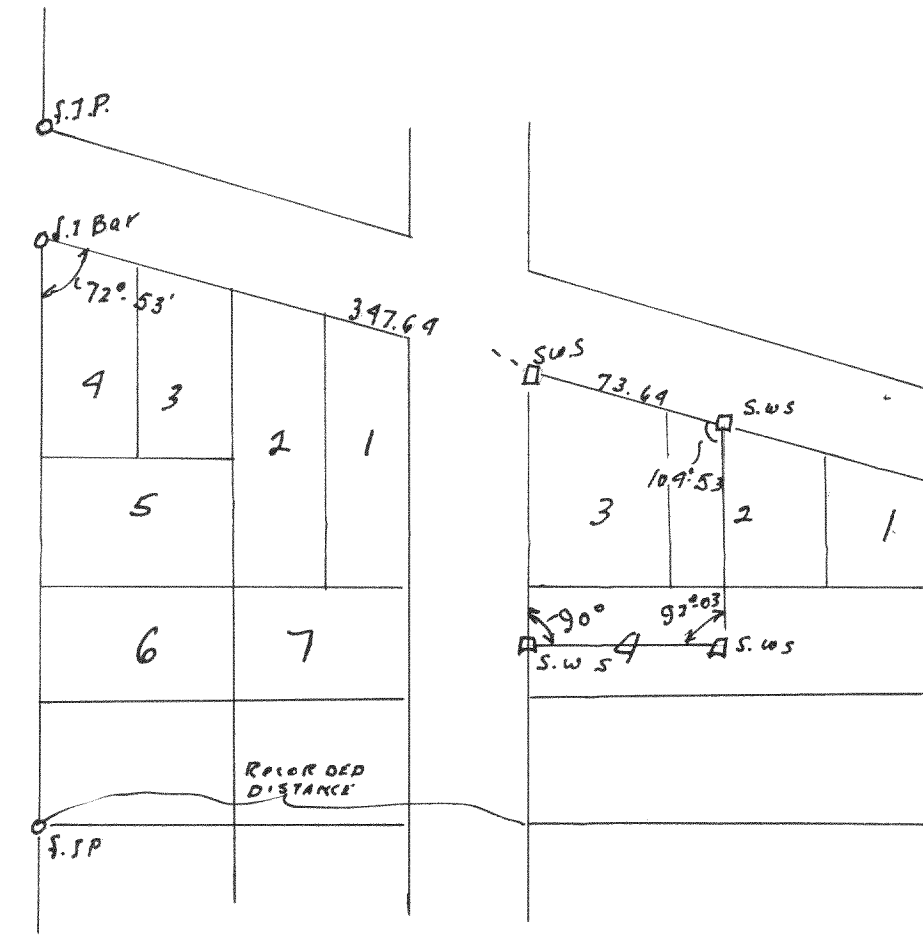

Plat of survey of parts of lots 2, 3, and 4 of Preston
Addition City of Elkhorn, Walworth County
lot owners. Walworth County
Sept 21, 1948
Lloyd L. Jensen
County Surveyor
Ct.