



1824

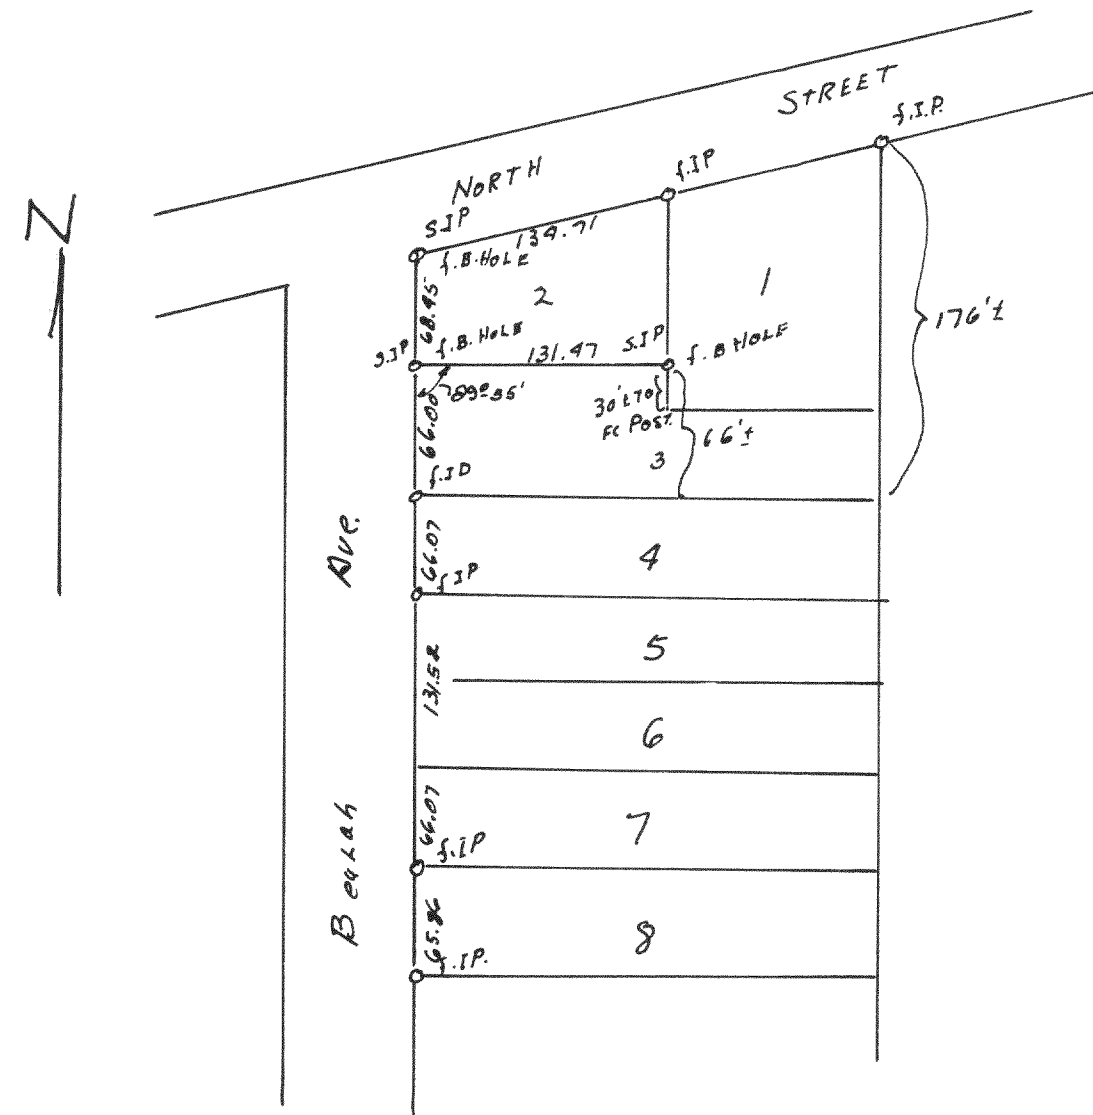

Plot of survey of lot 2 in Burlah Avenue Addition
in the Village of East Troy, Walworth County,
June 26, 1998
Lloyd L. Jensen
County Surveyor
et.

1825

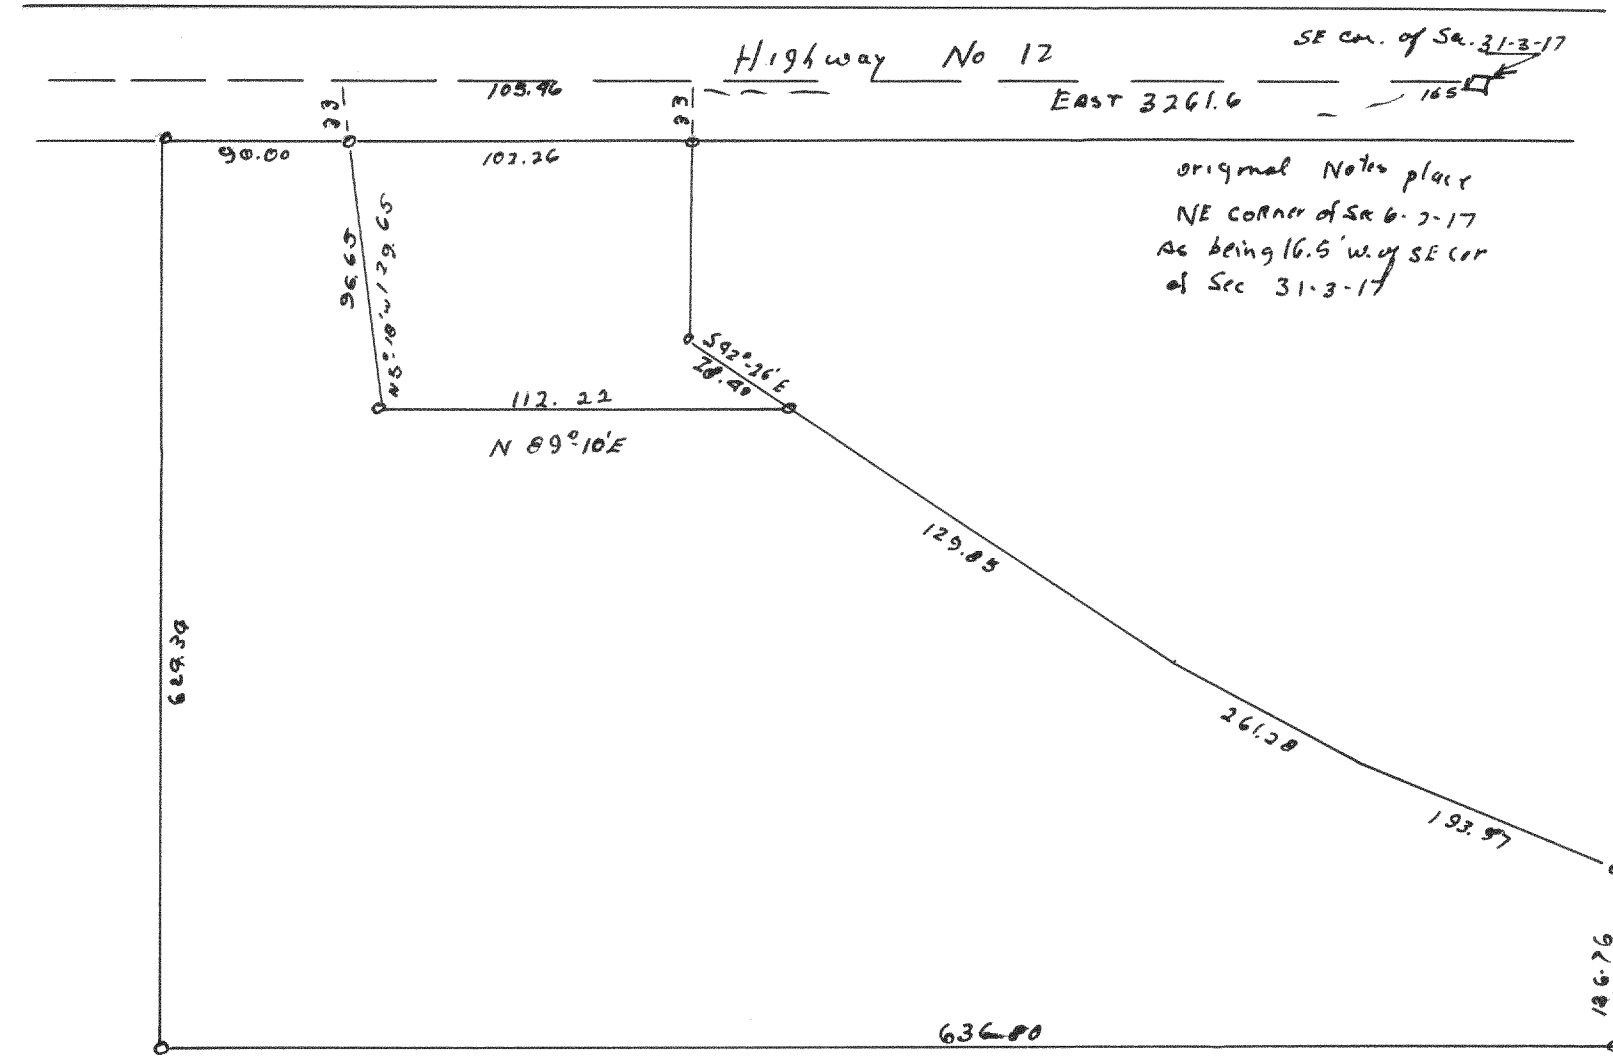

Plot of survey of Kalyman property located in the city of Elkhorn, Walworth County,
April 28, 1998

Lloyd L. Jensen
County Surveyor
et.