



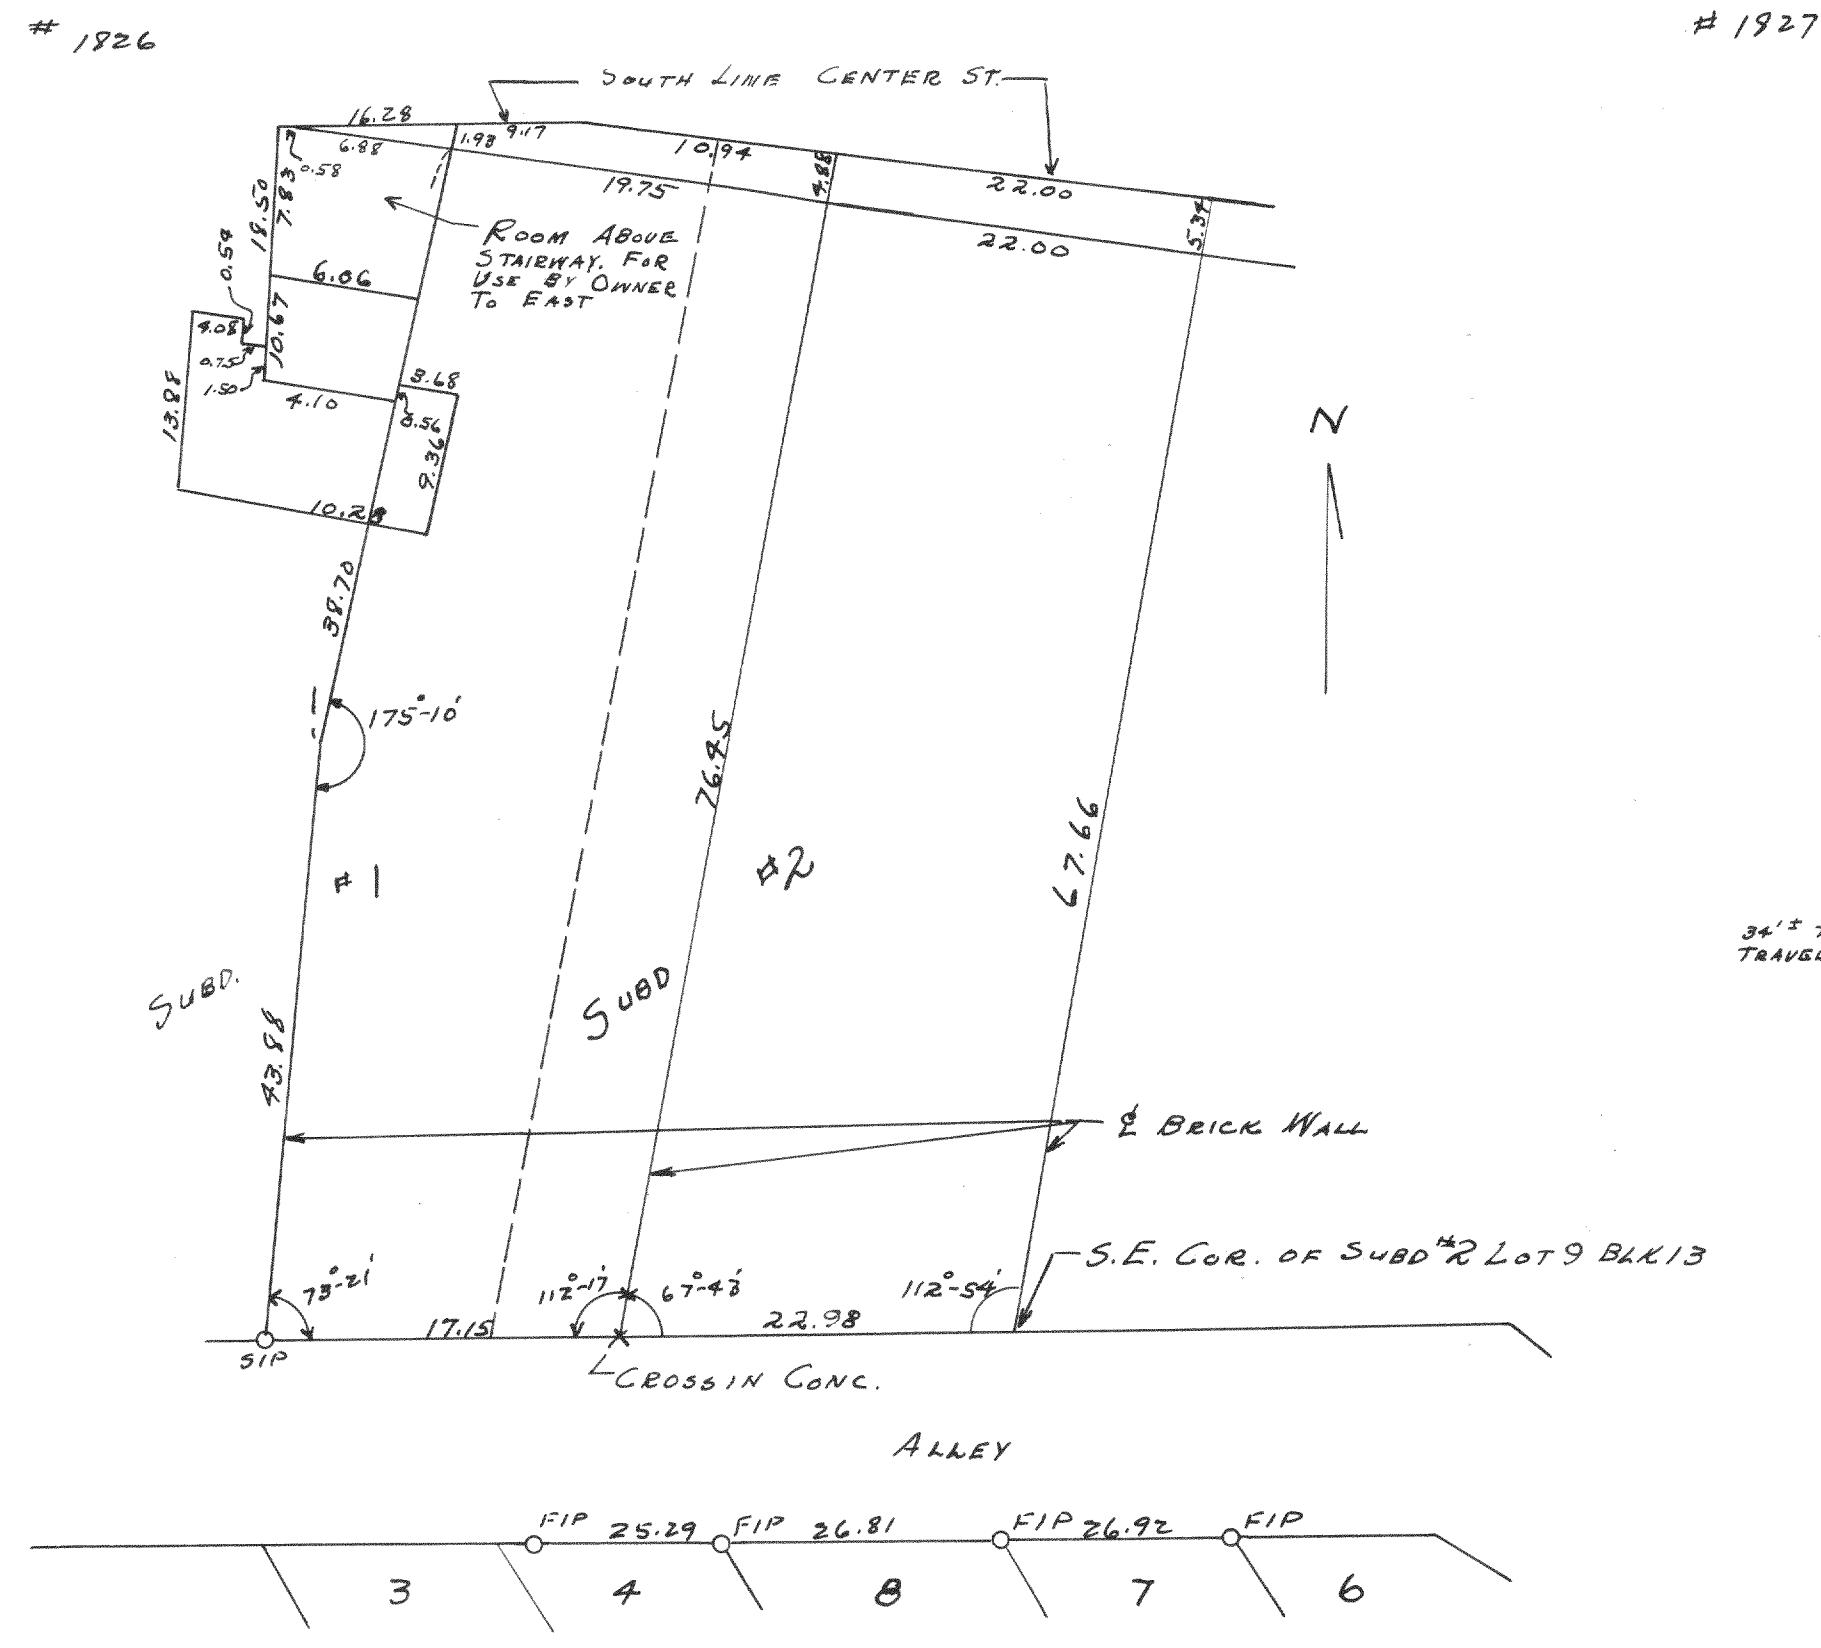

Plat of Survey of Subdivision #2 and part of Subdivision #1 of Lot 9 Block 13 of Original Plat of the City of Whitewater.
Oct. 1948
Lloyd L. Jensen
Clerk

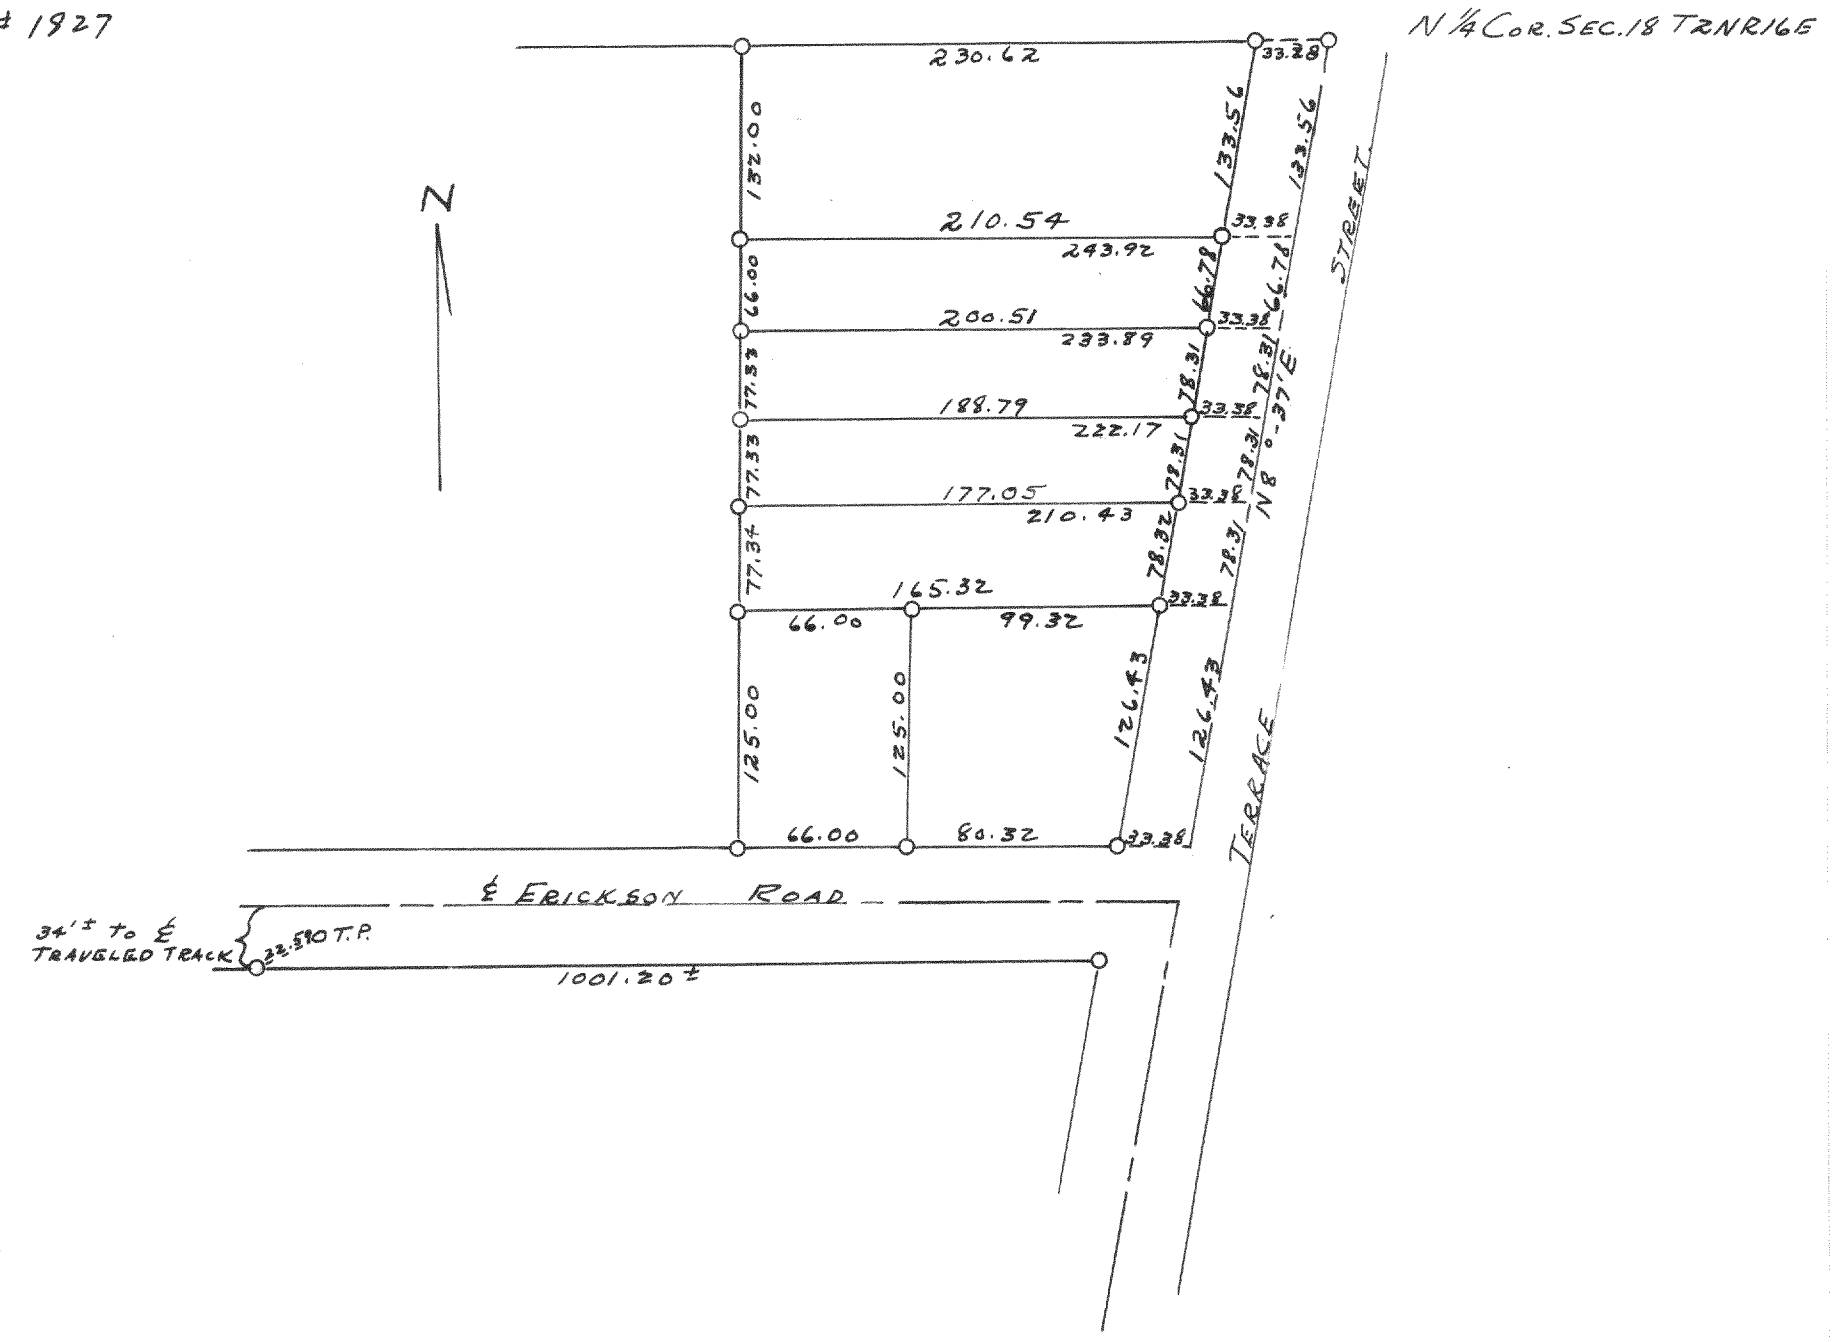

Plat of survey of land located in the N 1/2 of the NW 1/4 of section 18 in the city of Delavan T2N R16E
Aug 25, 1948
Lloyd L. Jensen
Clerk