


H 1828

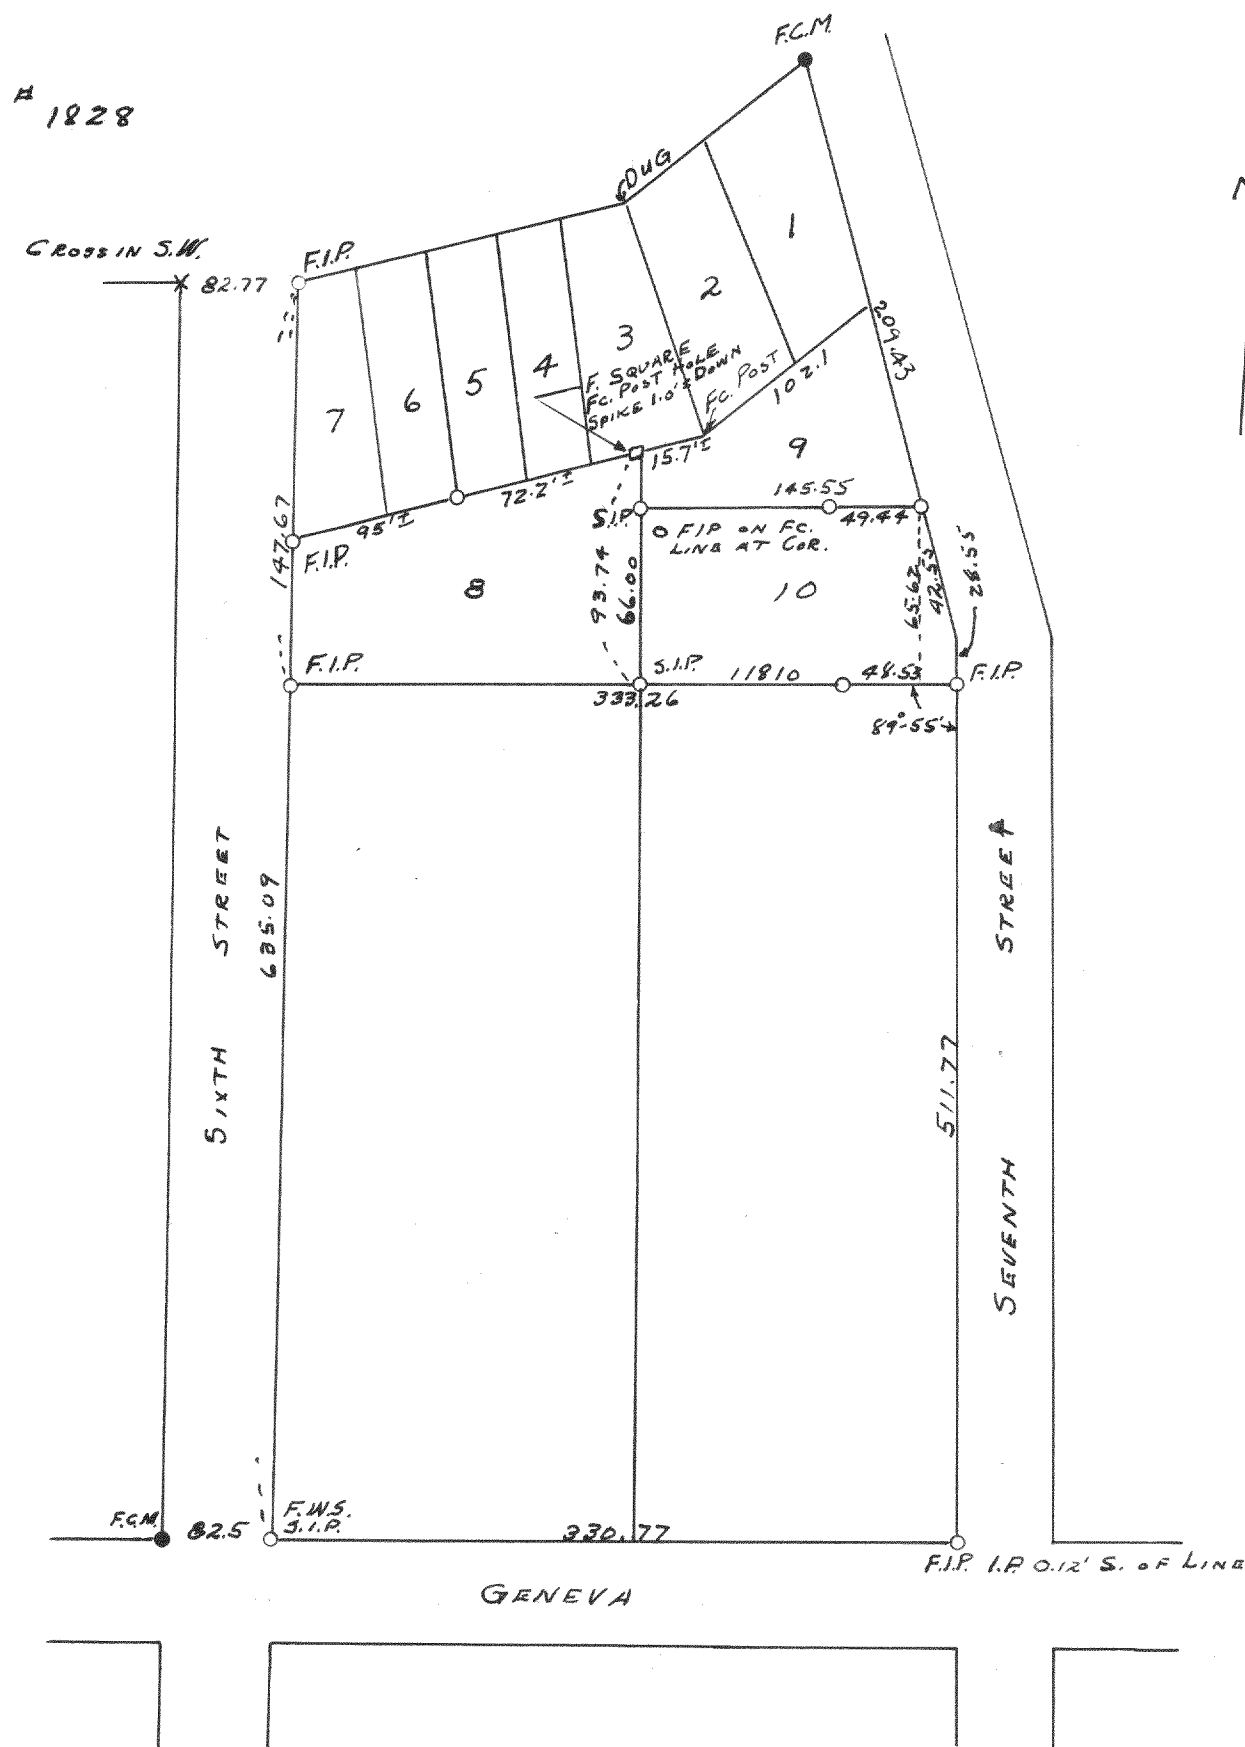

H 1829

