



1830

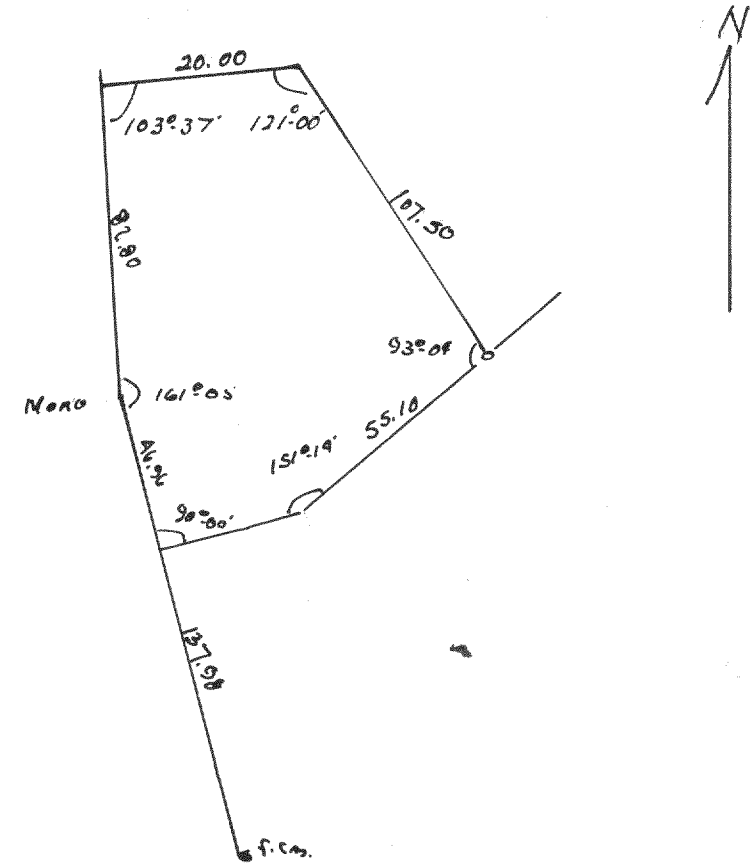

Plot of Survey of Lot 10 Block 10 of
 Lake Geneva Manor in the City of Lake Geneva
 Walworth County
 June 16, 1948

Lloyd L Jensen
 County Surveyor.
 C.L.

1831

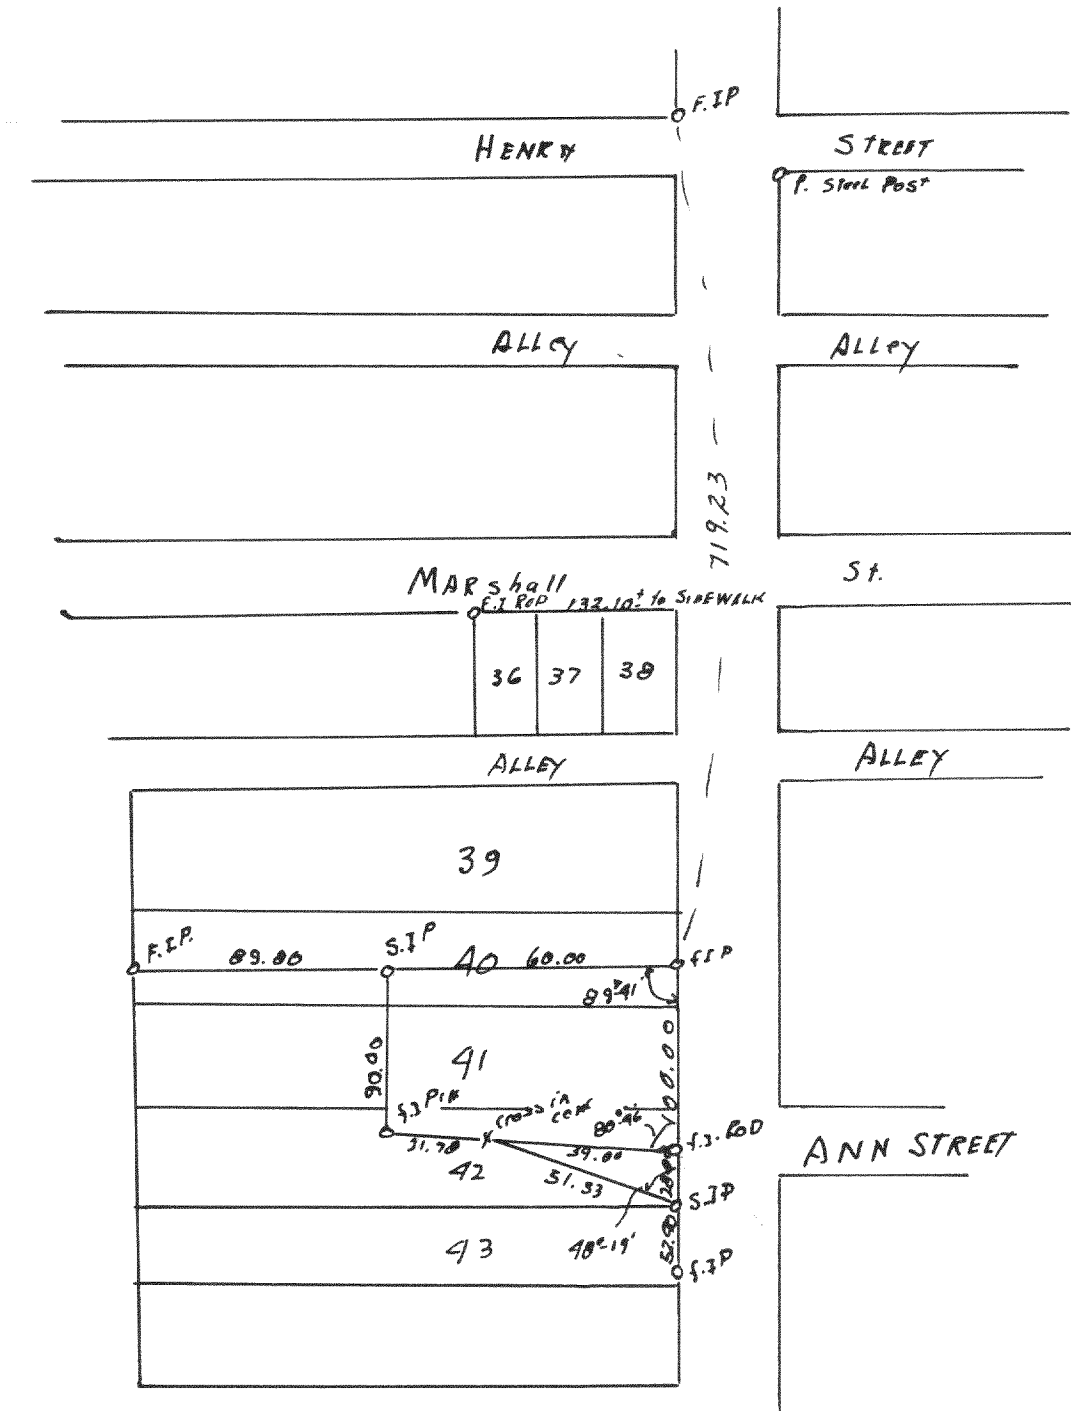

Plot of Survey of Parts of Lots 40, 41, and 42 of Kicks Add
 in the City of Lake Geneva. Walworth County

Dec 11, 1948

Lloyd L Jensen
 County Surveyor
 C.L.