


1822

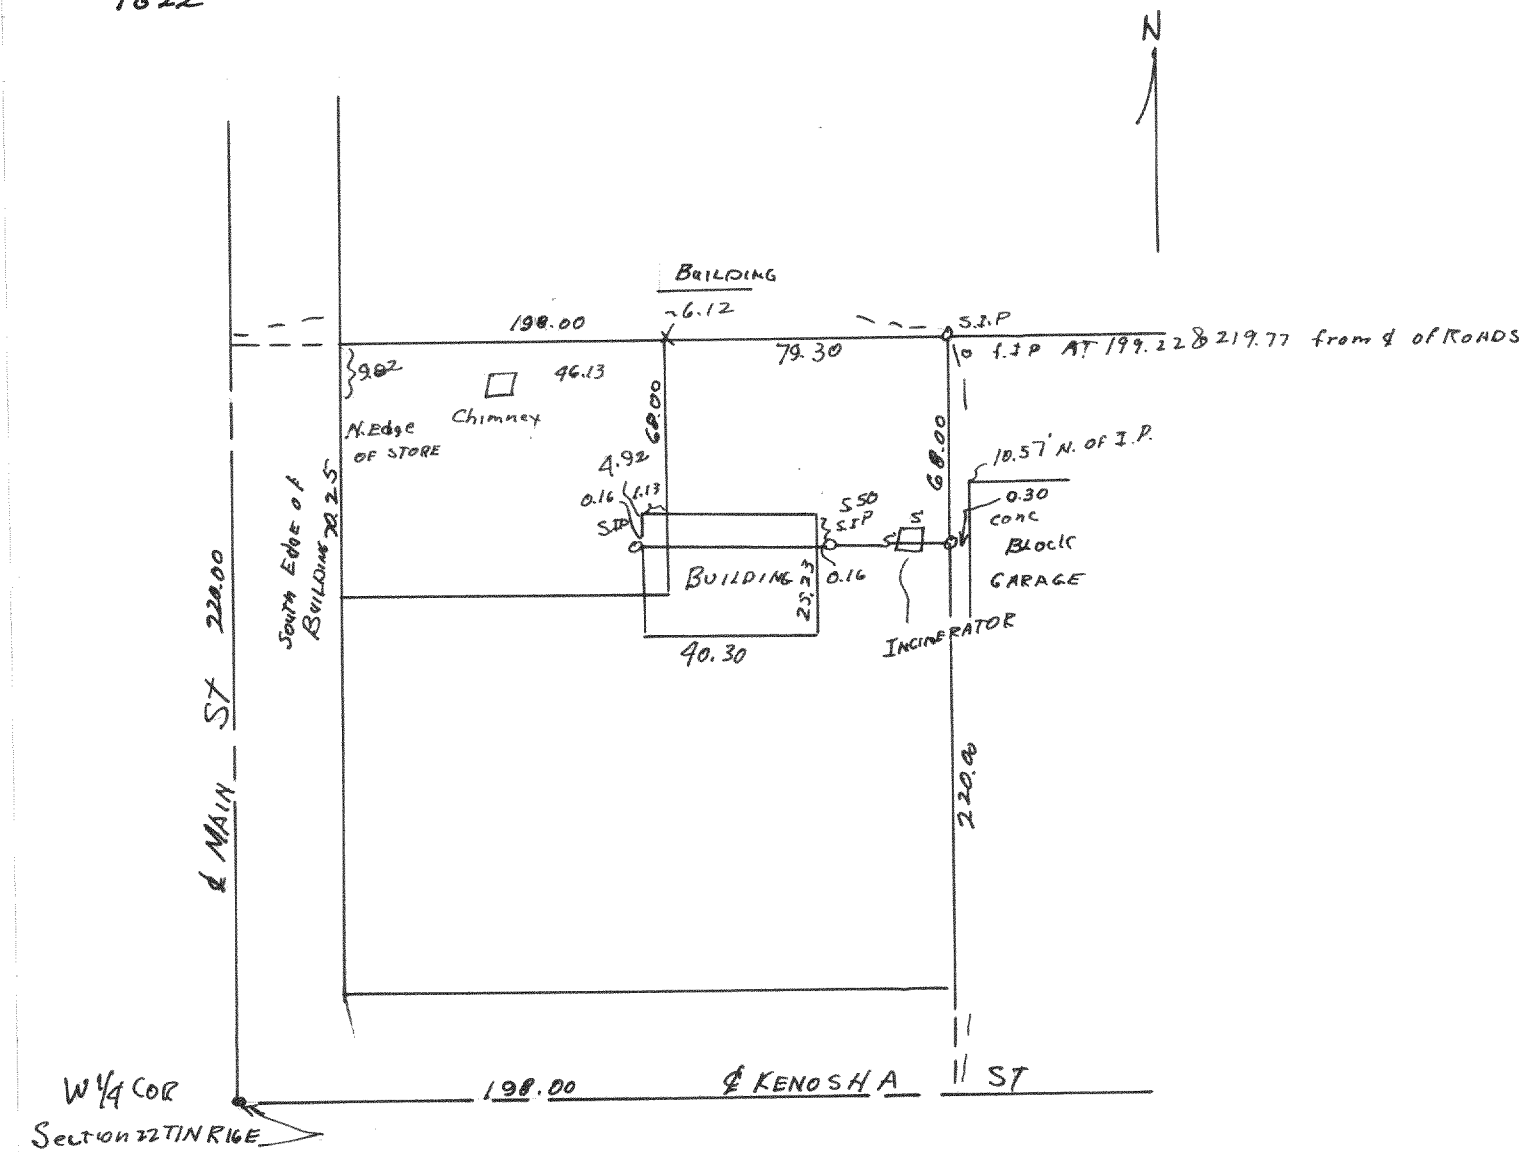

1833

