



1834

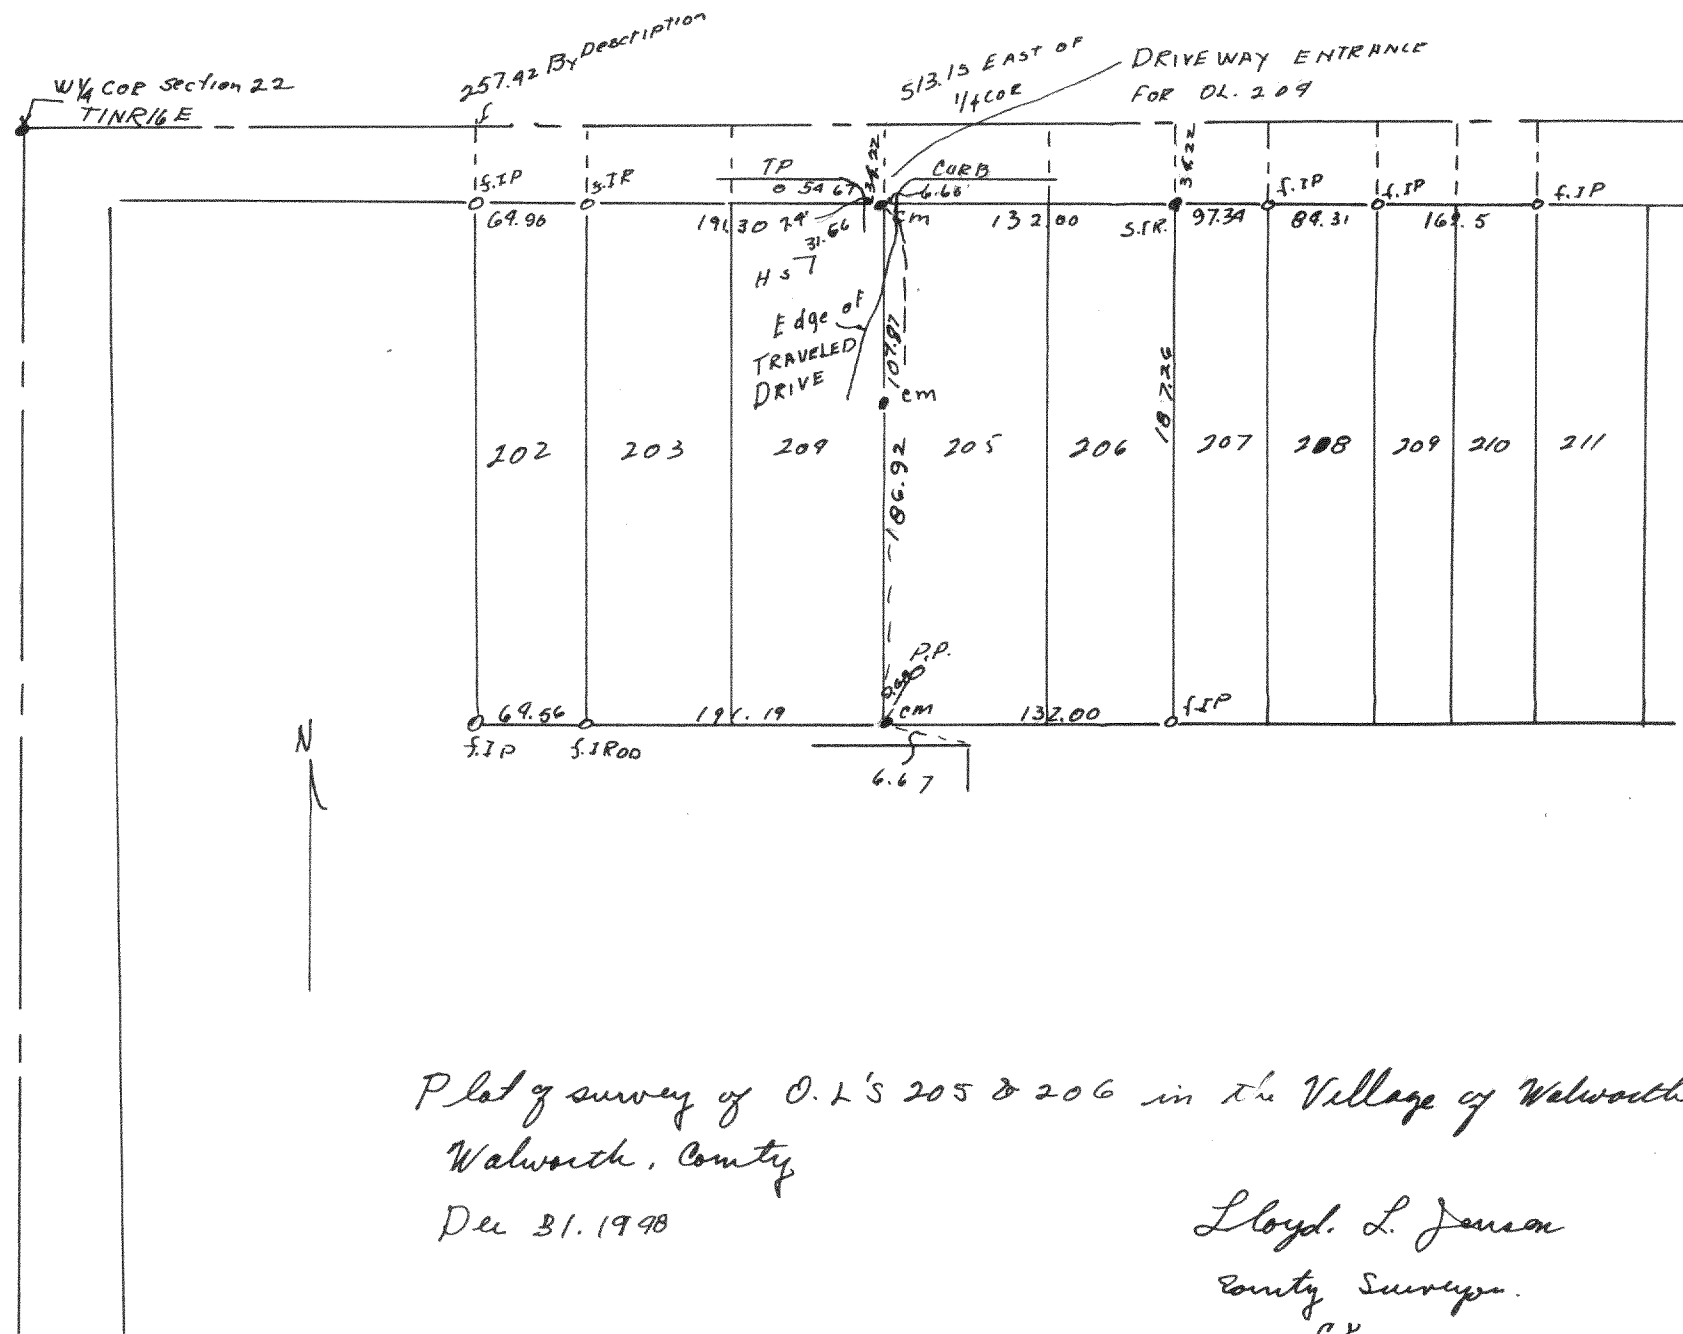

Plot of survey of O.L.'s 205 & 206 in the Village of Walworth
Walworth, County
Dec 31, 1998
Lloyd L. Jensen
County Surveyor.
C.S.

1835

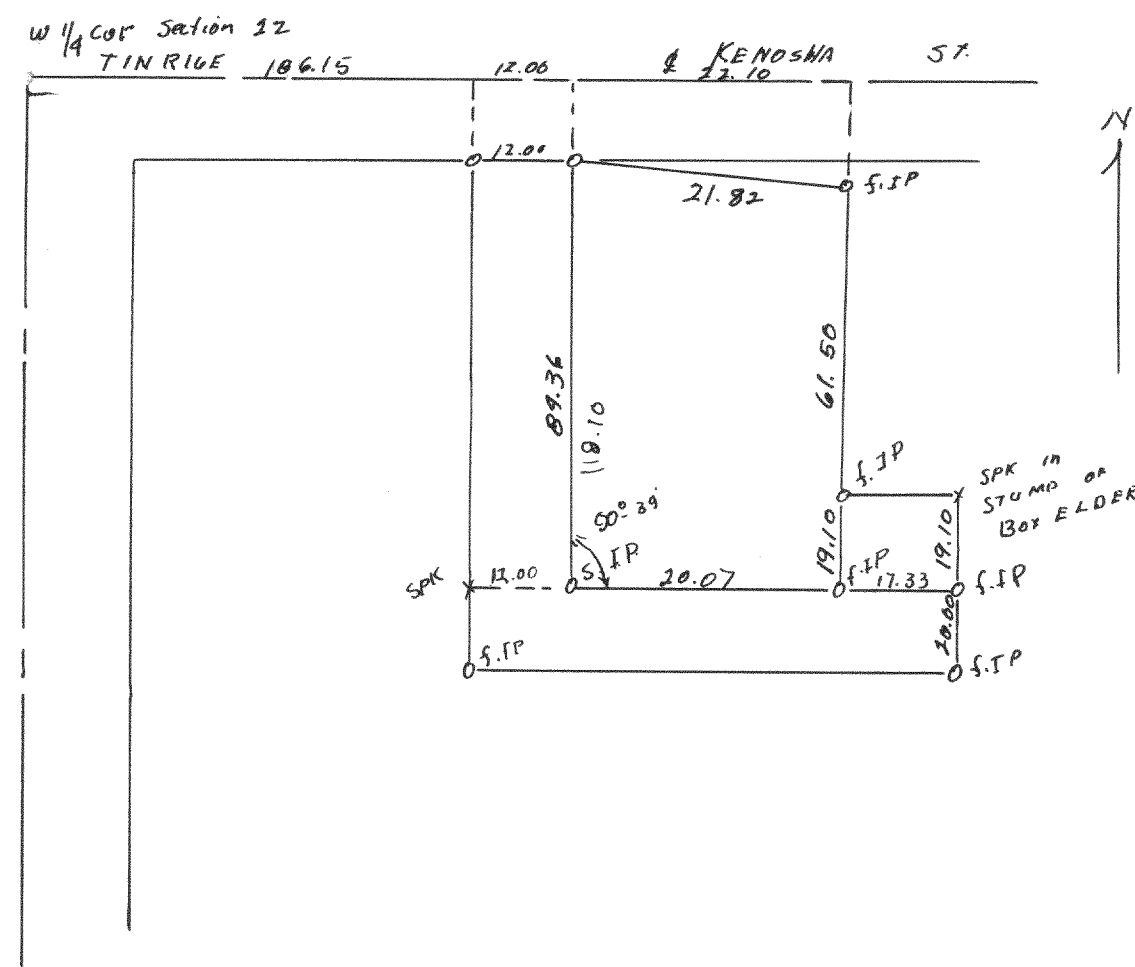

Plot of survey of part of O.L. 201. Village of Walworth
Walworth county
74. 9. 1999
Lloyd L Jensen
County Surveyor.
C.S.