



1838

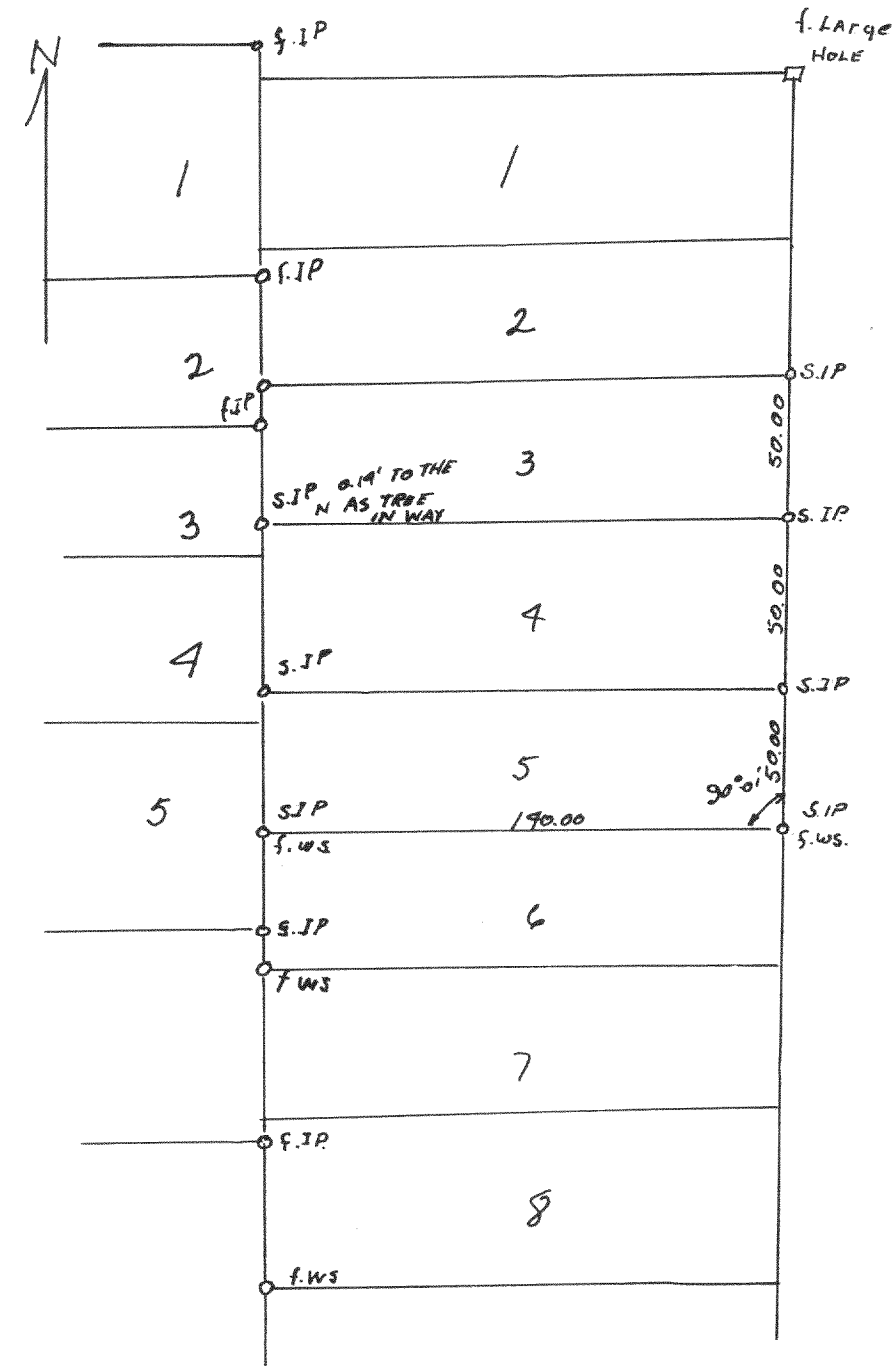

Plat of survey of lots 3, 4, 5 of Block 10 Moravian
 Subdivision on Potter Lake T4N R18E Walworth County
 June 7, 1998 Lloyd L. Jensen
 County Surveyor.
 C.L.

1839

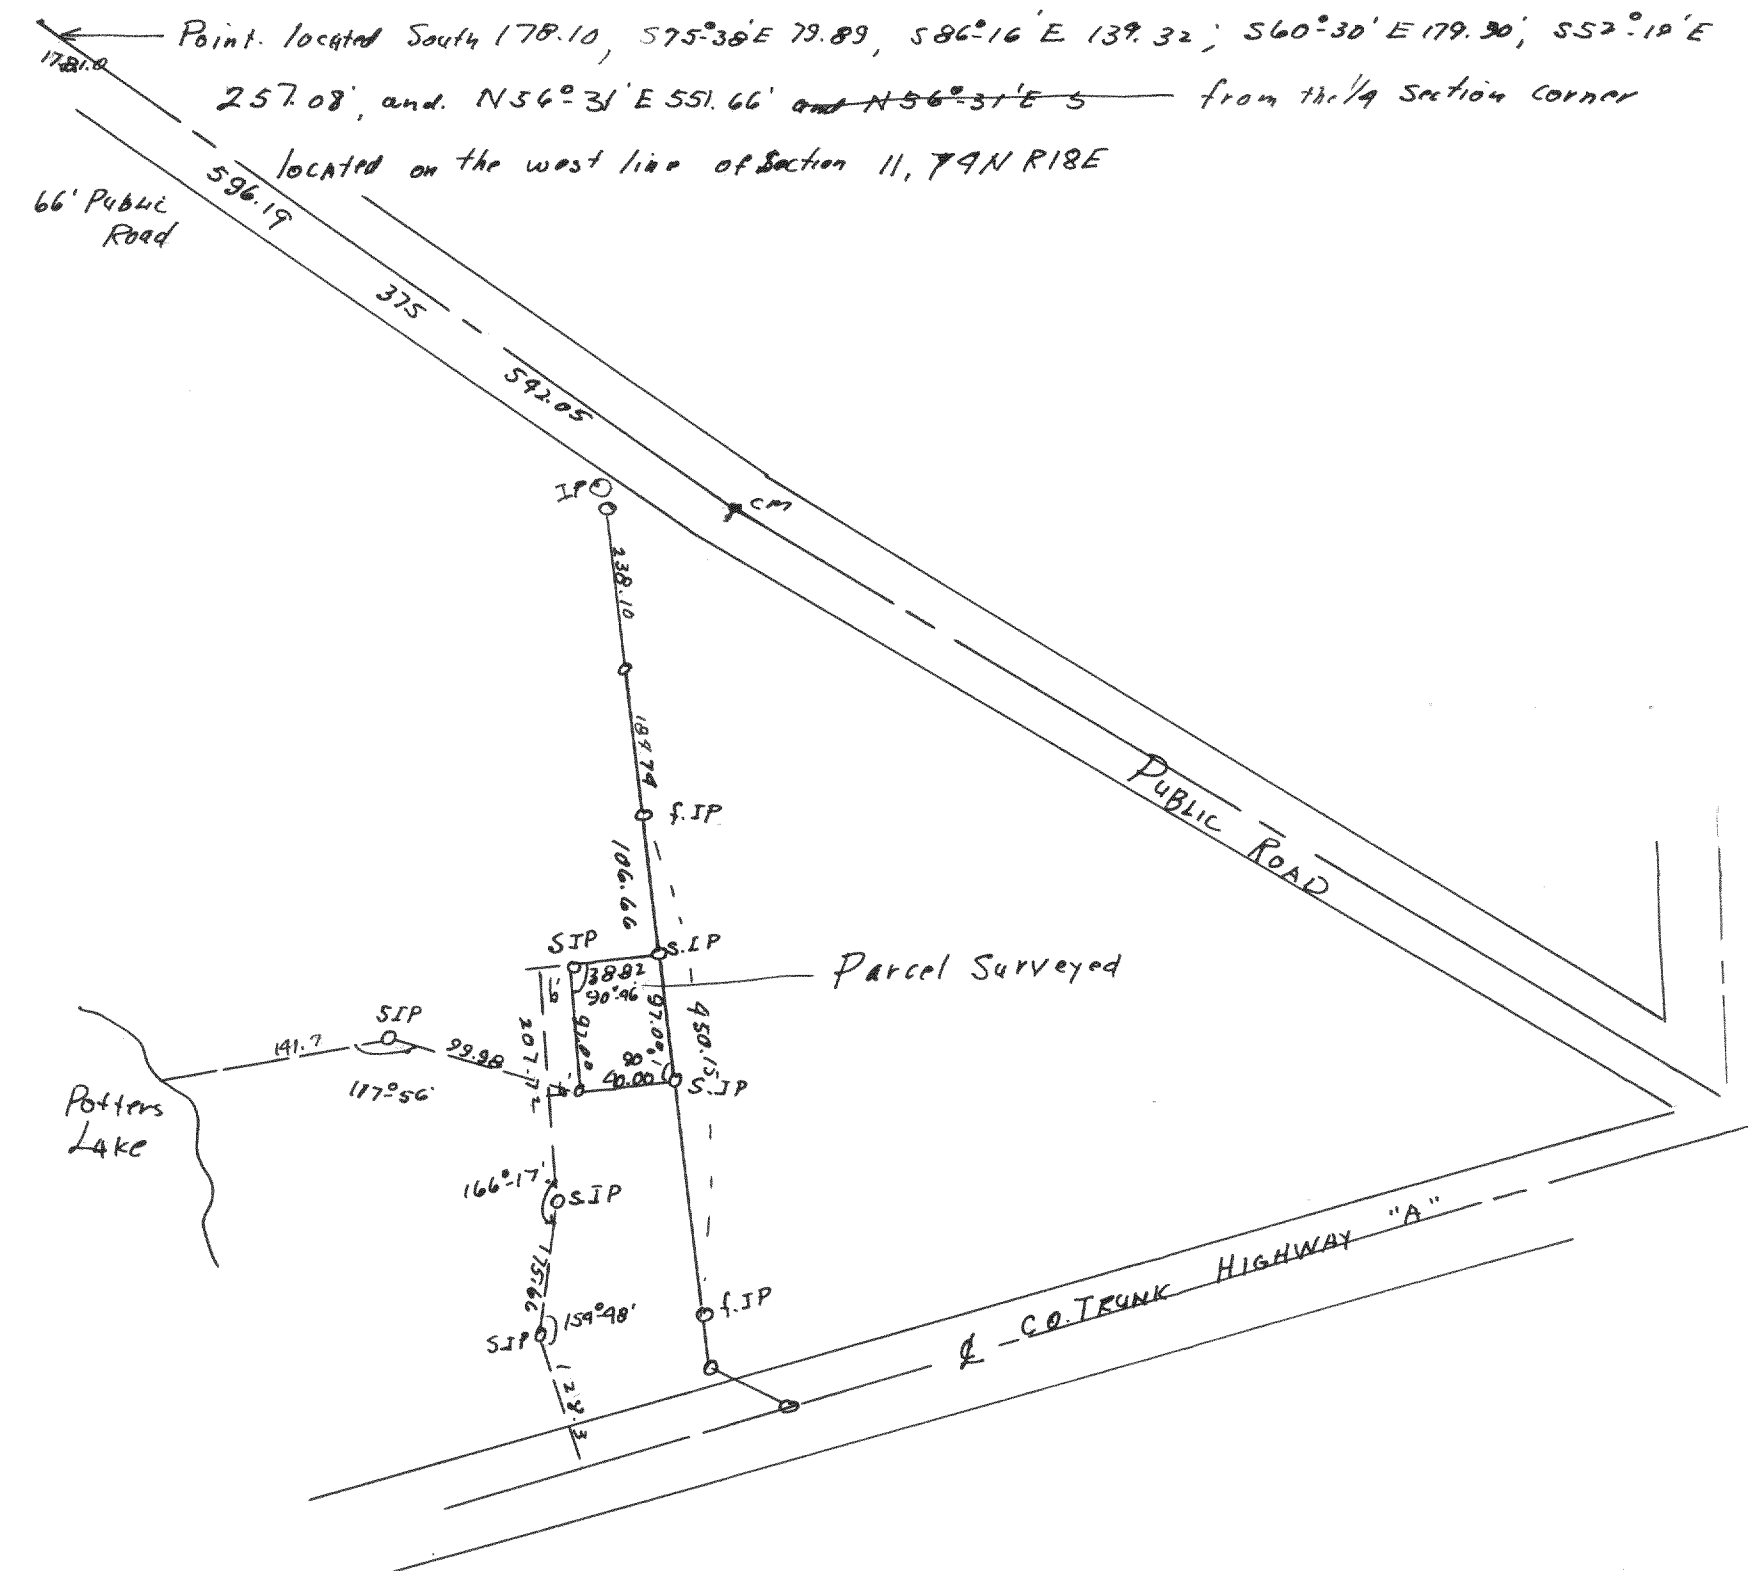

Plat of survey of parcel of land located in the West Fraction 1/2
 of Section 11, T4N R18E, Walworth County
 Dec 8, 1998 Lloyd L. Jensen
 County Surveyor
 C.L.