



1842

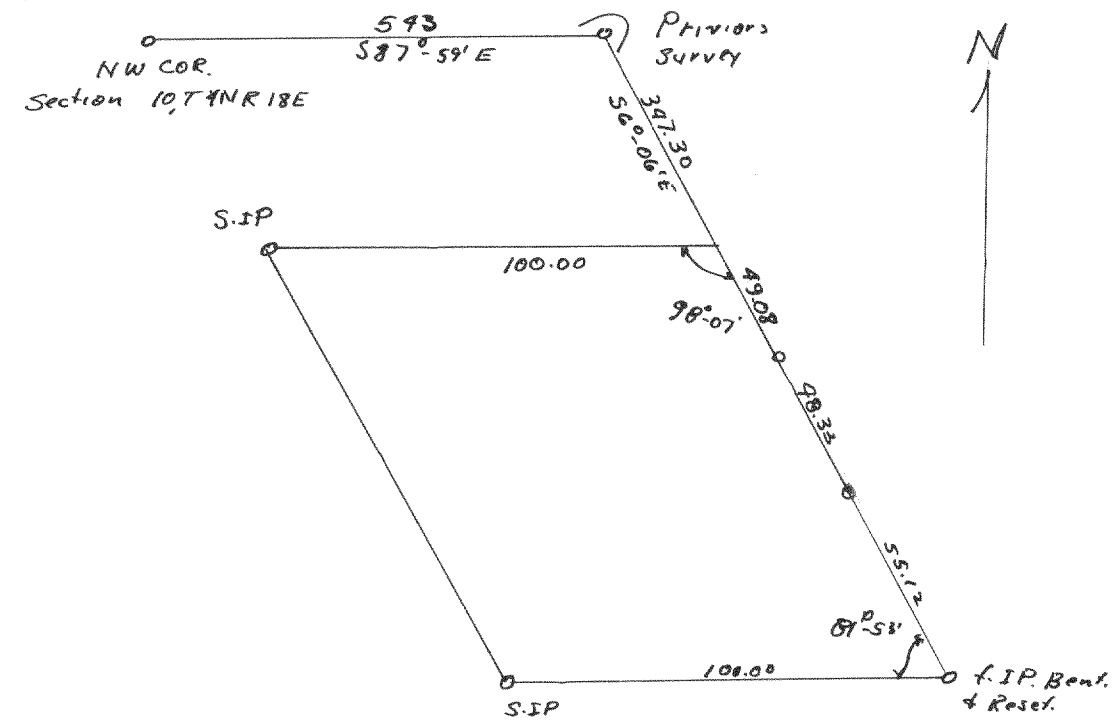


Plot of survey of parcel of land located in the NW 1/4
of Section 10, T4N R18E Walworth County
July 23, 1978
Lloyd L Jensen
County Surveyor.
C.S.

1844

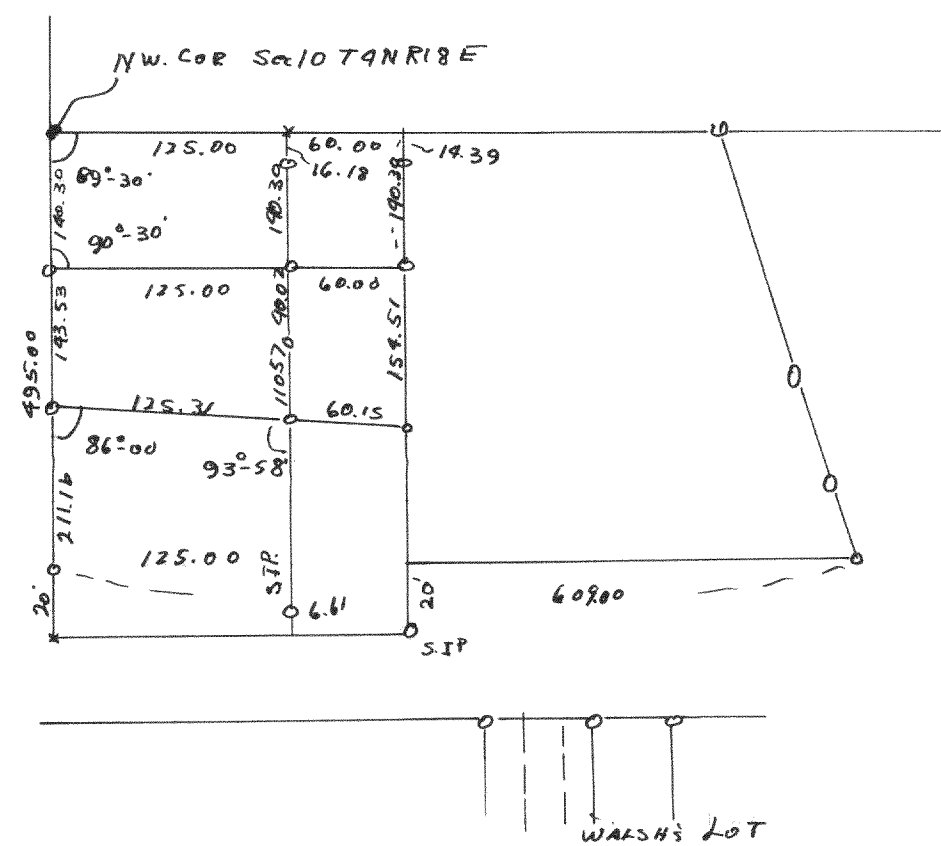


Plot of survey of parcel of land located in the NW
1/4 of Section 10 T4N R18E Walworth County
Aug 1, 1978
Lloyd L Jensen
County Surveyor.
C.S.

1843

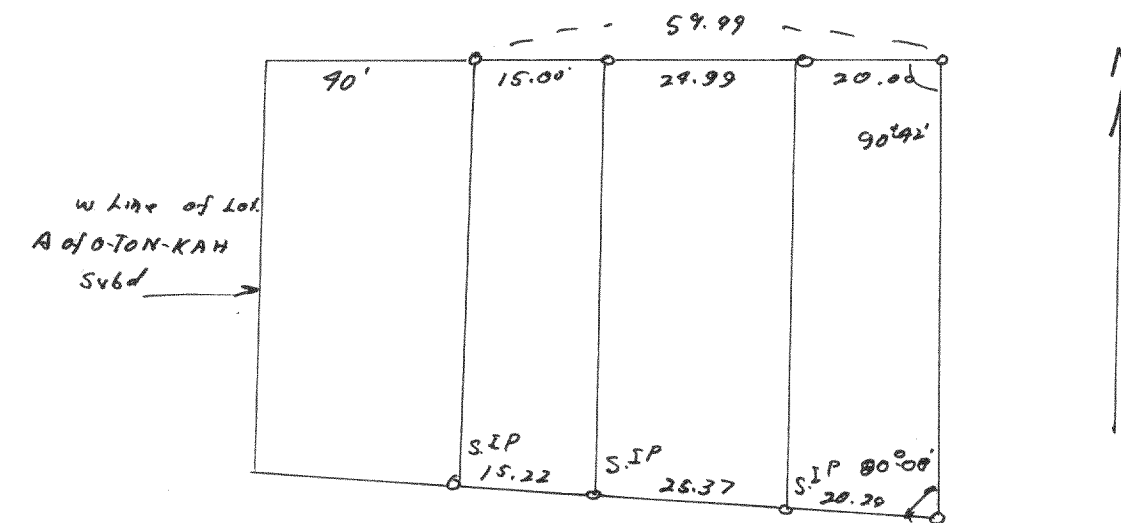

Plot of survey of part of Lot A, O-Ton-Kah Subdivision
located in Section 10, T4N R18E Walworth County.
July 23, 1978
Lloyd L Jensen
County Surveyor.
C.S.

1845

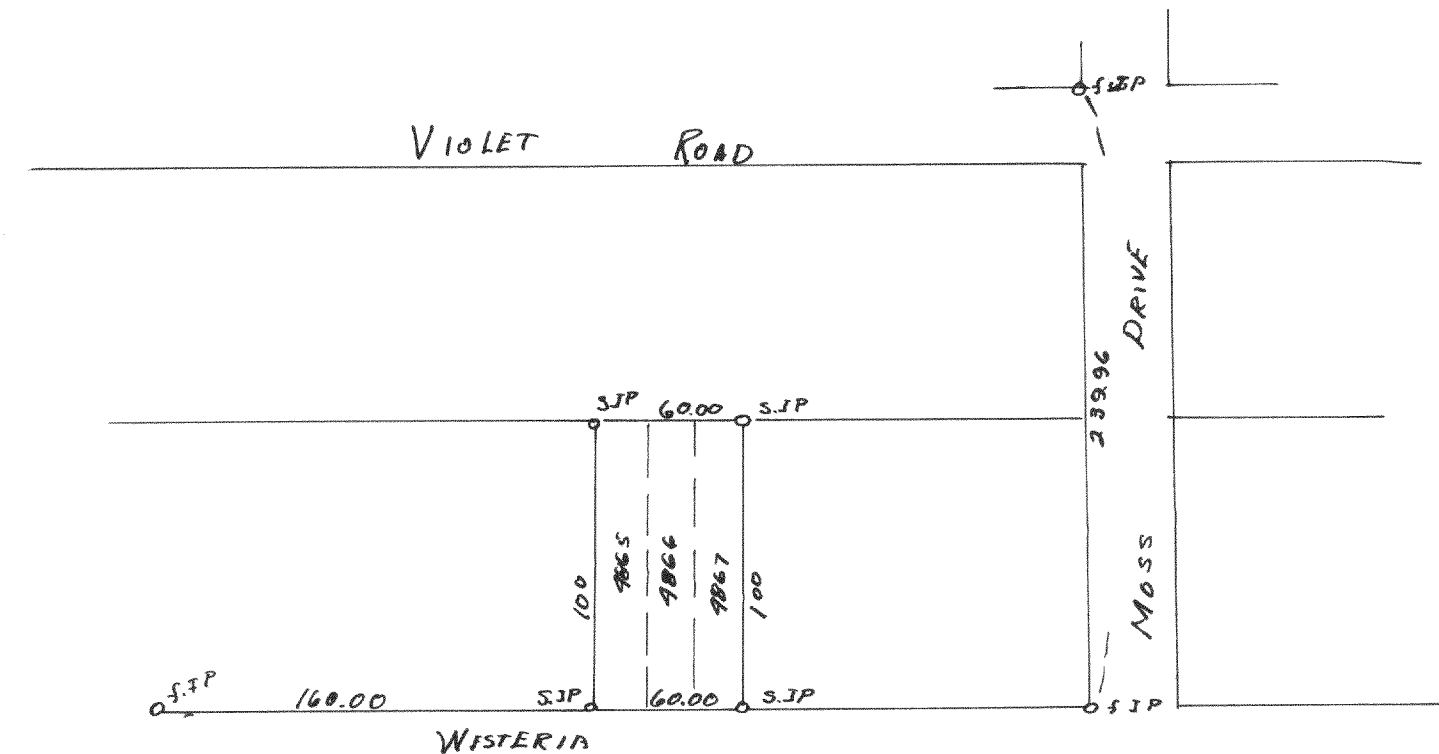

Plot of survey of lots 9865, 9867 Pell Lake Subdivision T4N R18E
Walworth County
May 18, 1978
Lloyd L Jensen
County Surveyor.
C.S.