


N 1850

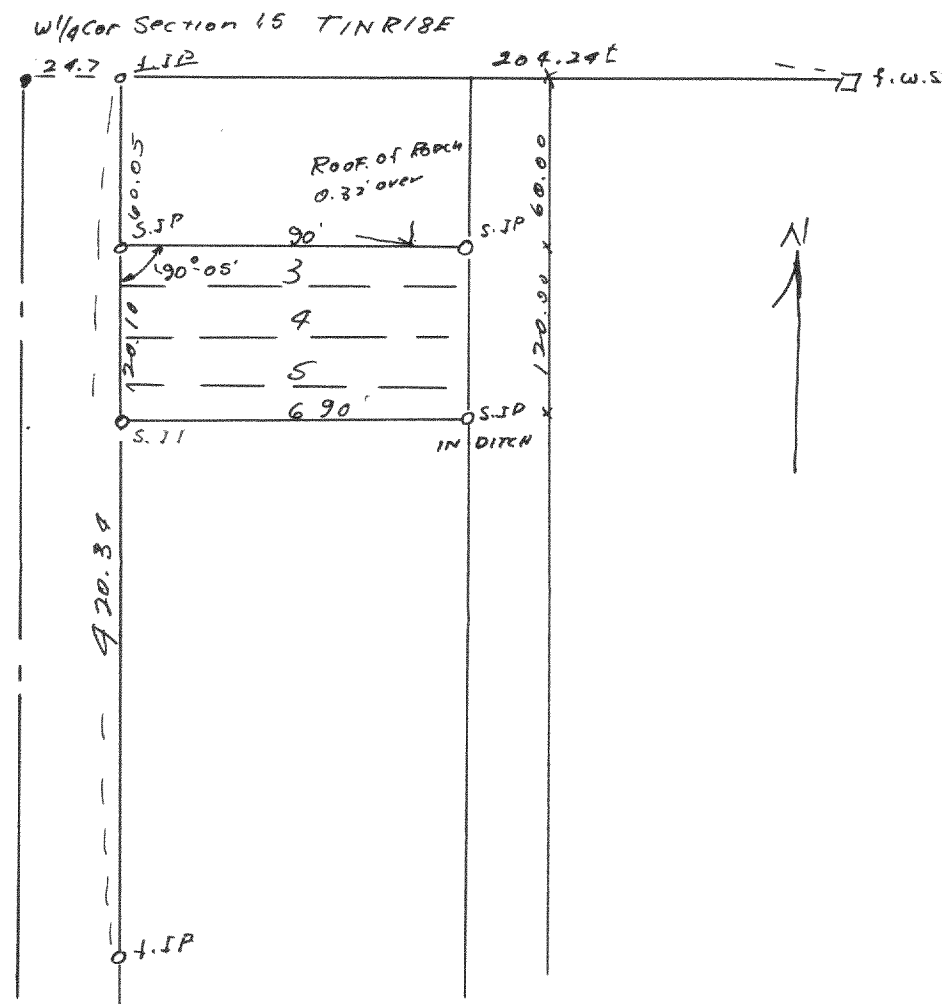


Plat of survey of lots 3-6 of Bettinkes Subdivision
at Pell Lake located in SW 1/4 of Section 15 T1N R18E
Walworth County.

Aug. 25, 1948

Lloyd L. Jensen
County Surveyor
C.S.

N 1851

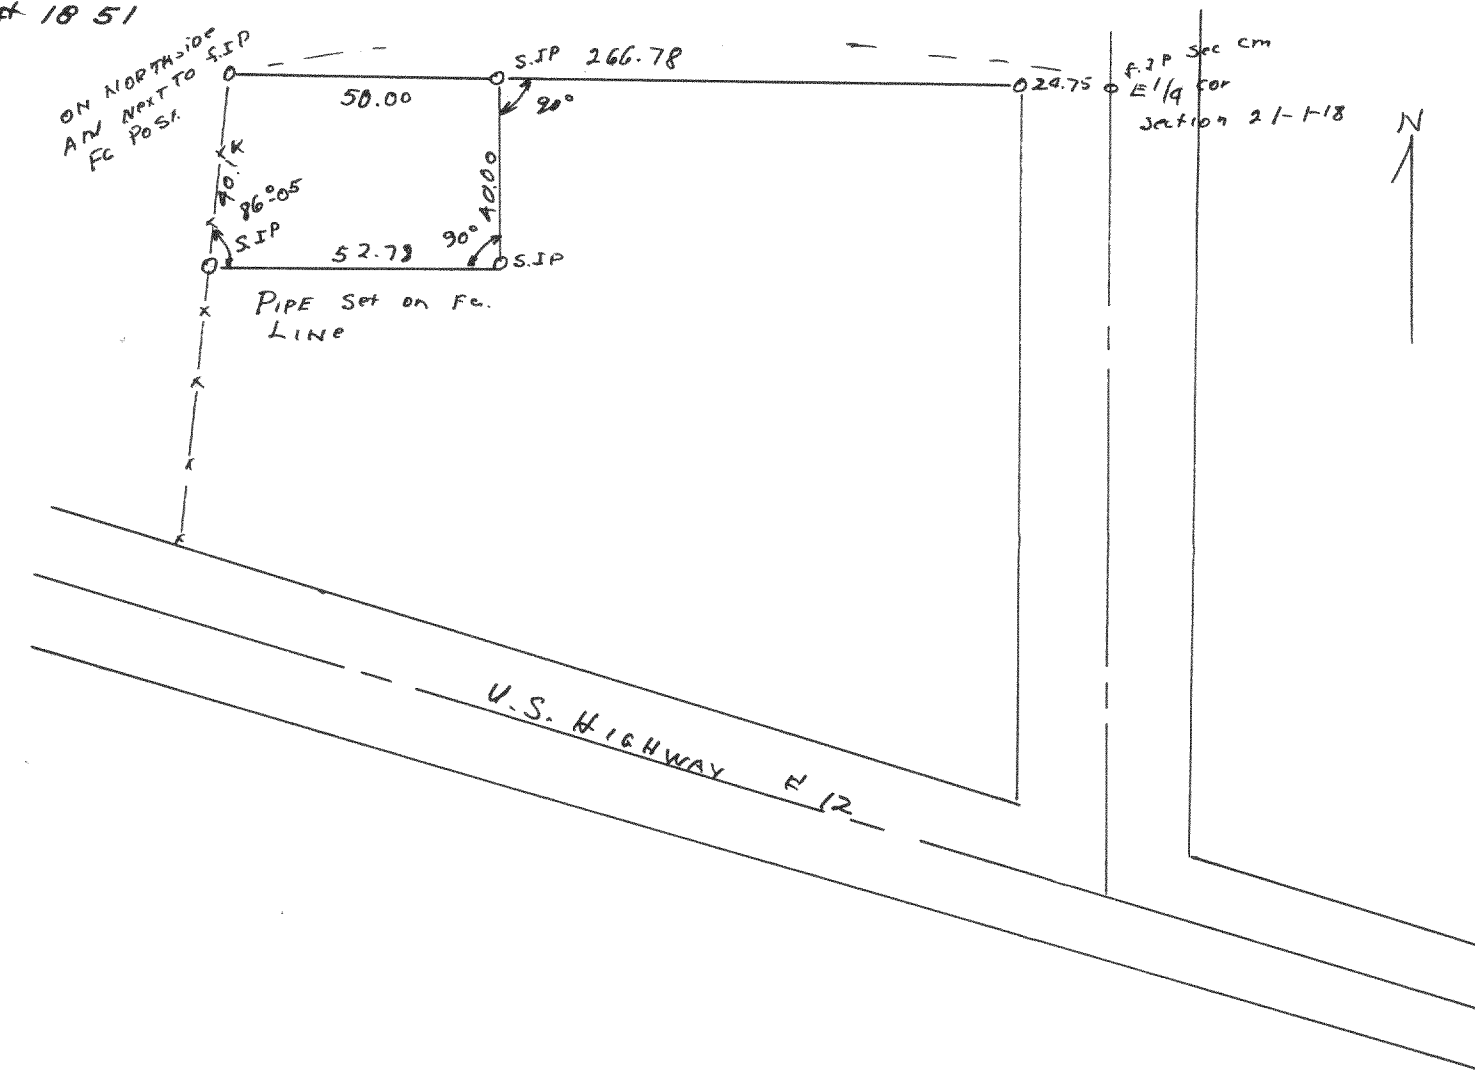

Plat of survey of parcel of land located in the SE 1/4 of Section 21 T1N R18E
Walworth County

Sept. 1948

Lloyd L. Jensen
County Surveyor
C.S.