



1857

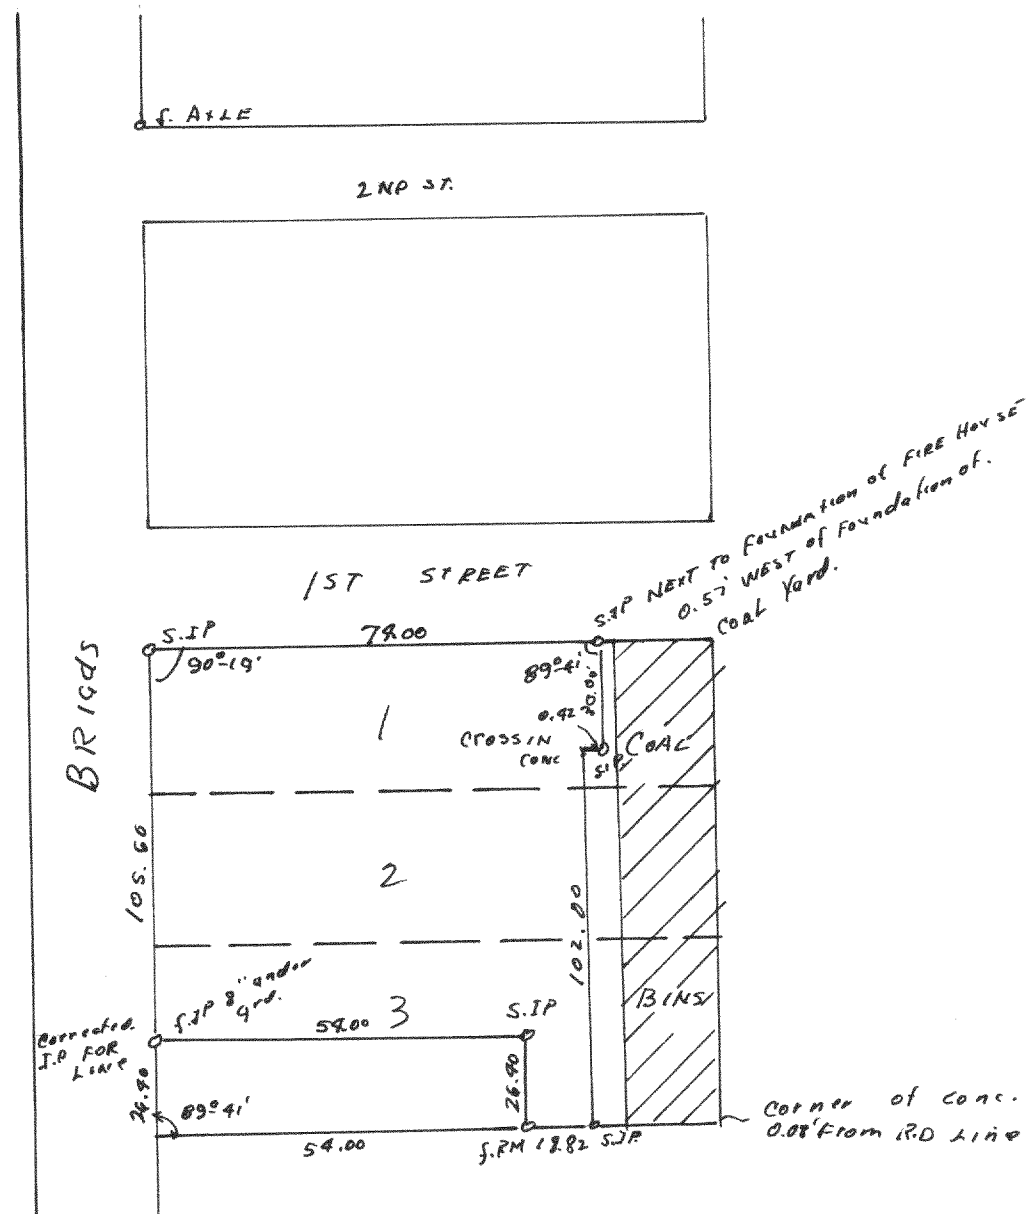

Plot of survey of part of Block 3
of Troy Center Subdivision Section 15 T 4 N R 17 E
Walworth County.
May 17, 1948

Lloyd L. Jensen
County Surveyor.
et

1858

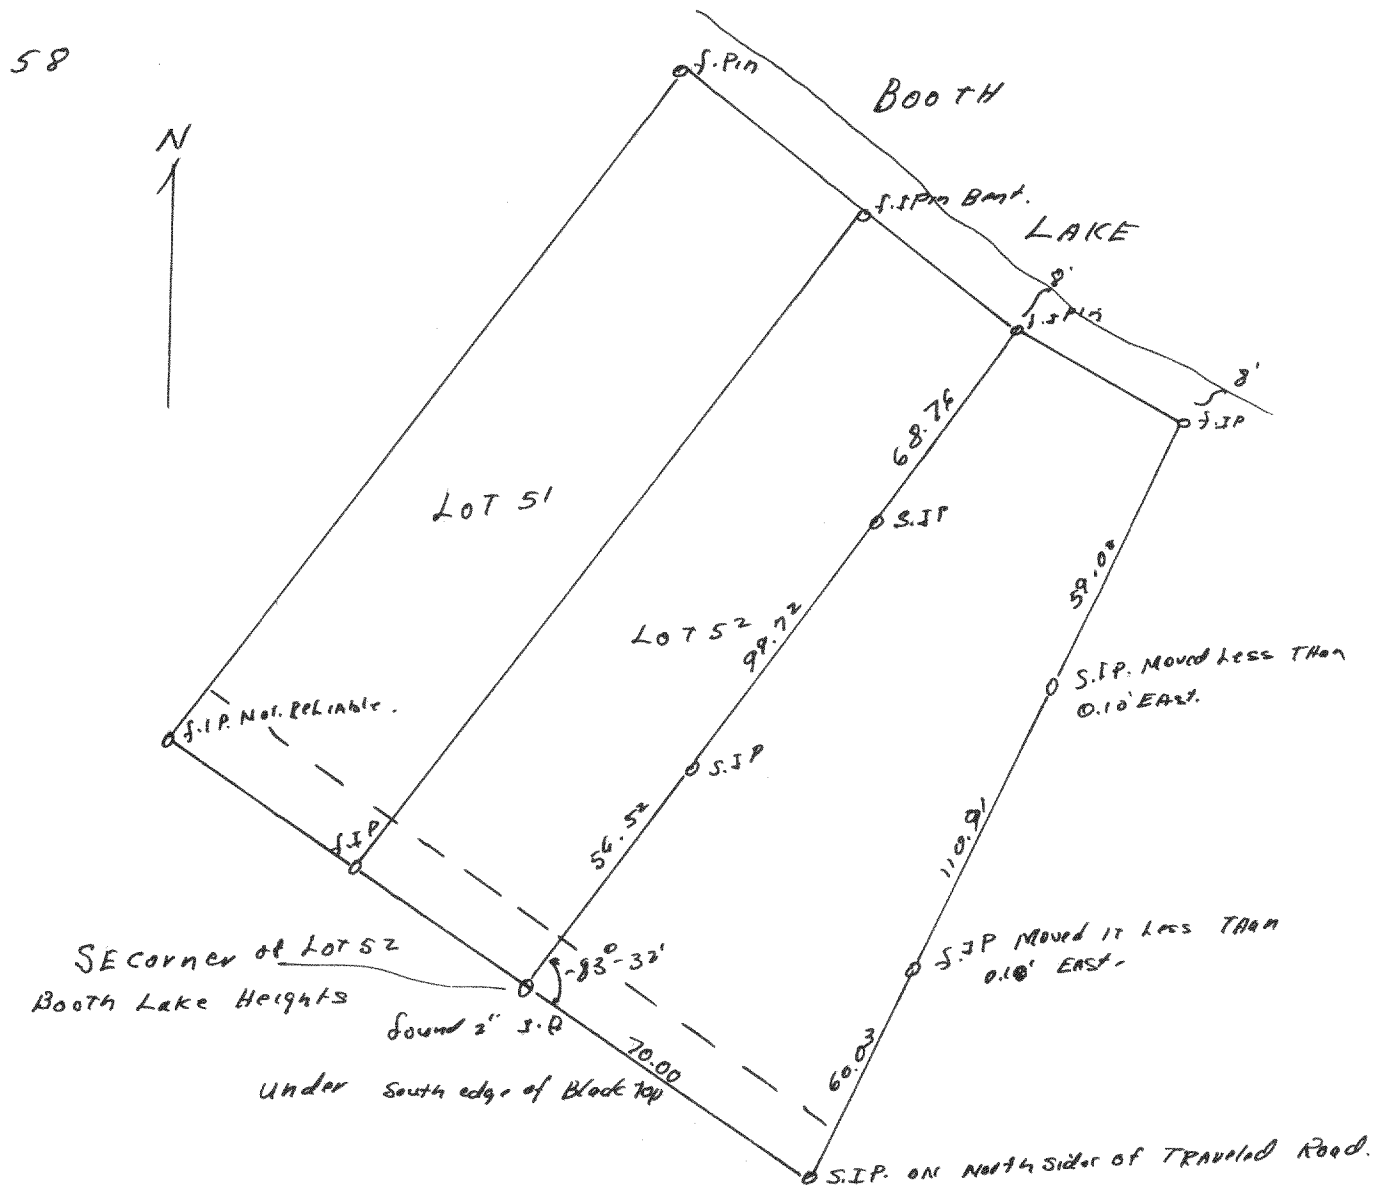

Plot of survey of parcel of land joining and to the east of lot 52
of Booth Lake Highw. Located in NE 1/4 of Section 29, T4 N R17 E Walworth County
June 3, 1948
Lloyd L. Jensen
County Surveyor.
C.L.