



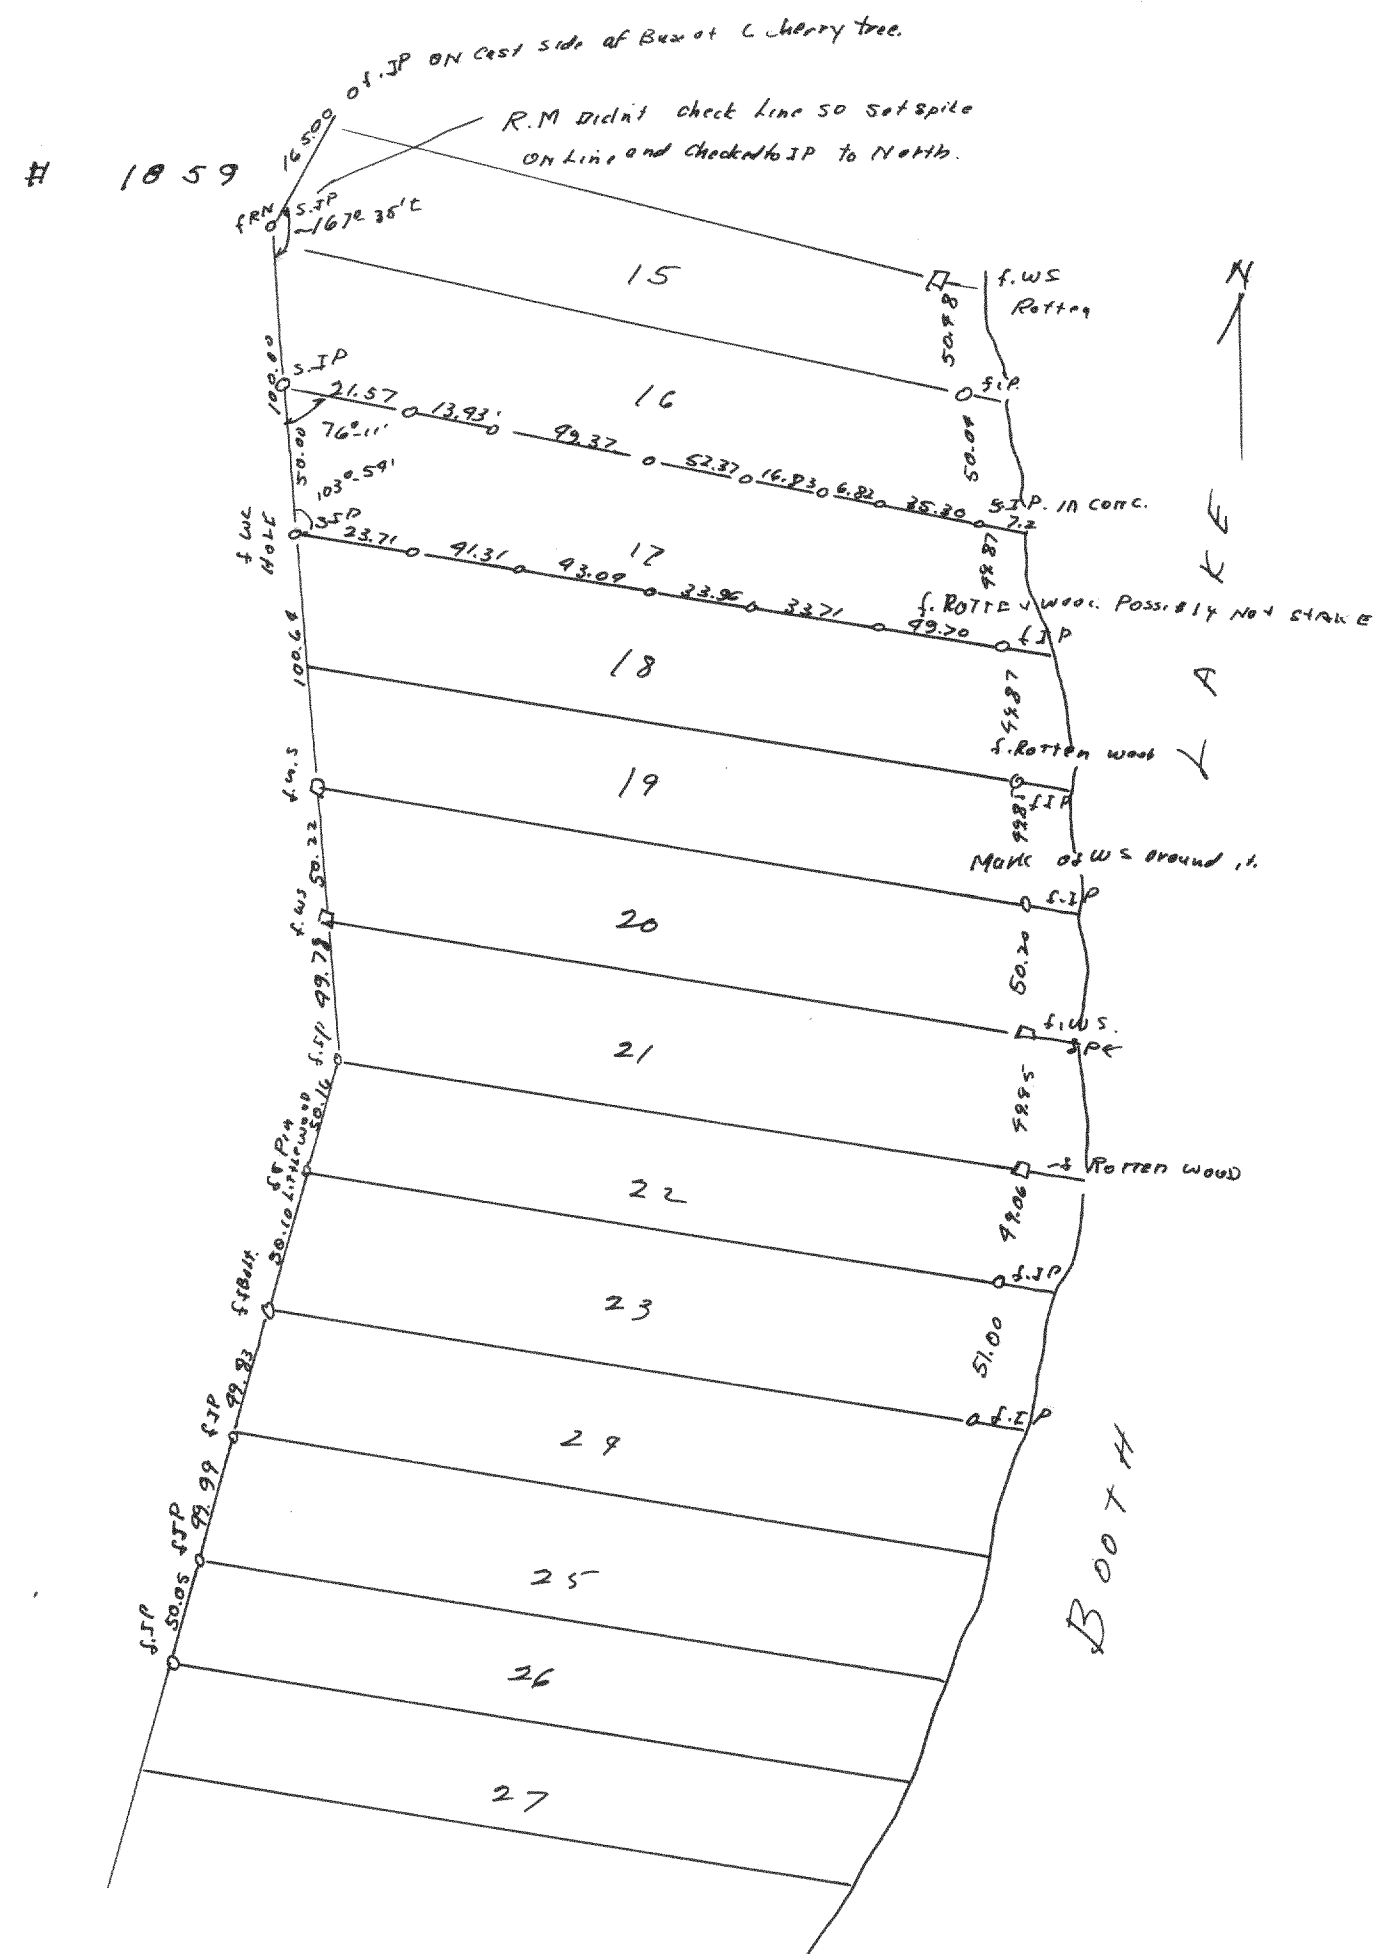

# 1860

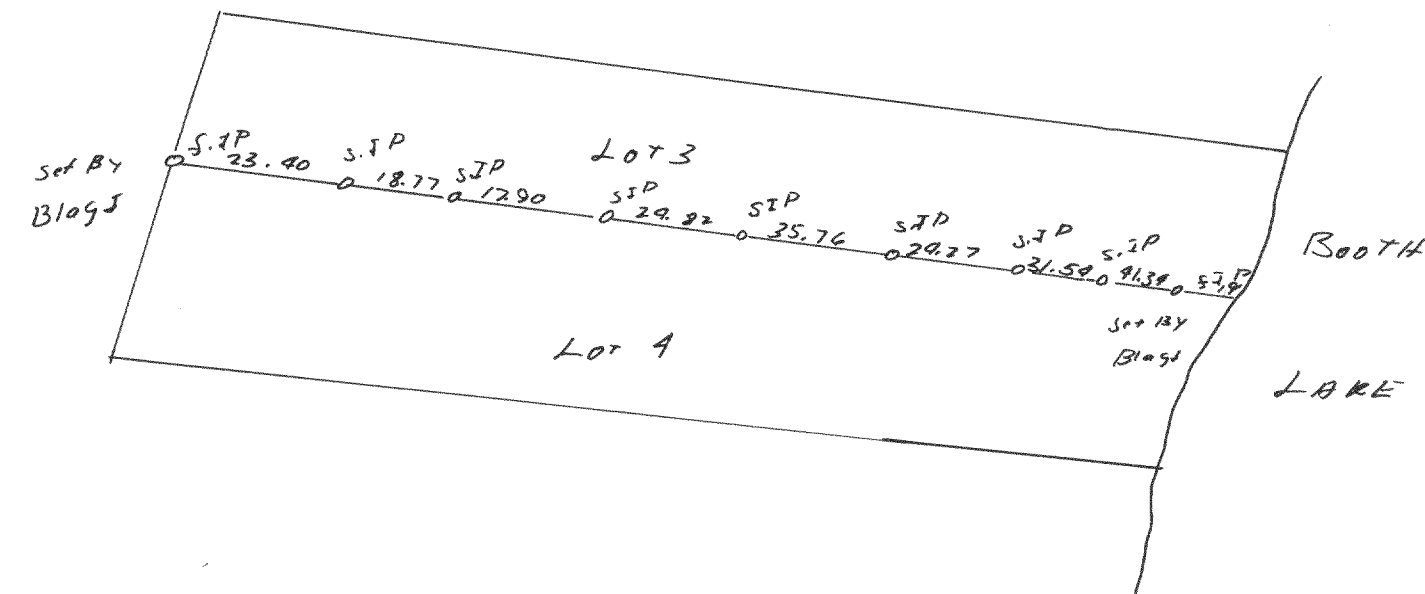

Plat of line of pipe set between Lots 3 & 4 of Booth Lake Heights  
Subdivision located in Section <sup>24</sup> ~~12~~ T4N R17E Walworth County  
July 27, 1998  
Lloyd L Jensen  
County Surveyor  
et.

Plat of survey of lot 17, Booth Lake Heights Subdivision  
located in Section <sup>24</sup> ~~12~~ T4N R17E Walworth County  
July 19, 1998  
Lloyd L Jensen  
County Surveyor  
et.