


#1861

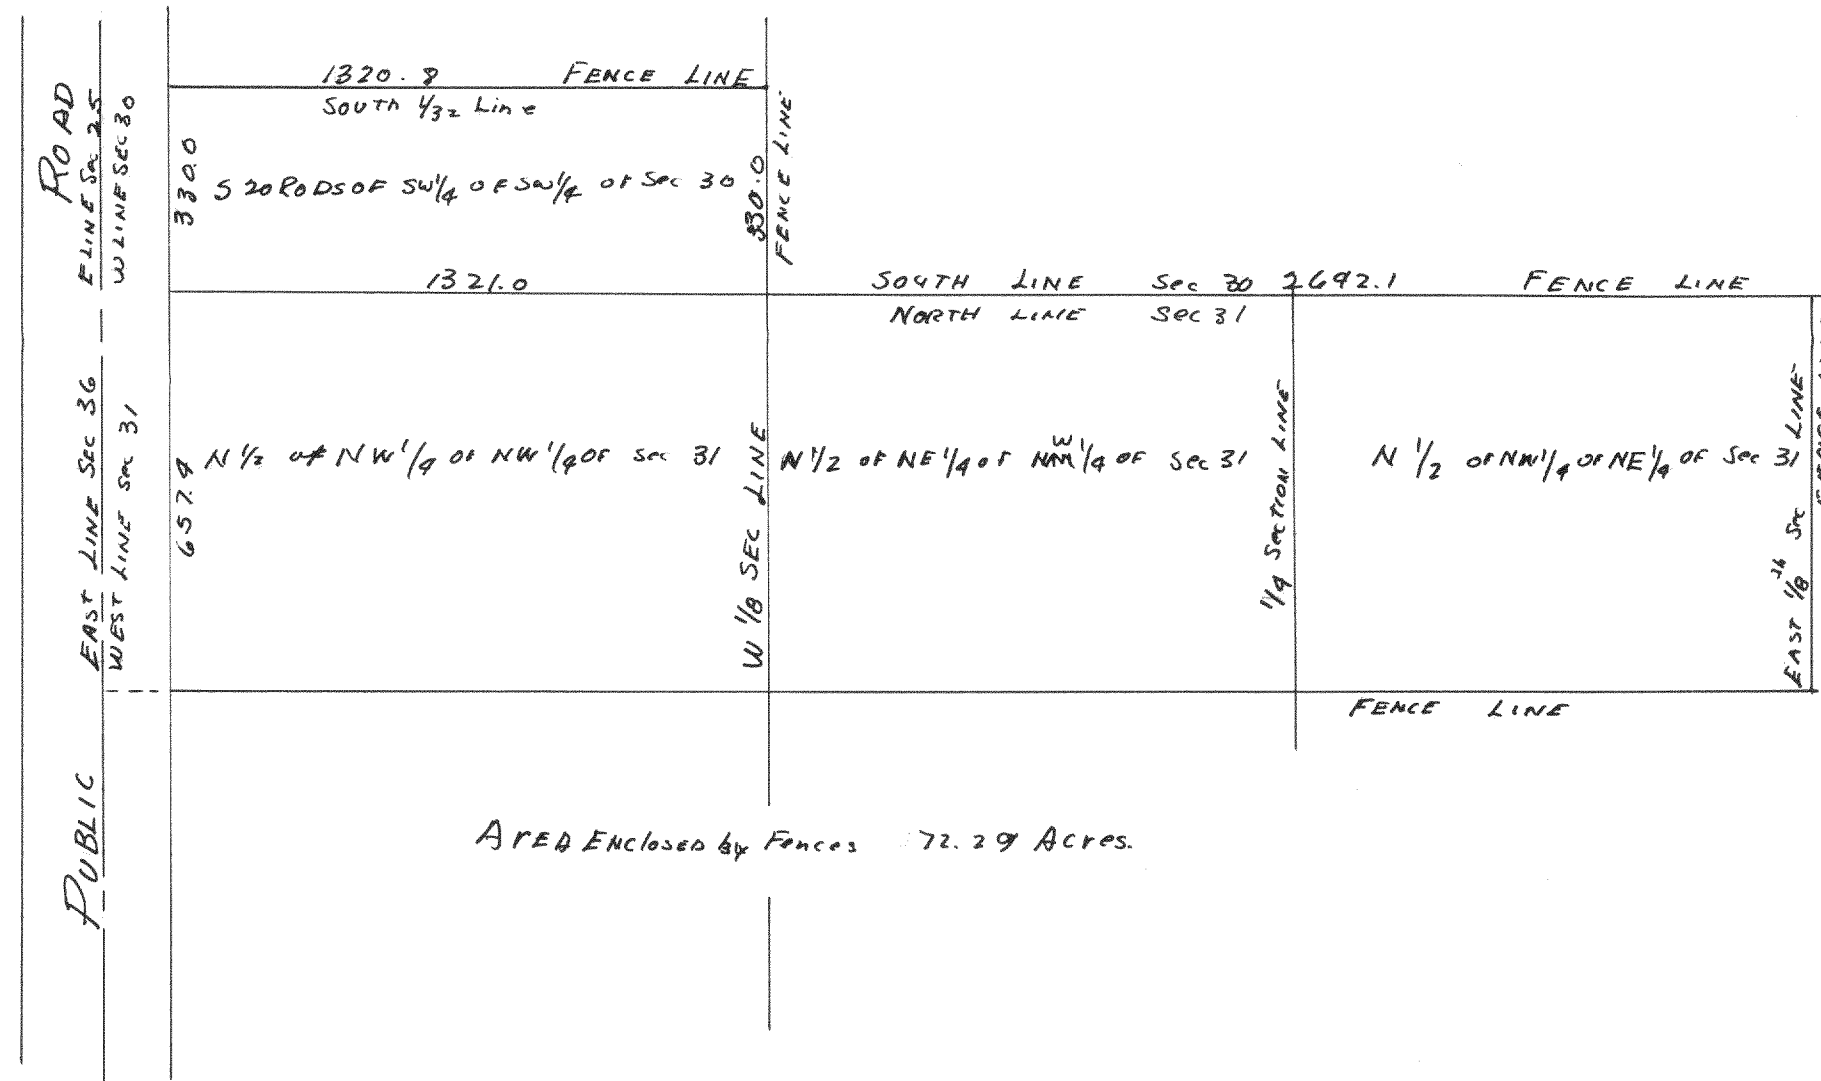


Plot of Survey of the present fence lines marking the property
known as the Zimma Farm located on Section 30 + 31 of T4NR17E
Walworth County

April 1, 1948

Lloyd L. Jensen
County Surveyor
C.L.

#1862

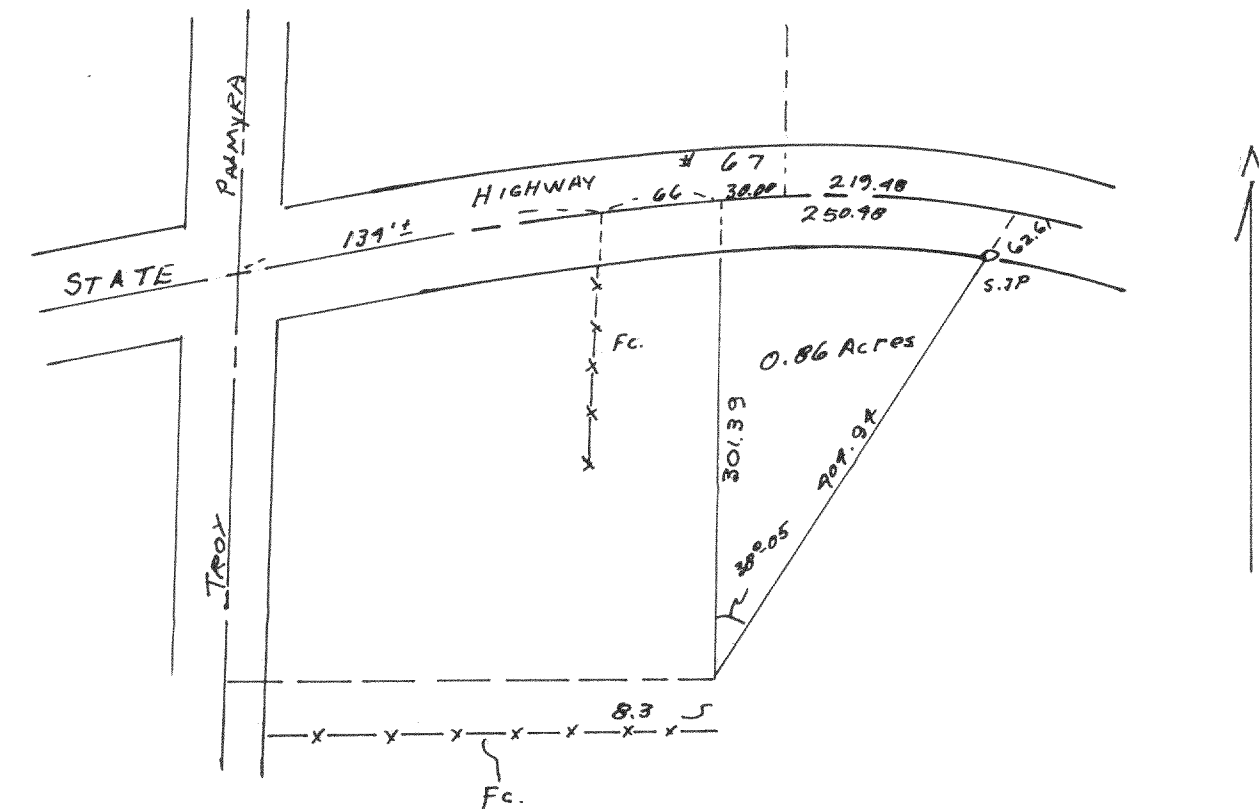

Plot of survey of a parcel of land located in the Northwest $\frac{1}{4}$
of Section 6, T4NR17E Walworth County,
Sept 16, 1948

Lloyd L. Jensen
County Surveyor
C.L.