



#1865

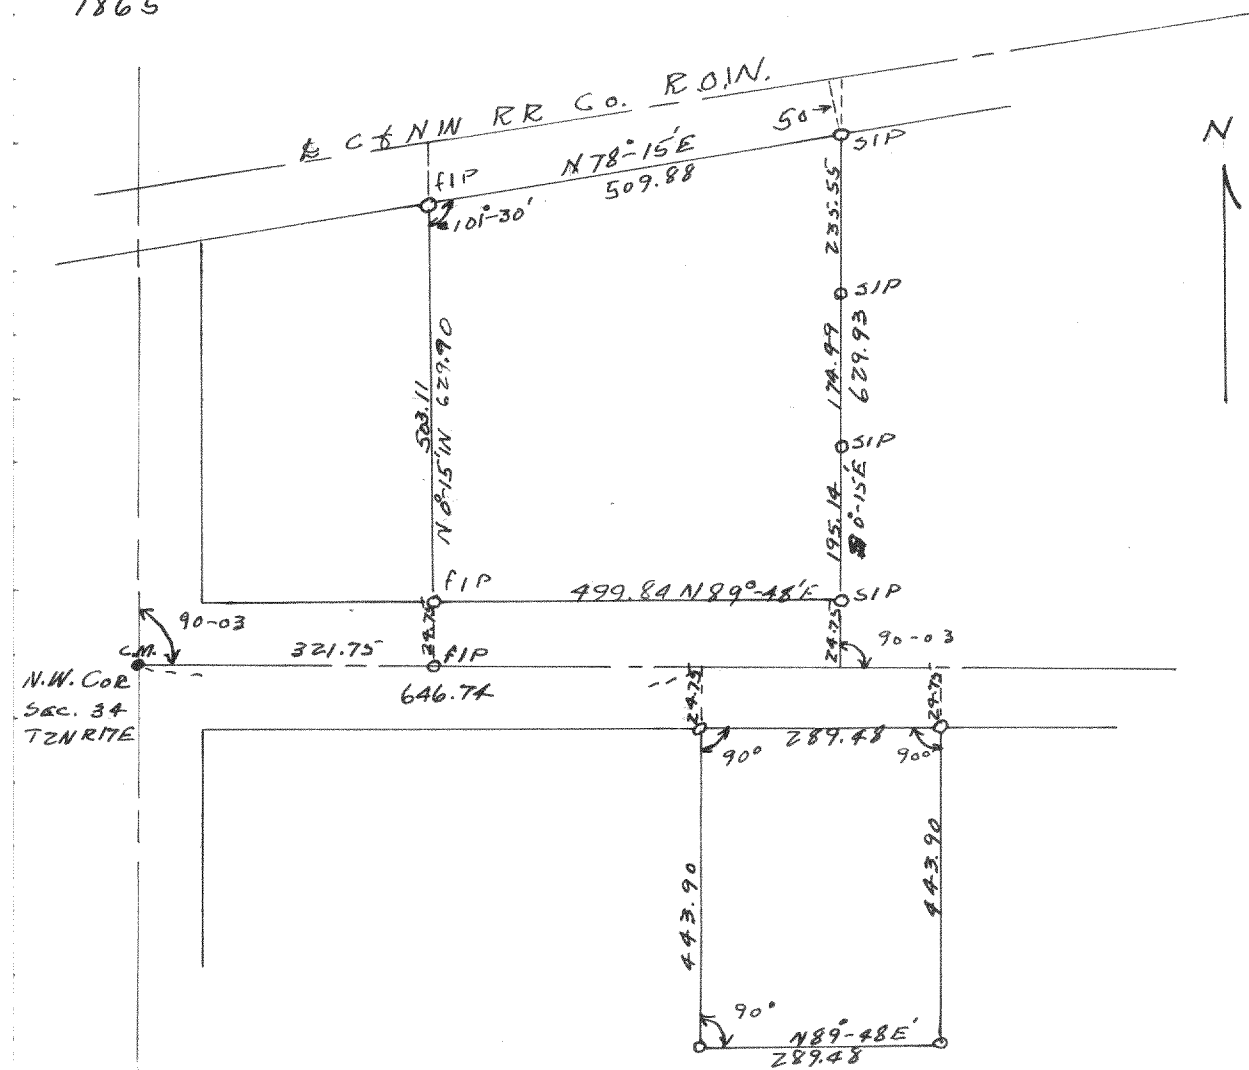

Plot of survey of a parcel of land located in the SW 1/4 of Section 27
and another parcel in NW 1/4 of Section 34 all in T2N R17E Walworth County
1948

Lloyd L. Jensen
Clerk

#1866

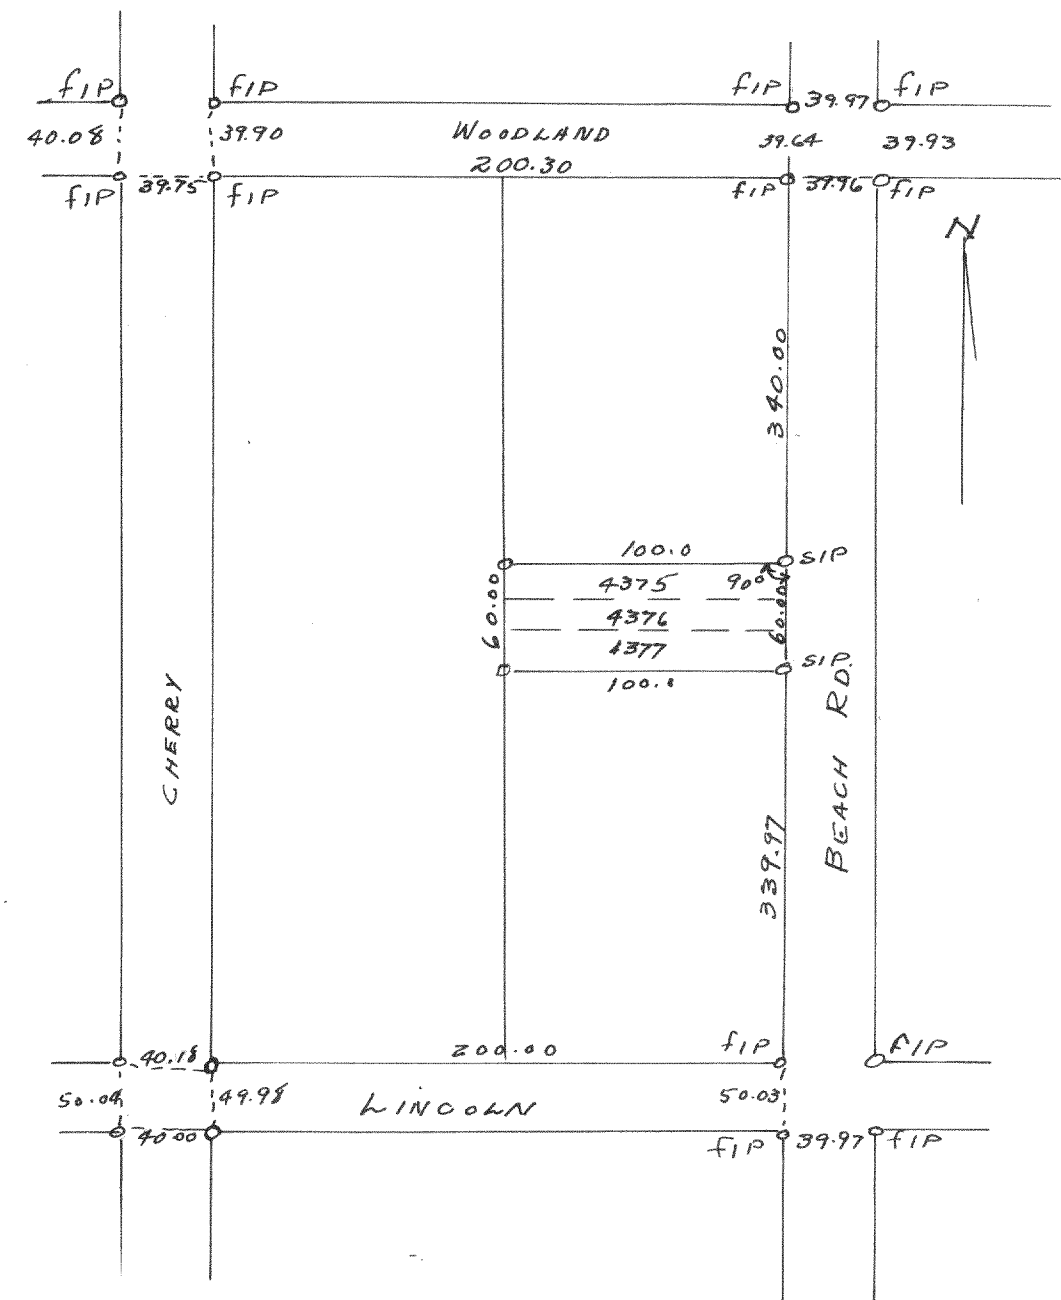

Plot of survey of lots 4375-4377 Lake Como Beach Subdivision
in Sections 21 & 22 T2N R17E Walworth County
July 8, 1948

Lloyd L. Jensen
Clerk