



1867

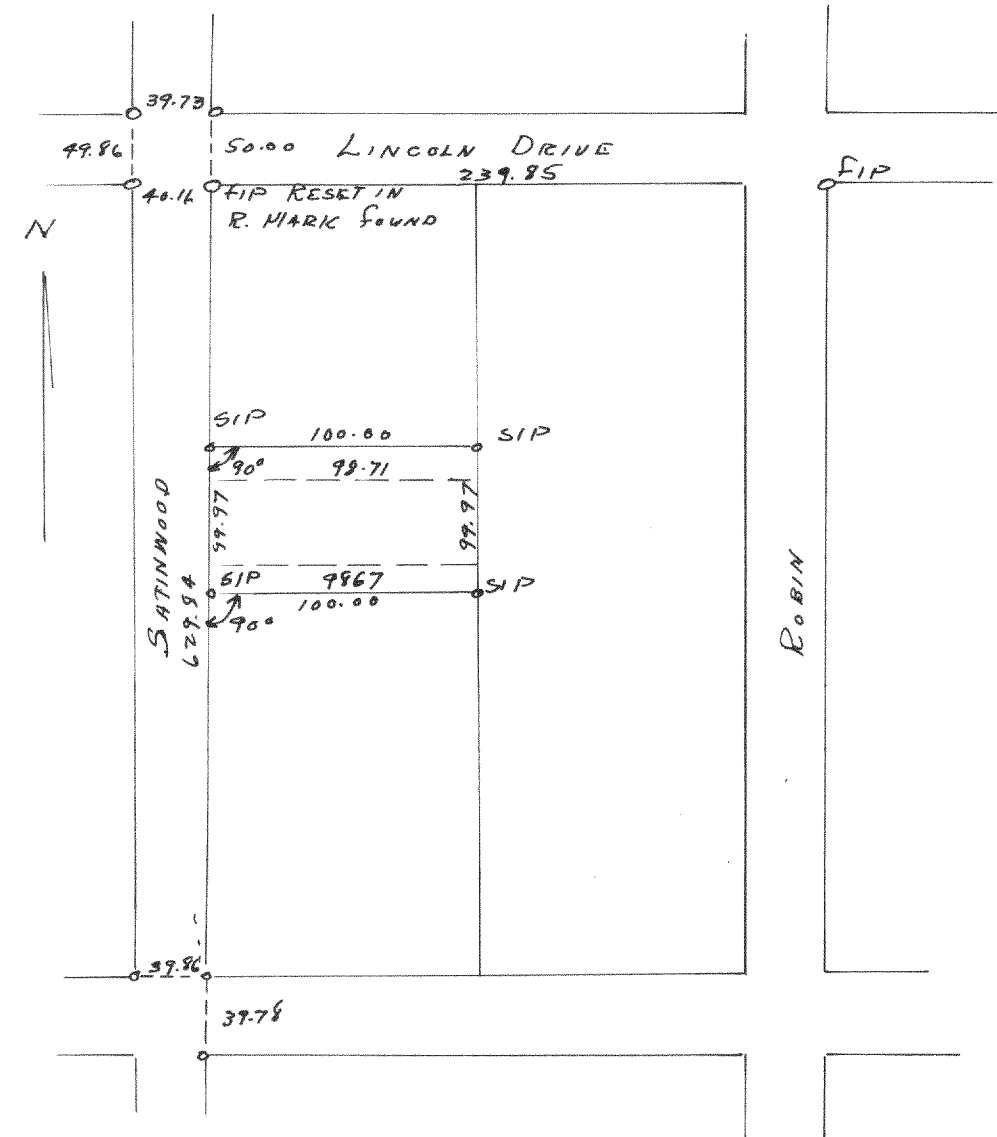

Plat of survey of lots 9867-9871 Lake Como Beach subdivision
located in section 21 & 22 T2N R17E Walworth County.
July 17, 1948
Lloyd L. Jensen
Cust.

1868

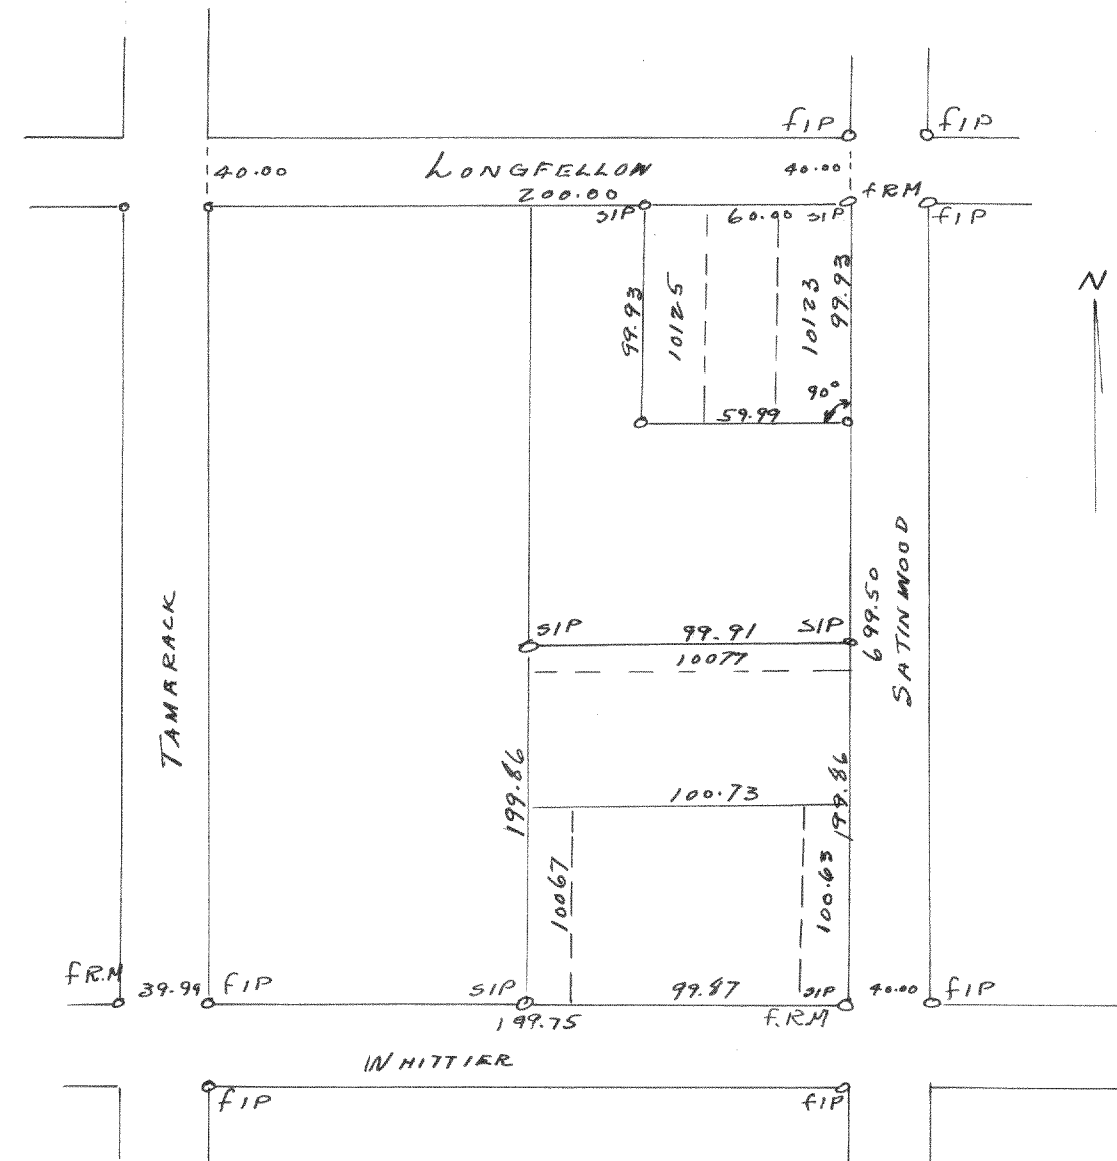

Plat of survey of lots 10063-10067, 10073-10077 & 10123-10125 in
Lake Como Beach subdivision in section 21 & 22, T2N R17E Walworth County.
Aug 17, 1948
Lloyd L. Jensen
Cust.