



#1869

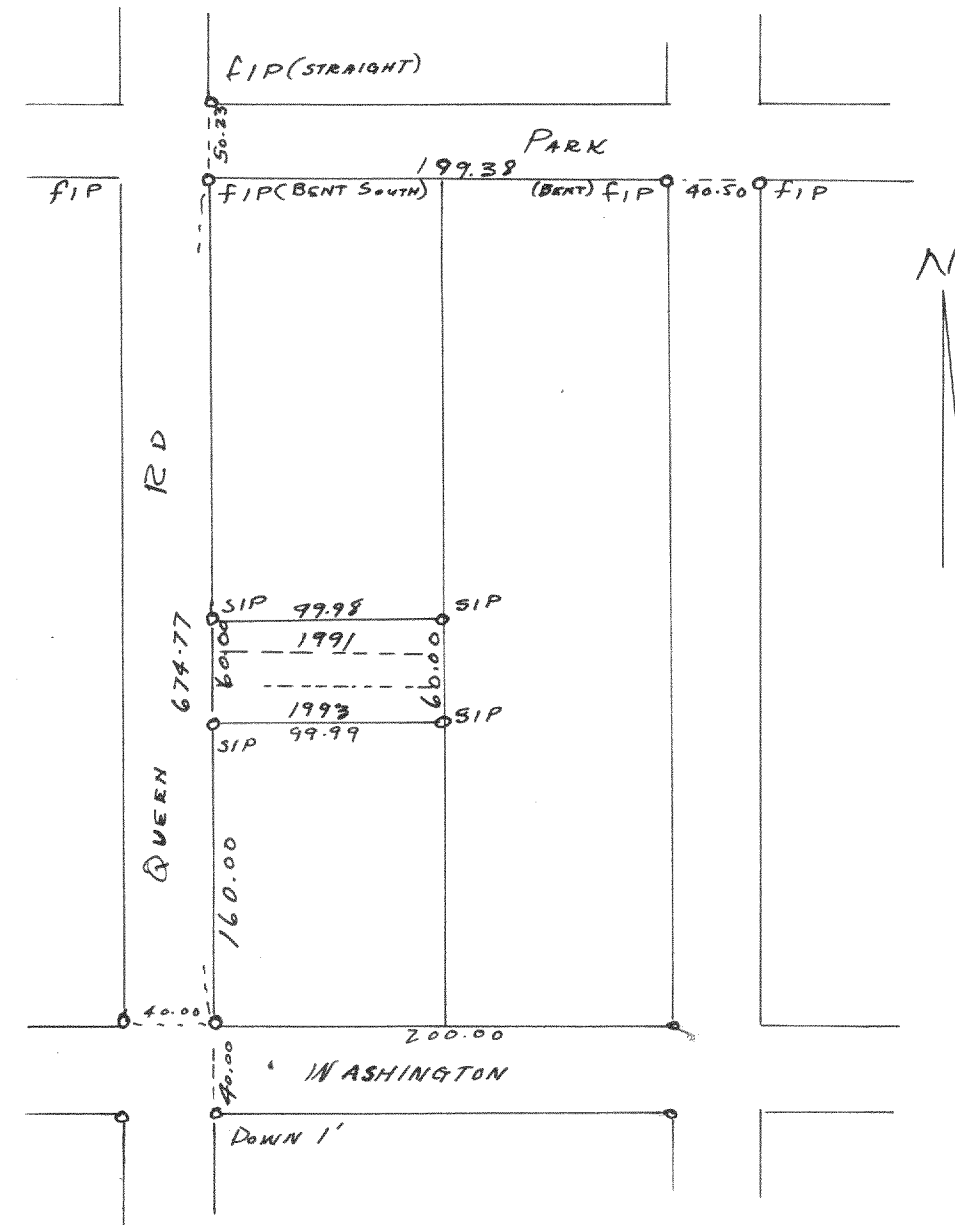

Plat of survey of lots 1991-1993, Lake Como Beach Subdivision
 Sections 21 & 22, T2N R17E in Walworth County
 Aug 17, 1948
 Lloyd L. Jensen
 City.

#1870

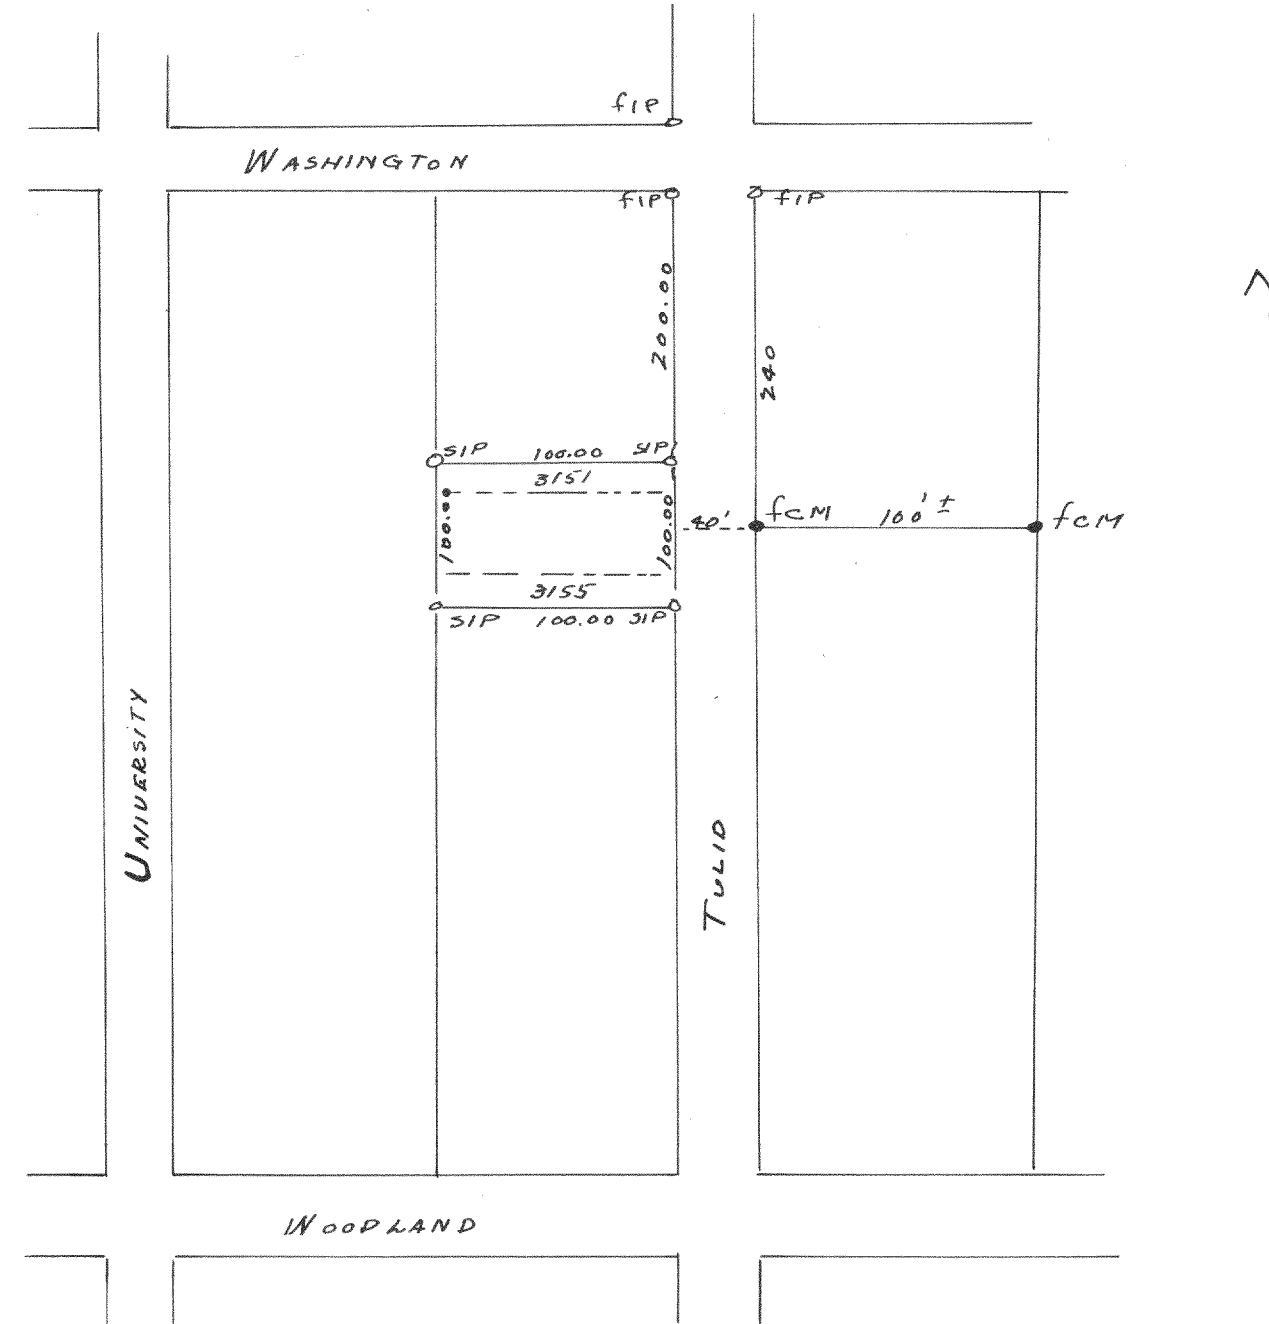

Plat of survey of lots 3151 - 3155, Lake Como Beach
 Subdivision located in Sections 21 & 22, T2N R17E Walworth County
 Aug 18, 1948
 Lloyd L. Jensen
 City.