



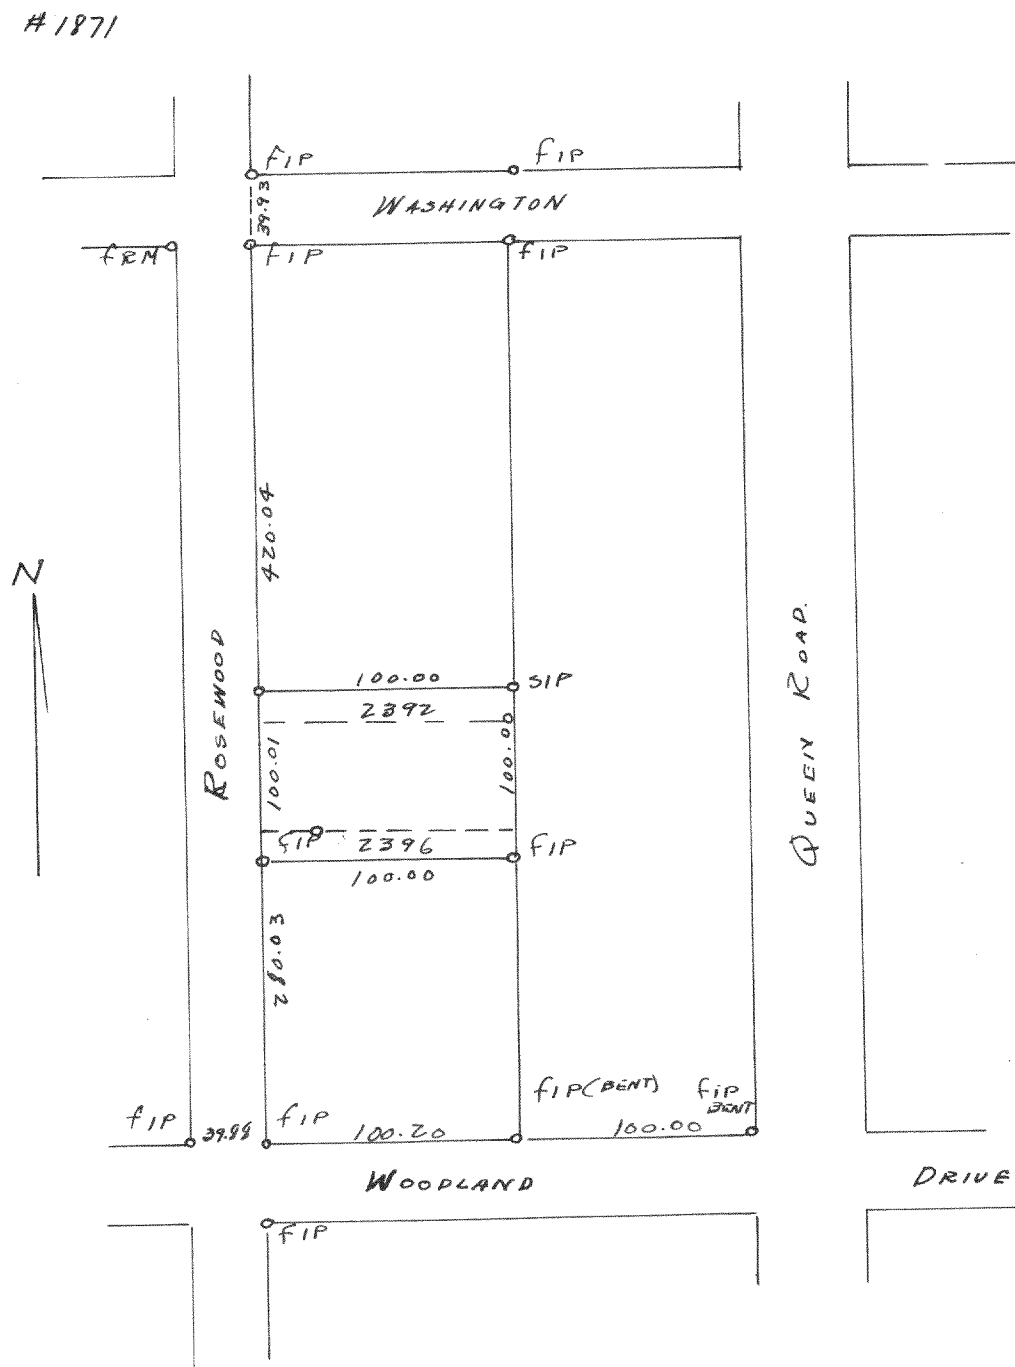

Plot of survey of lots 2892-2396 Lakeview Beach
 Subdivision located in sections 21 & 22, T2N R17E Walworth County
 Aug 17, 1948
 Lloyd L. Jensen
 City.

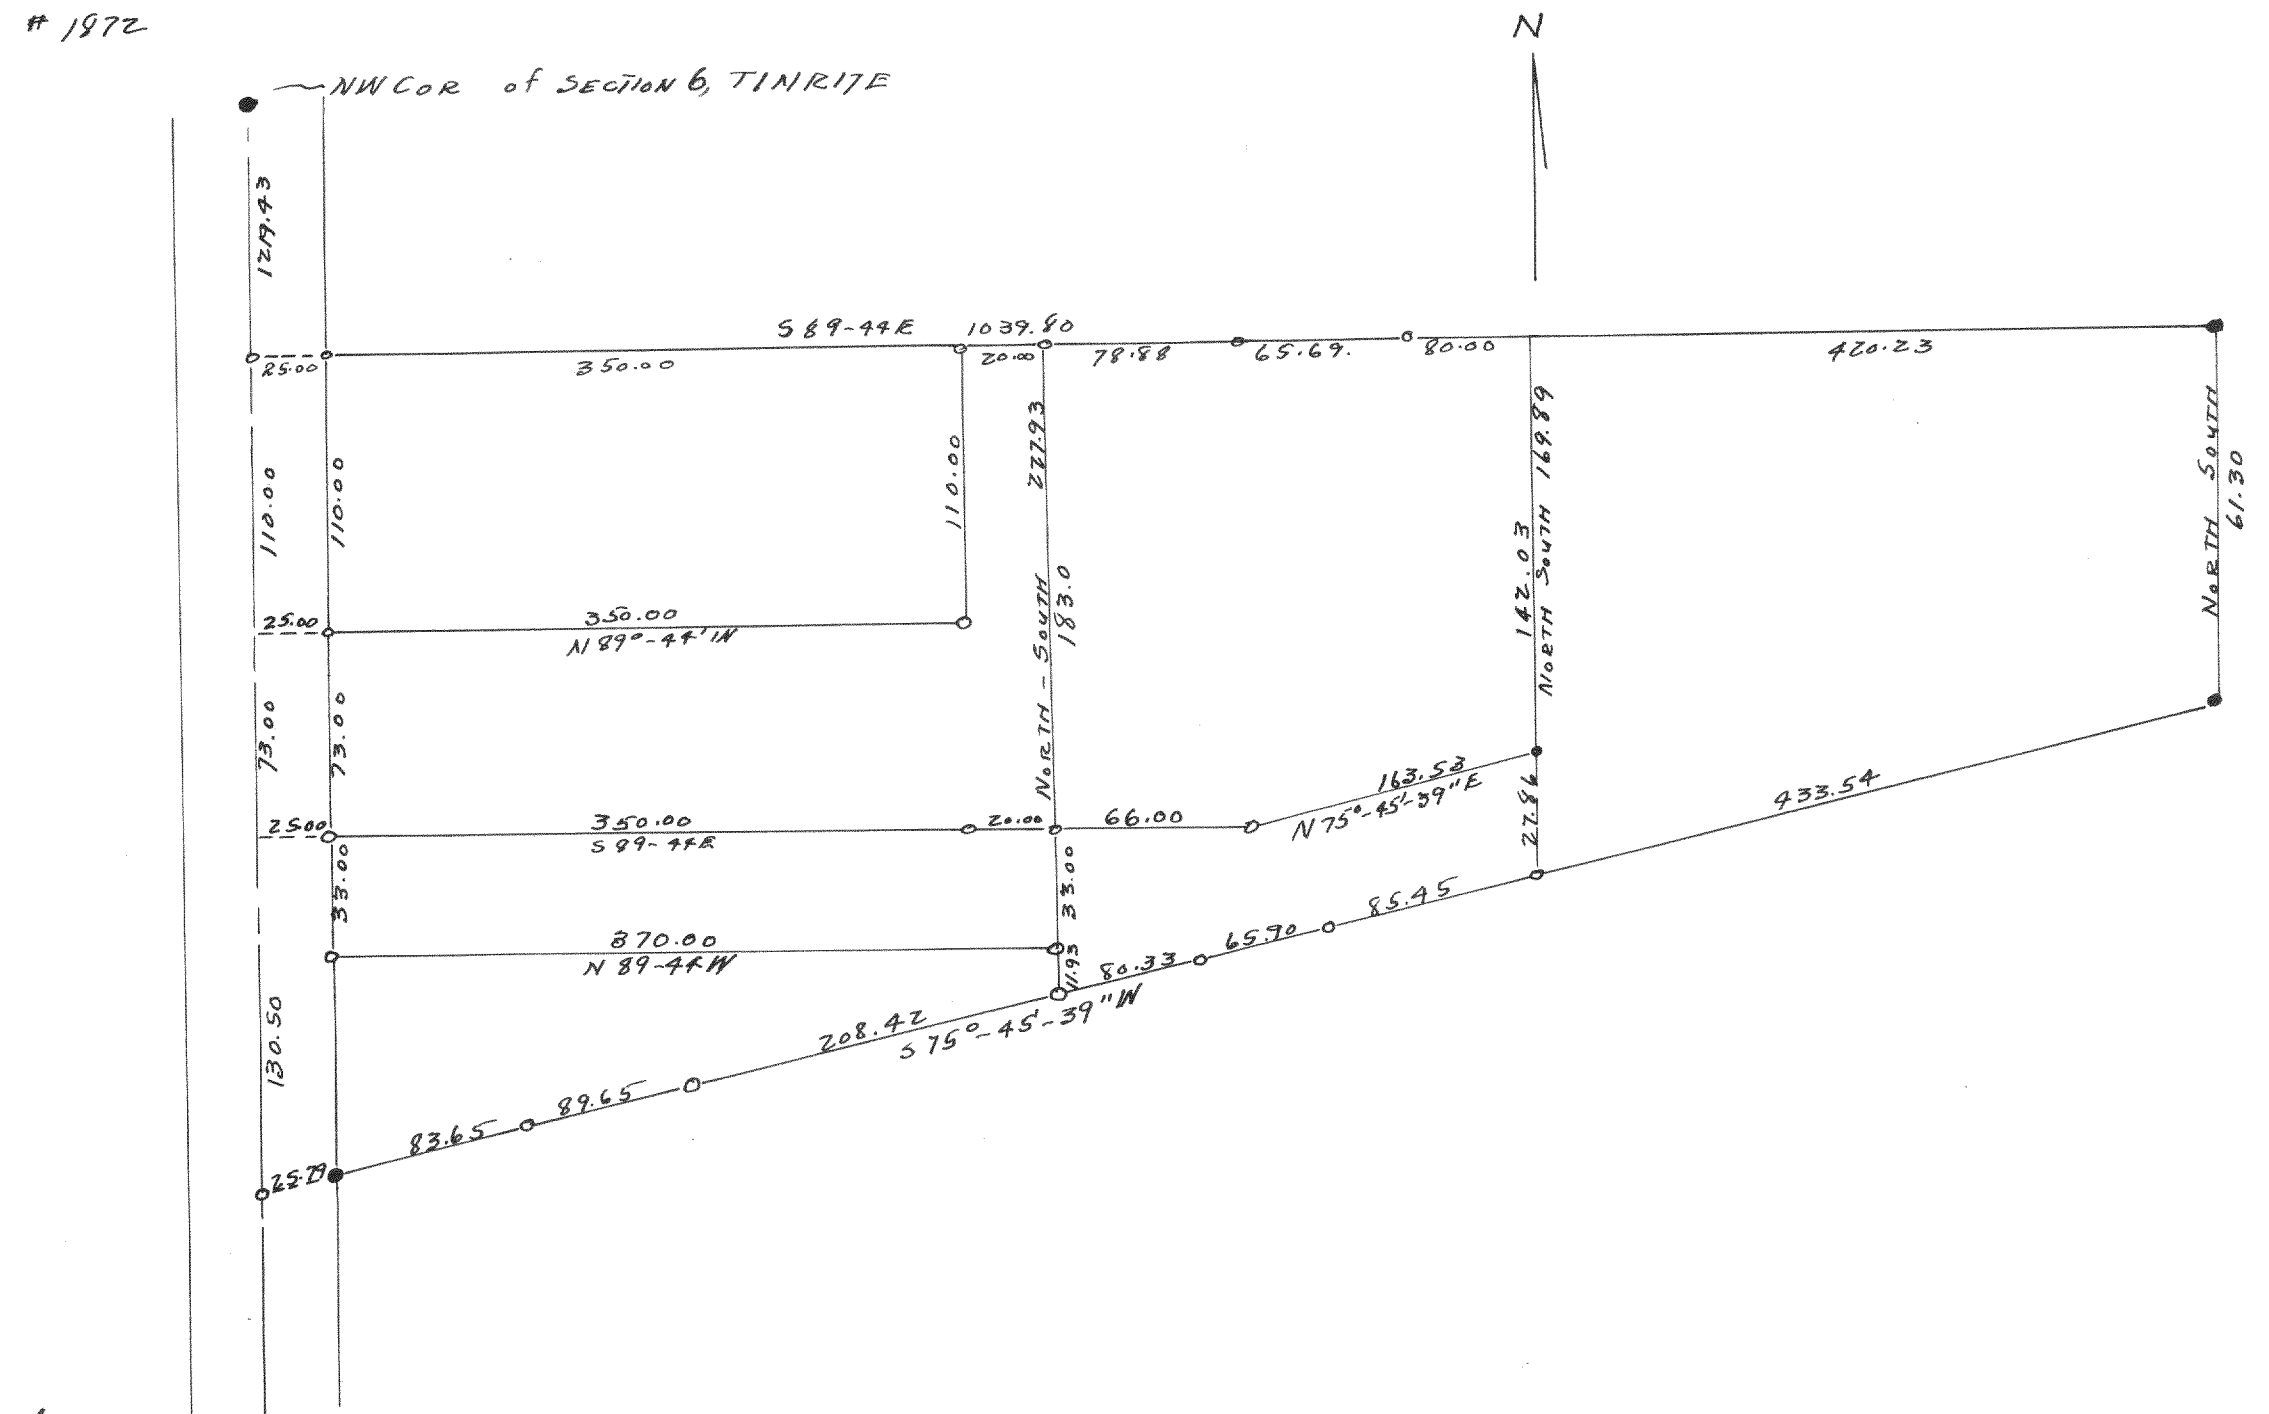

Plot of survey of lands located in the NW 1/4 of
 Section 6, T1N R17E, Walworth County
 Jan 1949
 Lloyd L. Jensen
 City.