



1878

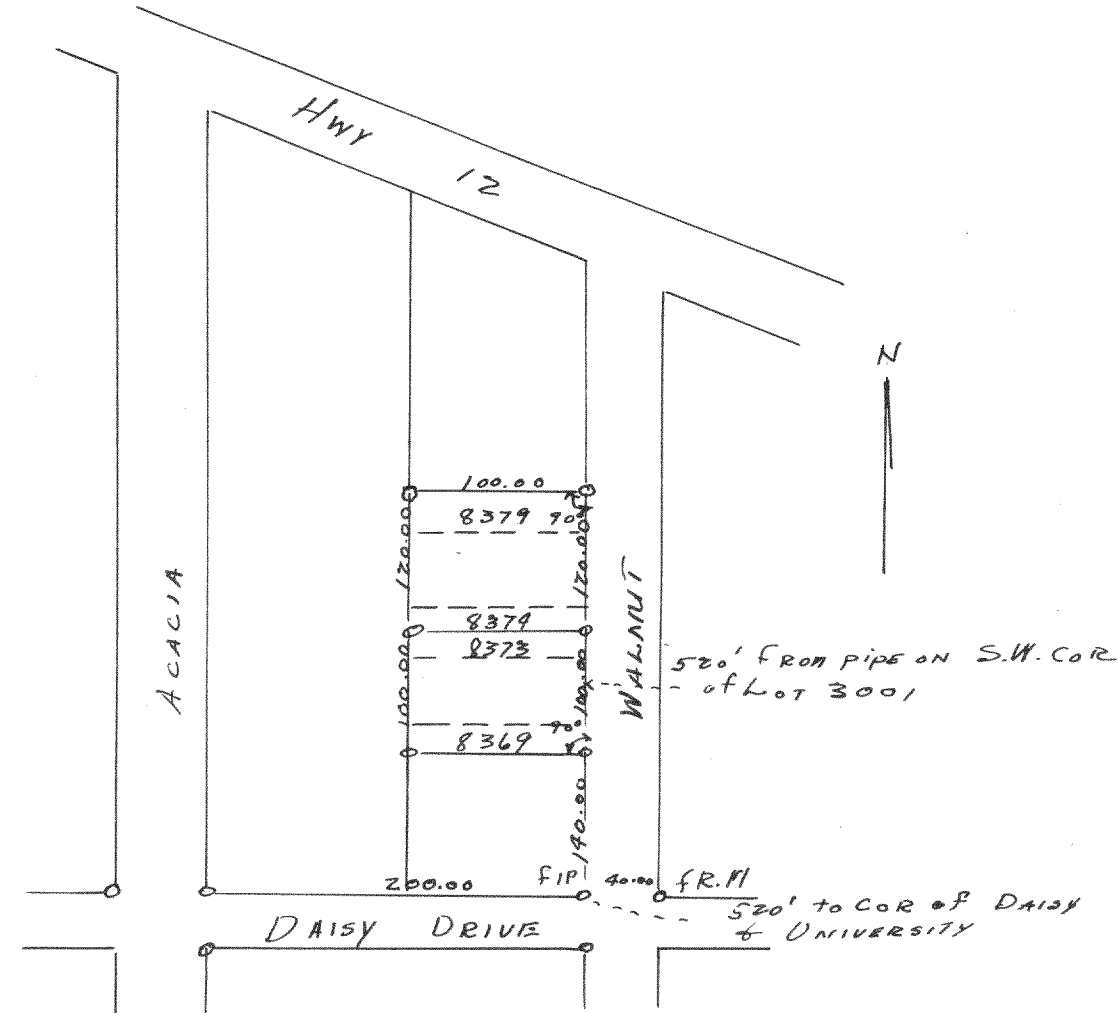


Plot of Survey of lots 8369-8379, Lake Como Beach Subdivision located in sections 21 & 22 T2N R17E Walworth County Oct 8, 1948
Lloyd L. Jensen

1879

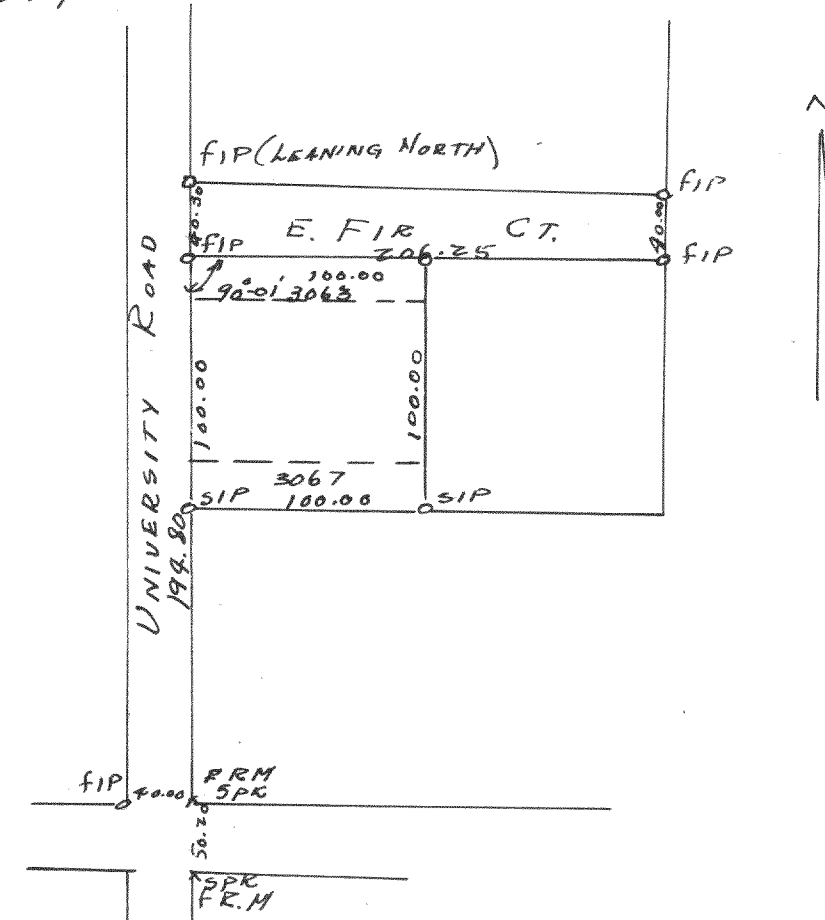


Plot of Survey of lots 3063-3067 Lake Como Beach Subdivision located in sections 21 & 22 T2N R17E Walworth County Oct 8, 1948
Lloyd L. Jensen
CWS

1890

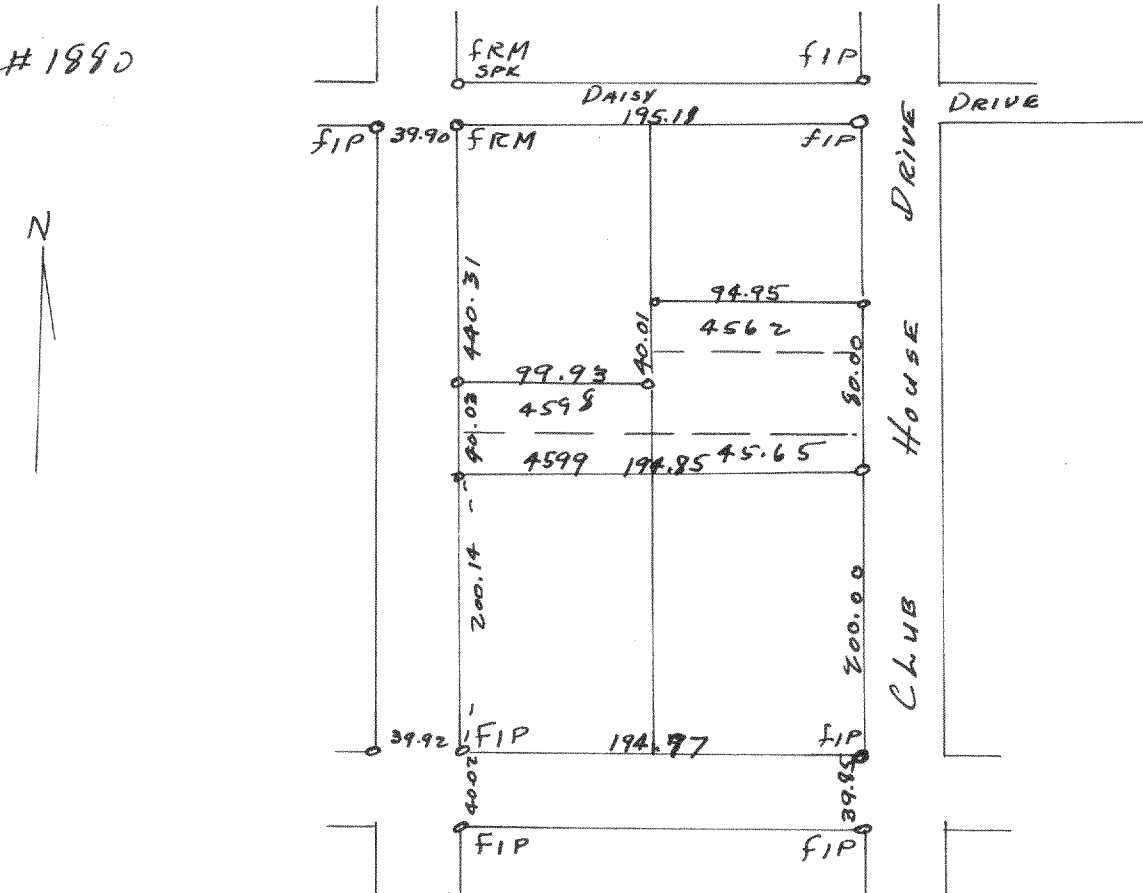

Plot of Survey of lots 4562-4598-9 Lake Como Beach Subdivision located in sections 21 & 22 T2N R17E Walworth County Oct. 14, 1948
Lloyd L. Jensen

1881

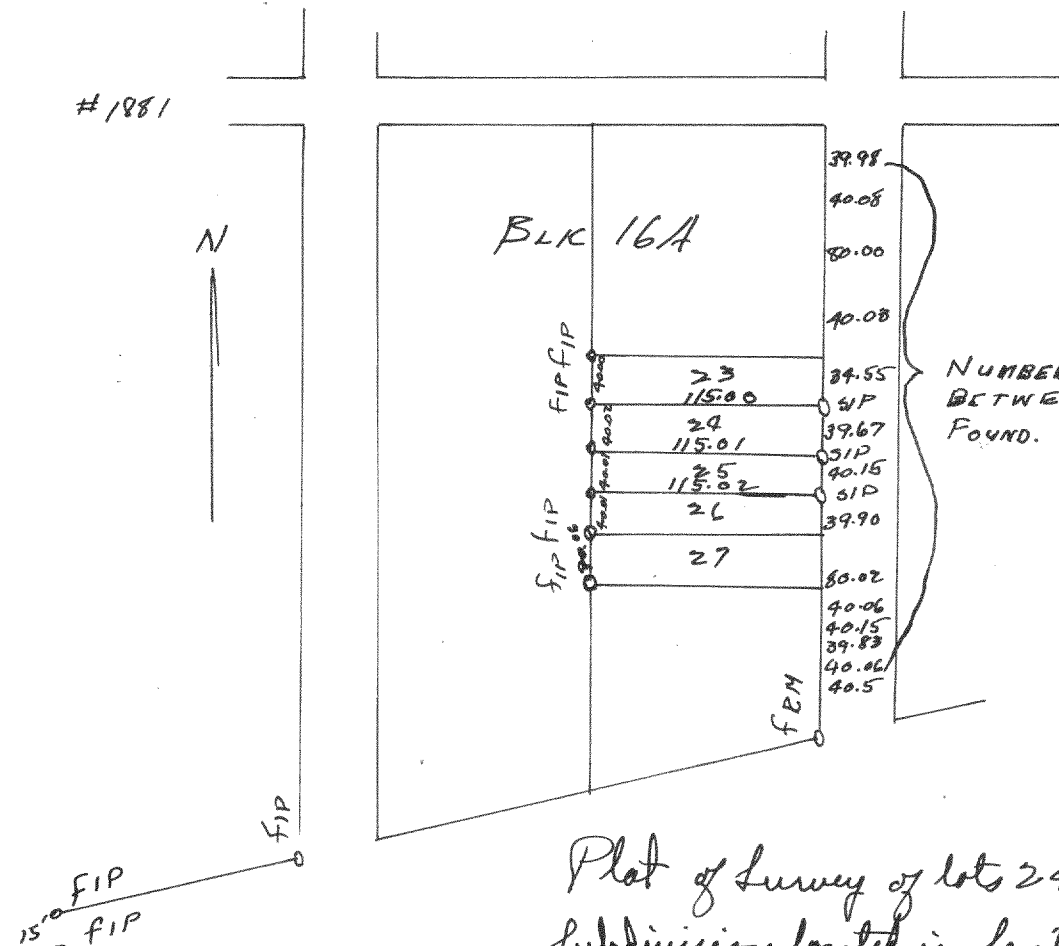

Plot of Survey of lots 24 & 25 Blk 16A in Sunset Hills Subdivision located in section 33, T2N R17E, Walworth County Oct 16, 1948
Lloyd L. Jensen
CWS

NUMBERS ARE DISTANCES MEASURED BETWEEN LOT CORNERS THAT WERE FOUND. PLAT DOES NOT CHECK THE DISTANCES.