



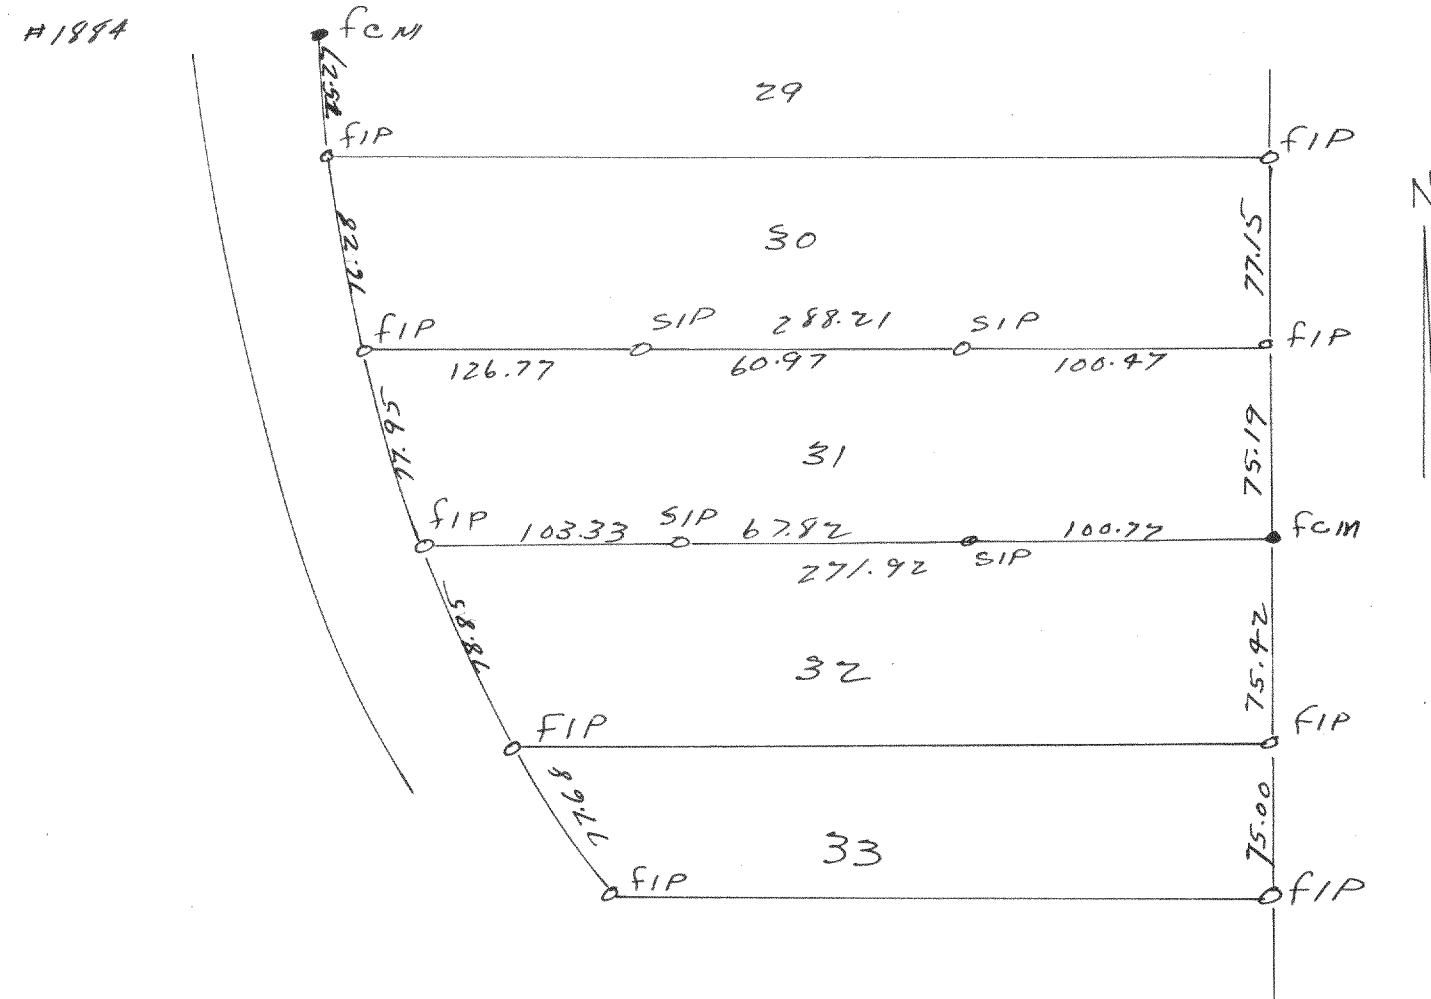

Plot of survey of lot 31 in "The Dukes" 1st addition located
in Section 9, T1N R17E
Oct. 1948
Lloyd L. Jensen
Culley

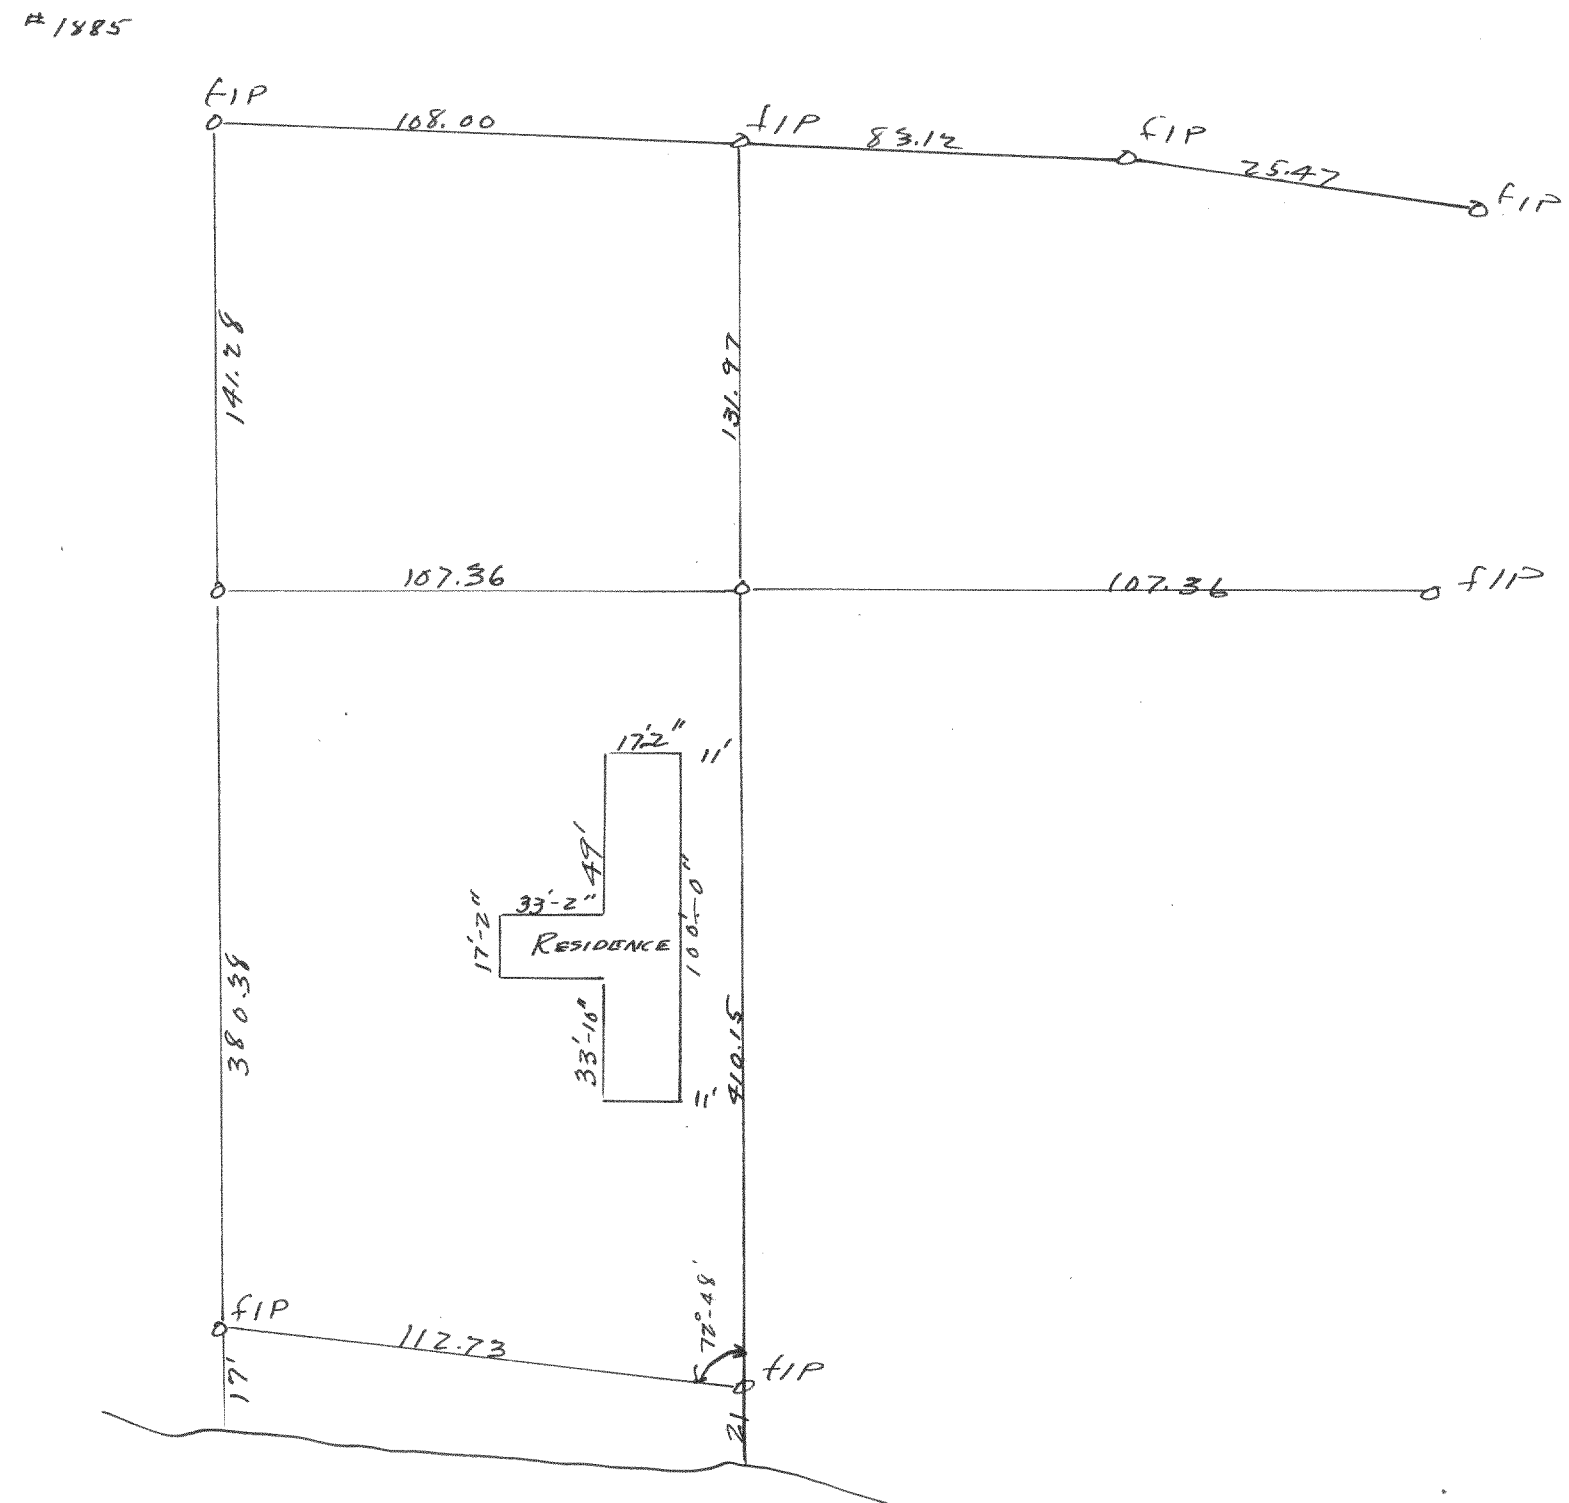

Plot of survey of lot 3 in S.B. Chapins Subdivision
located in Section 5 T1N R17E Woodworth County
Aug 1948
Lloyd L. Jensen
Culley