



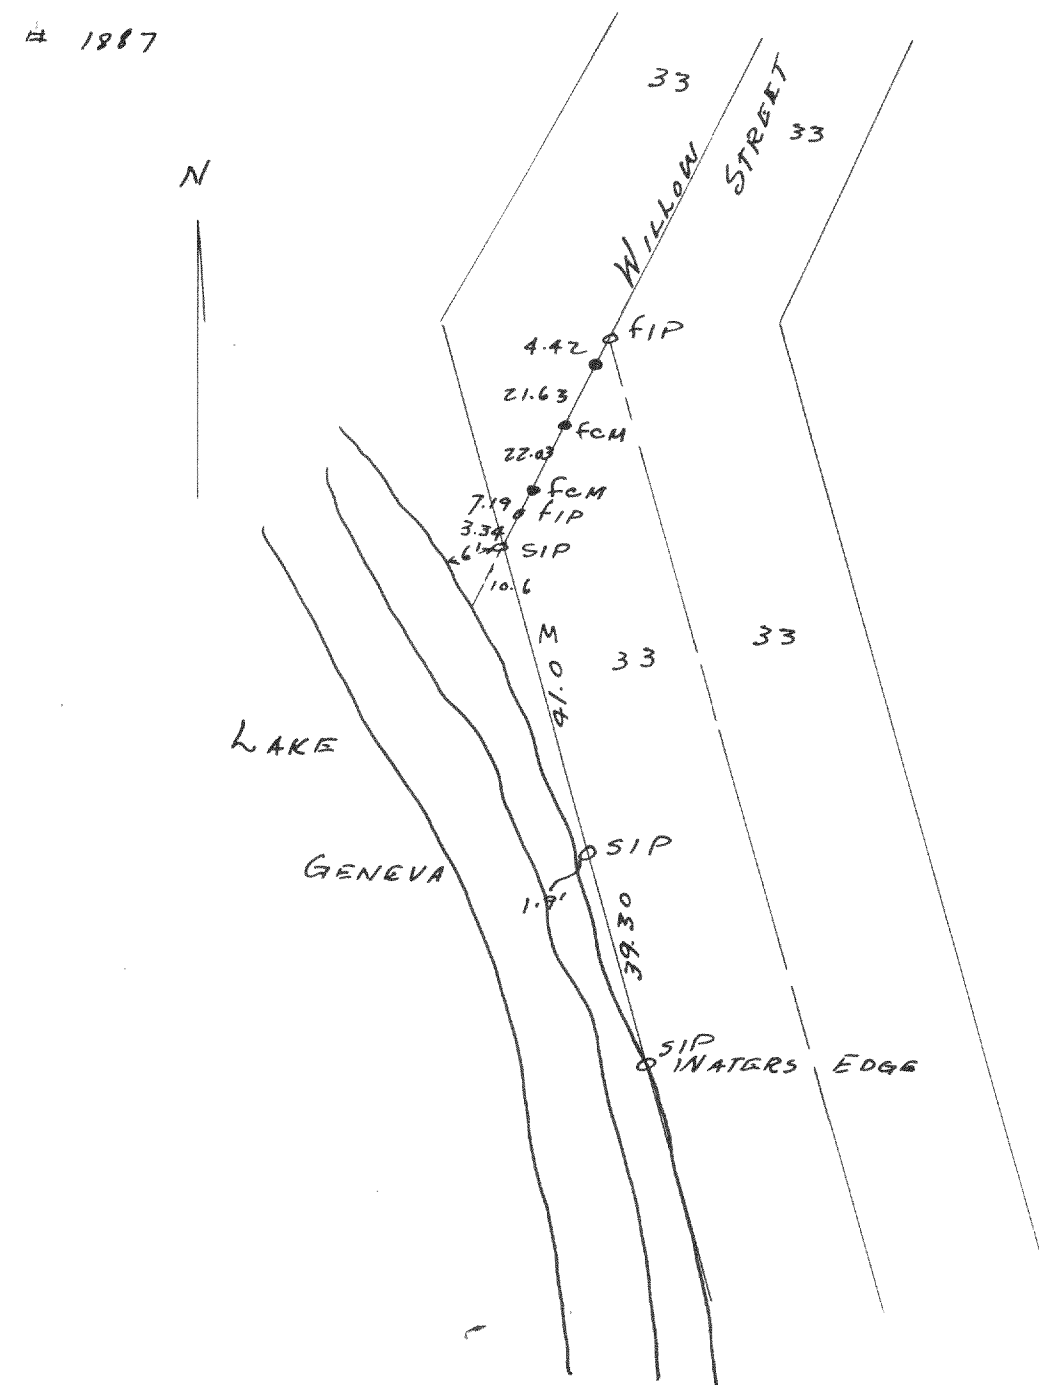

Plot of Survey of the land between the waters edge
of Lake Geneva and the edge of the R.O.W of the Public
Road on the Motag Farm. Section 17 T19N R17E Walworth County
Nov. 1948 Lloyd S. Jensen

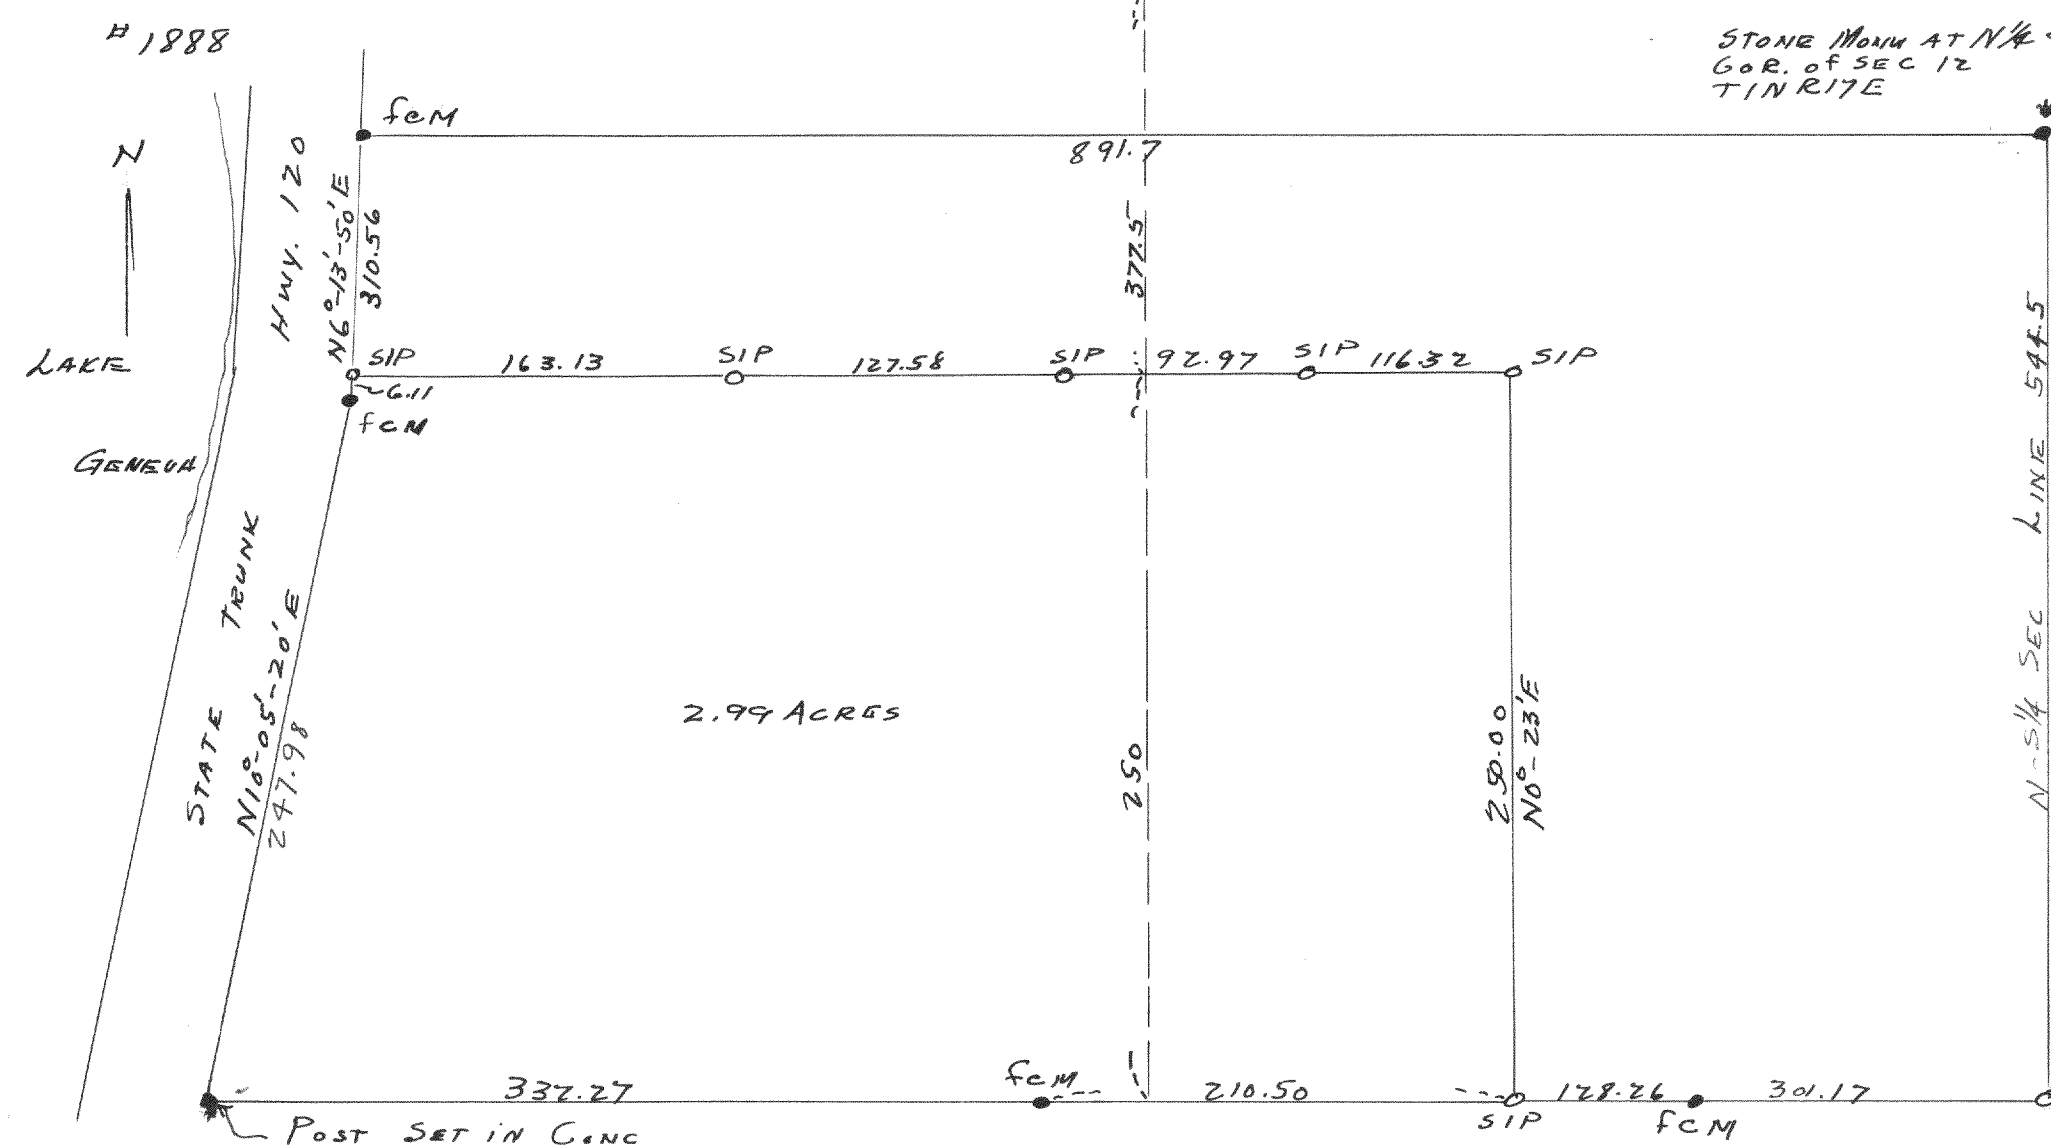

Plat of Survey of a parcel of land located in the NW 1/4 of
Section 12, T19N R17E, Walworth County
Sept 24, 1948
 Floyd L. Jensen
CWS.