



#1893

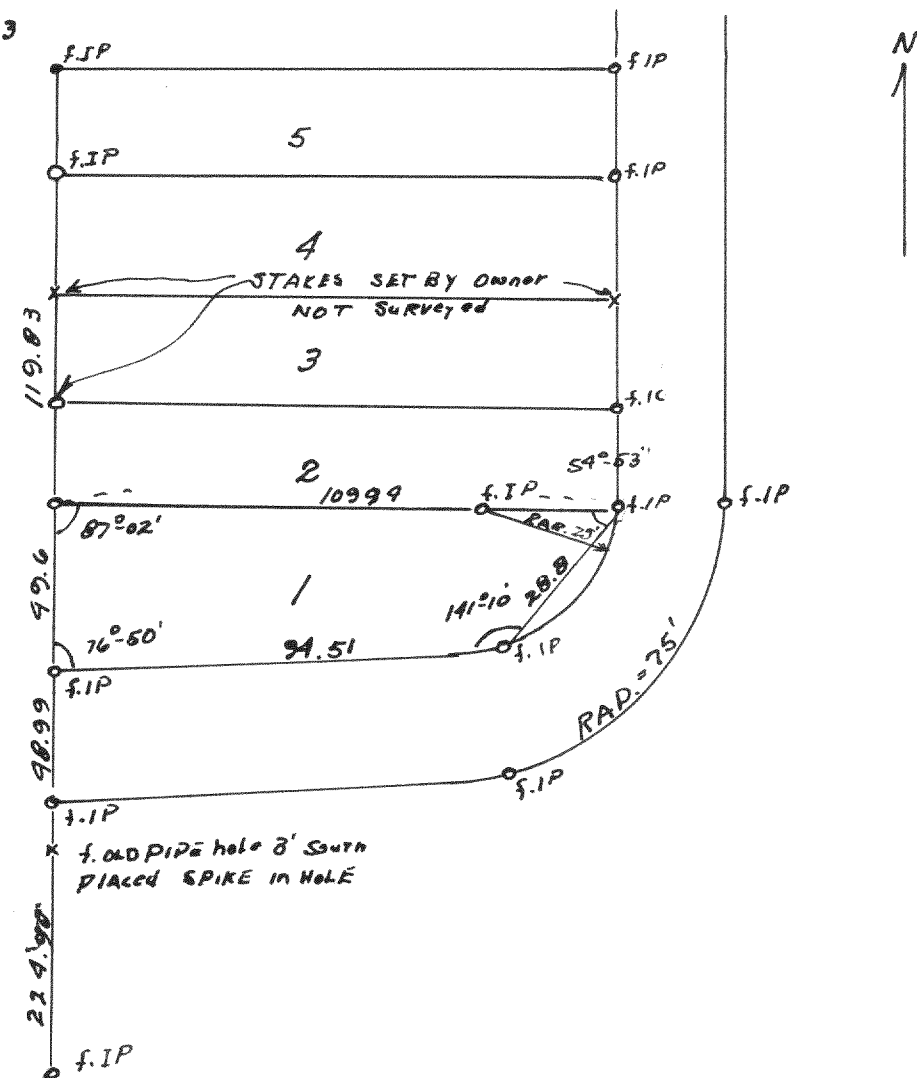


Plot of survey of lot 1 Block 'B' in Knollwood Subd located  
in Section 5 T1N R17E Walworth County  
June 3, 1998  
Lloyd L. Jensen  
County Surveyor  
C.S.

#1895

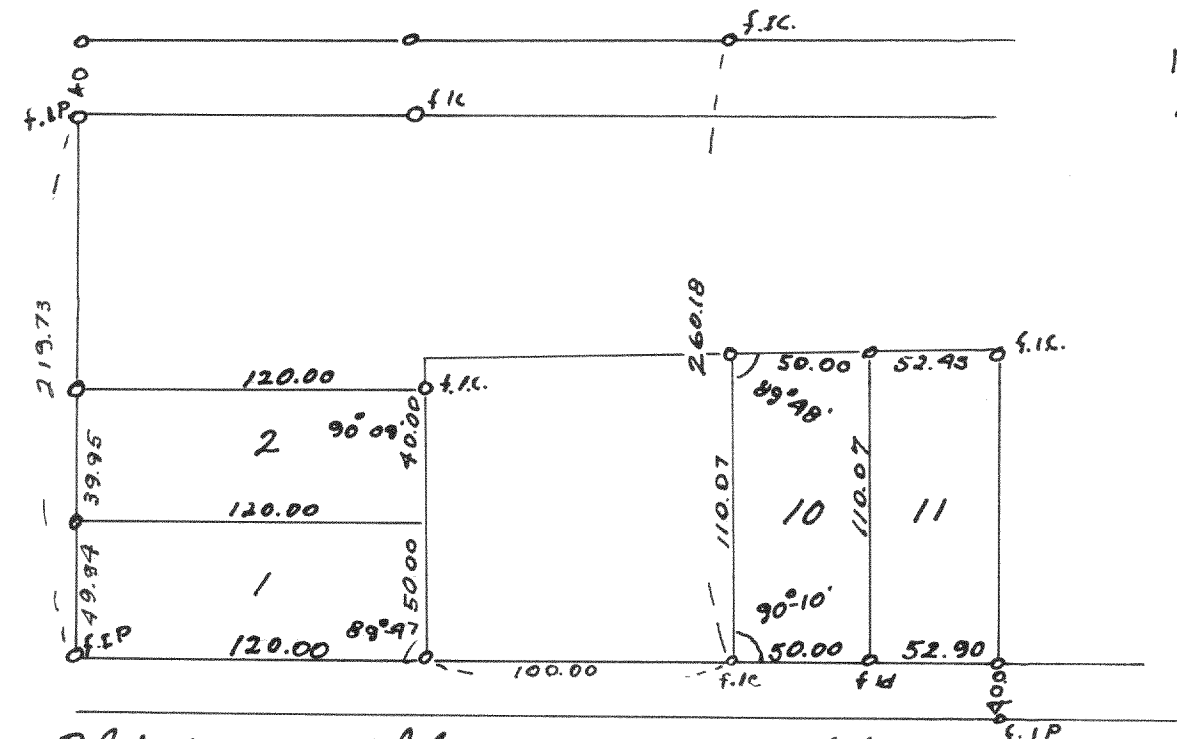

Plot of survey of lots 1, 2, 10, and 11 in Block 22 in  
Sunset Hills Subdivision located in Section 33 T2N R17E Walworth County  
June 16, 1998  
Lloyd L. Jensen  
County Surveyor  
C.S.


#1894

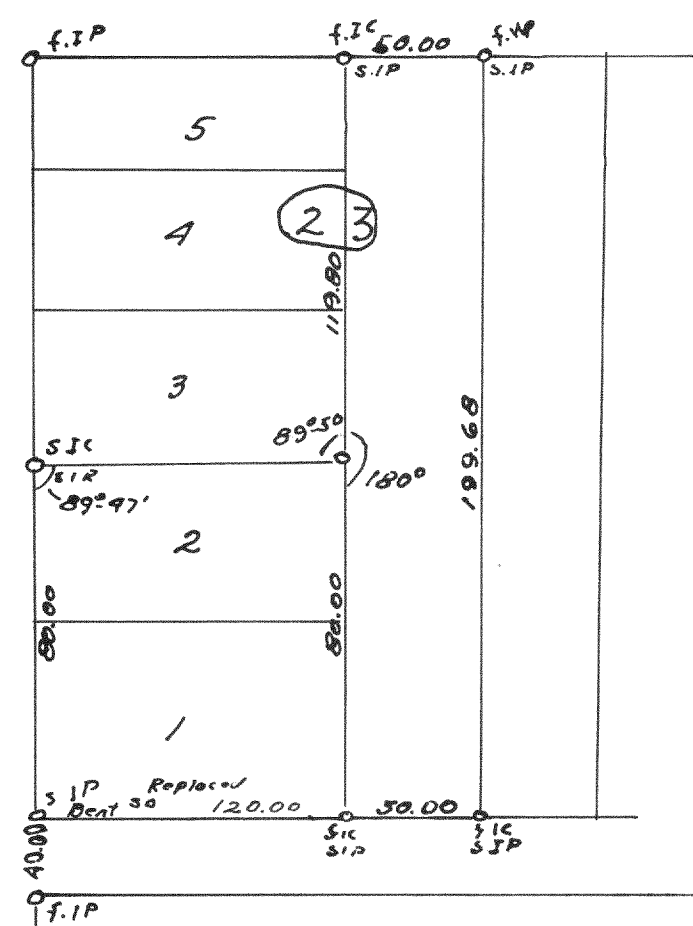

Plot of survey of lots 1, 2, and 6 of Block 23 in  
Sunset Hills Subdivision located in Section 33 T2N R17E  
Walworth County

Lloyd L. Jensen  
County Surveyor  
C.S.

#1896

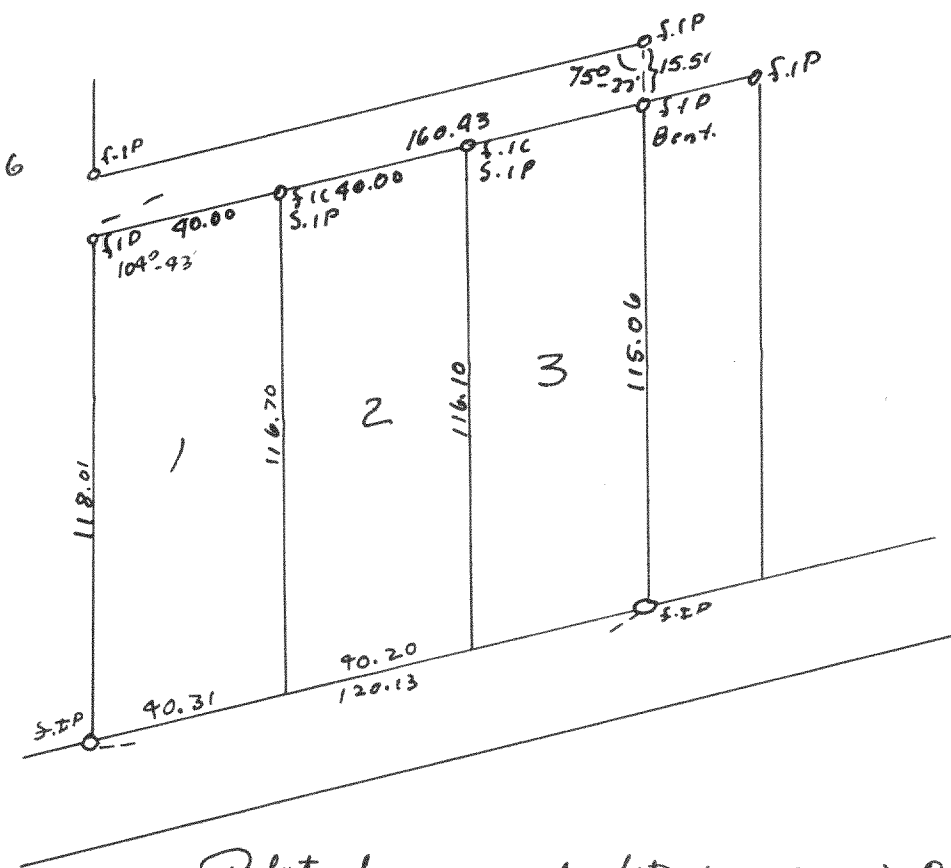

Plot of survey of lots 1 and 2 in Block 10 in  
Sunset Hills Subdivision located in Section 33 T2N R17E  
June 17, 1998

Lloyd L. Jensen  
County Surveyor  
C.S.