




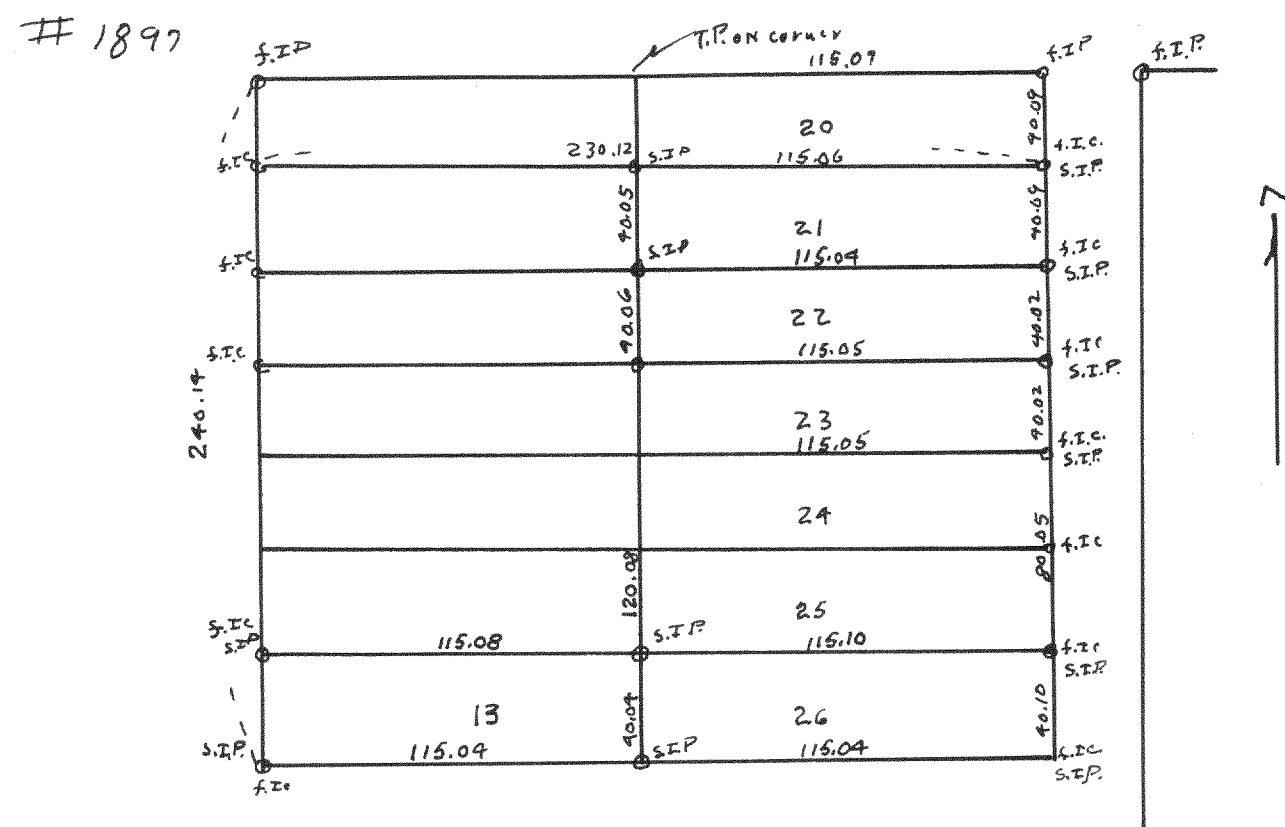


Plot of survey of lots 13, 20, 21, 22, 23, & 26 in Block 15 of Sunset Hills subdivision located in Section 33, T2N R17E of Malvern County, Miss
June 1948
Floyd S Jensen
County Surveyor
[Signature]

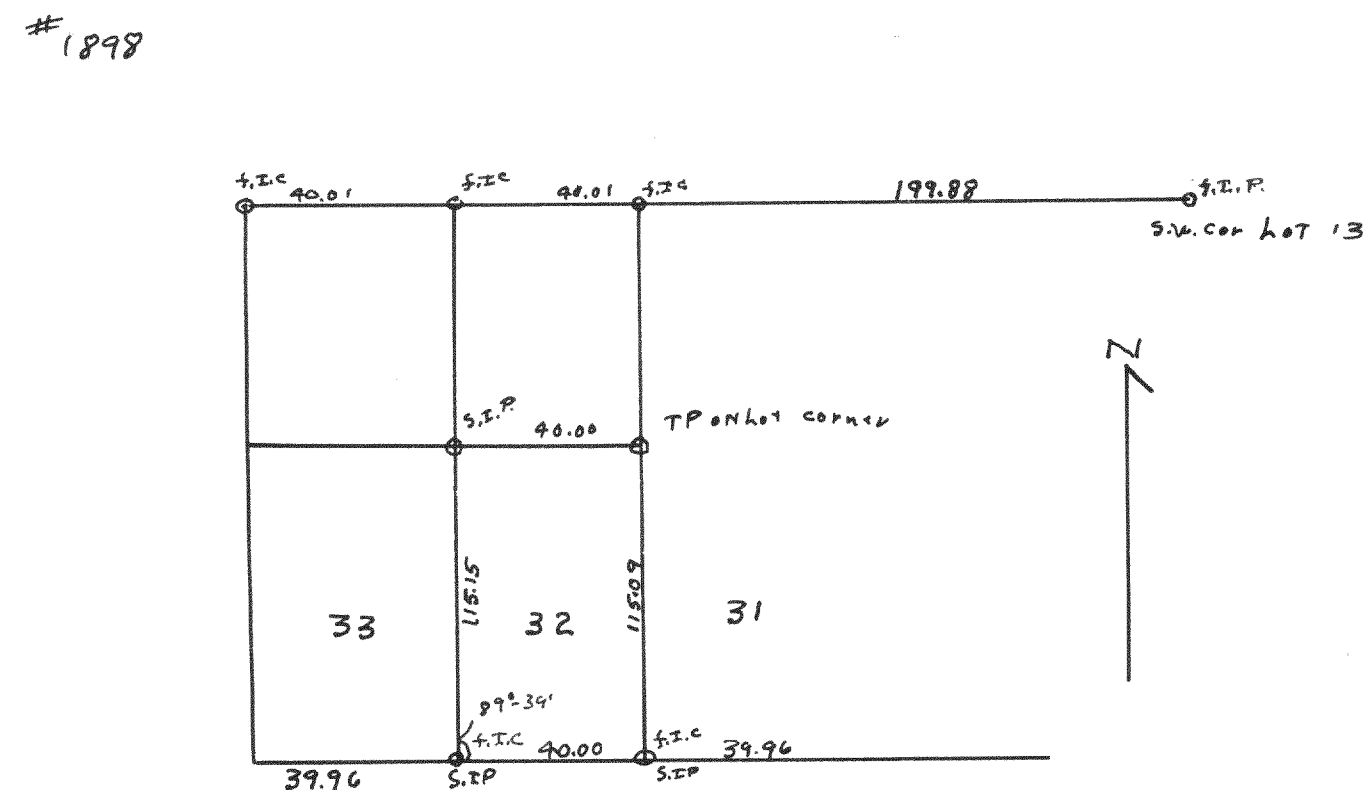

Plot of survey of Lot 32 Block 15 Sunset Hills subdivision located in Section 33, T2N R17E Malvern County, Miss
June 1948
Floyd S Jensen
County Surveyor
[Signature]

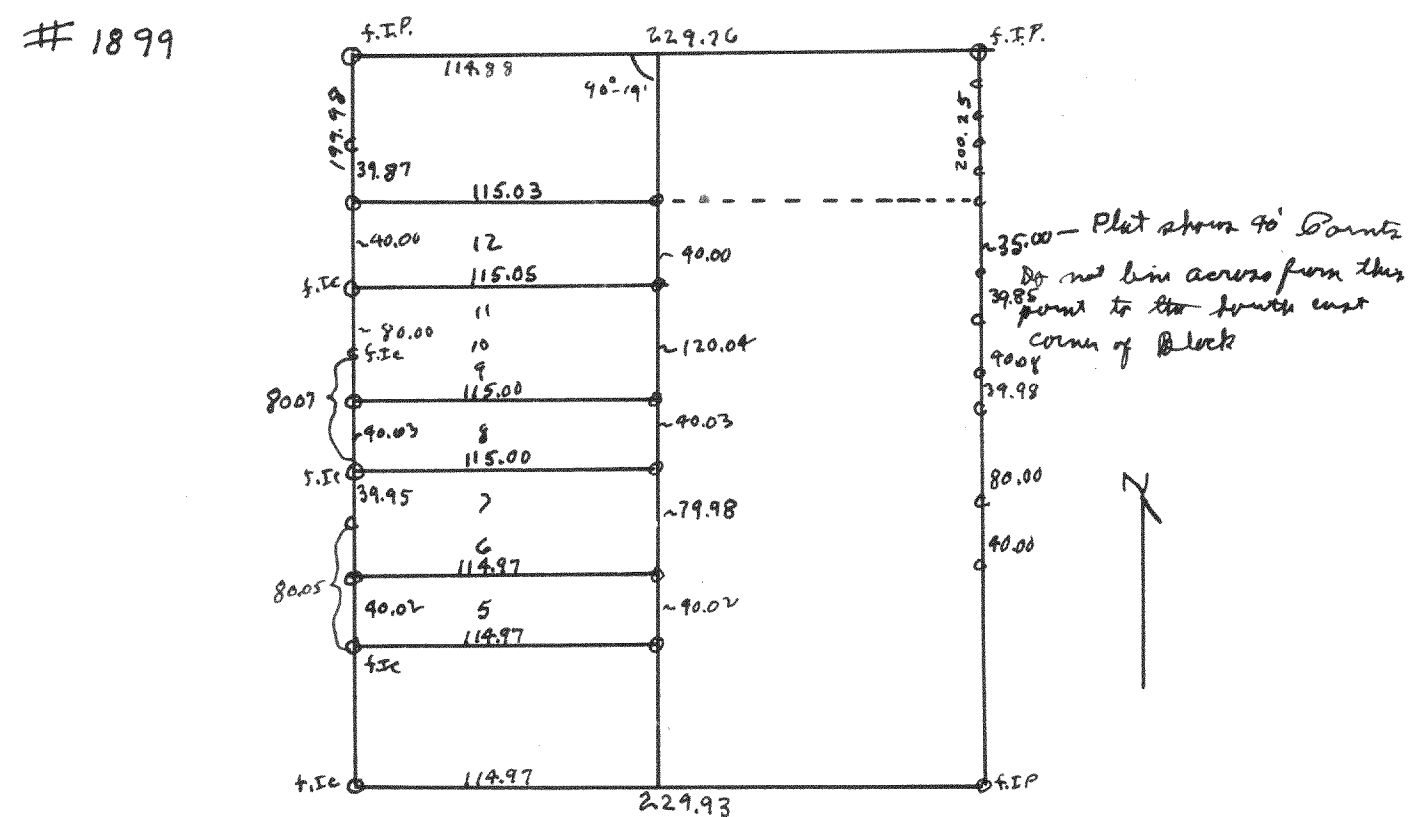

Plot of survey of lots 5, 8, & 12 in Block 16A of Sunset Hills subdivision located in Section 33, T2N R17E
June 1948
Floyd S Jensen
County Surveyor
[Signature]

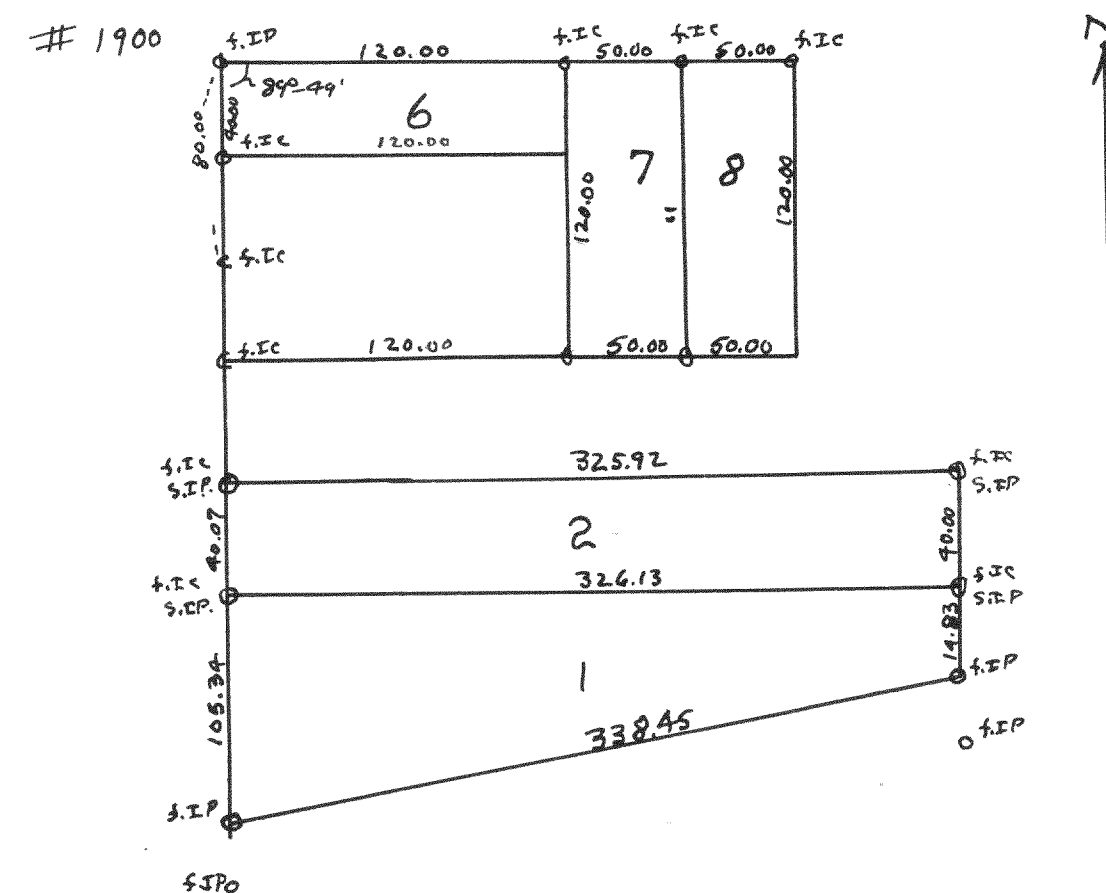

Plot of survey of lots 1, 2, 6, 7, & 8 of Block 17 in Sunset Hills located in Section 33, T2N R17E Malvern County, Miss
July 1948
Floyd S Jensen
County Surveyor
[Signature]