



1901

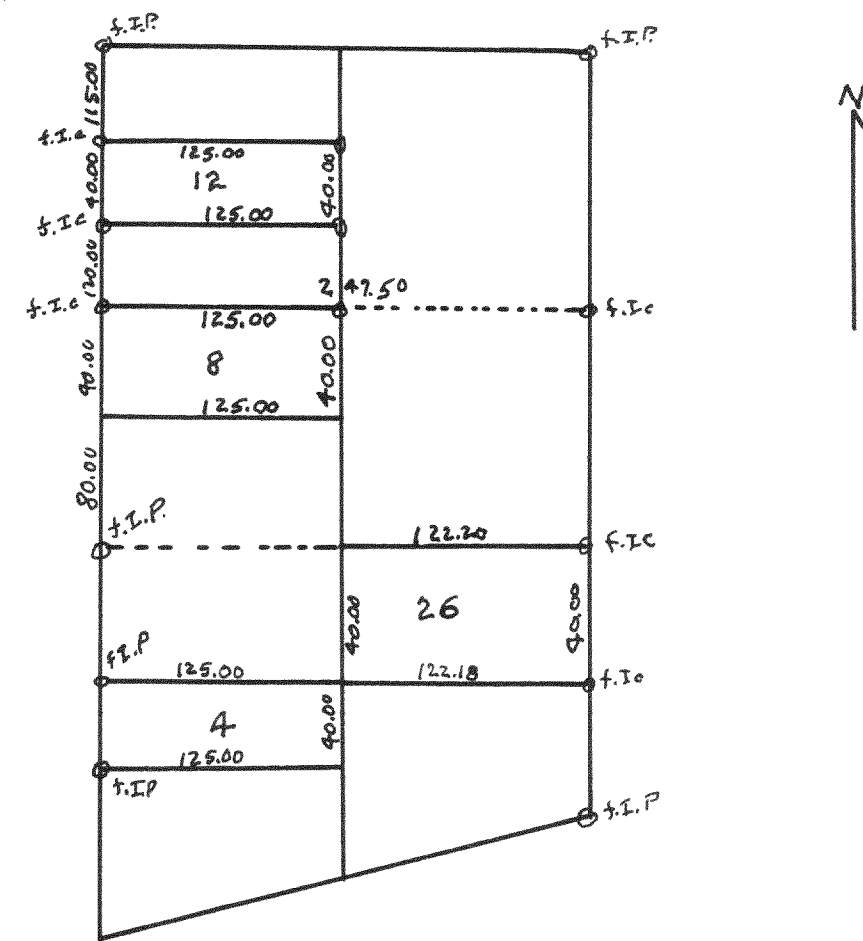


Plot of survey of lots 4, 8, 12, & 26 in Block 16B of
Sunset Hills subdivision located in Section 33, T2N R17E of Malworth County, Miss.
July 1948
Lloyd S Jensen
County Surveyor

1903

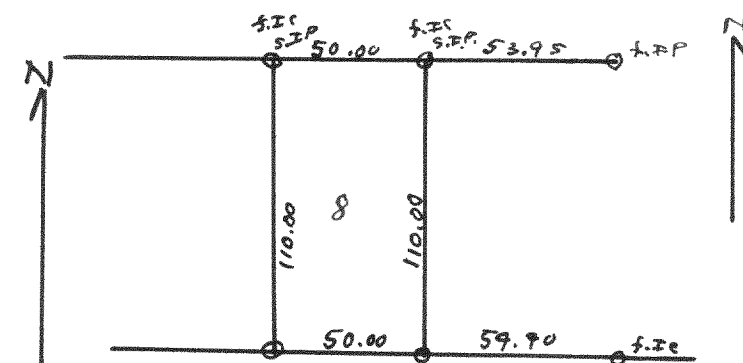


Plot of survey of lot 8 Block 18 of Sunset Hills
subdivision located in Section 33, T2N R17E of Malworth County, Miss.
July 1948
Lloyd S Jensen
County Surveyor

1902

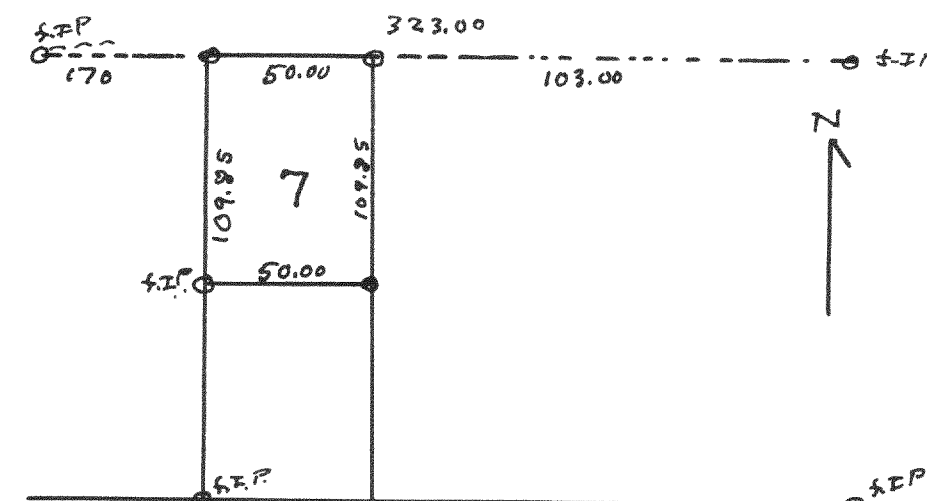

Plot of survey of lot 7 Block 21 in Sunset Hills subdivision
located in Section 33, T2N R17E of Malworth County, Miss.
July 1948
Lloyd S Jensen
County Surveyor

1904

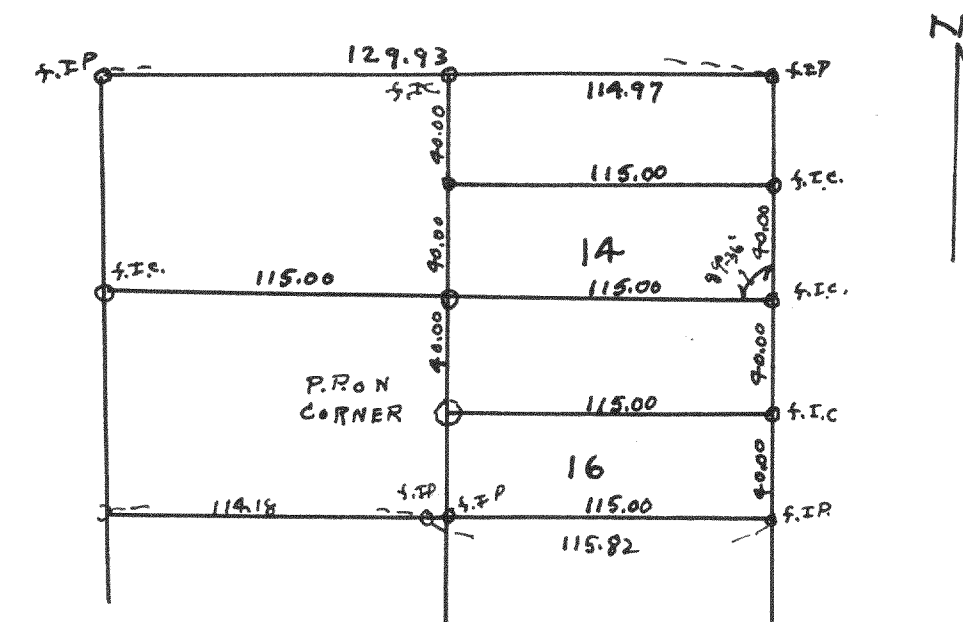

Plot of survey of lots 14 & 16 of Block 19 Sunset Hills
subdivision located in Section 33, T2N R17E of Malworth County, Miss.
July 1948
Lloyd S. Jensen
County Surveyor