


#1905

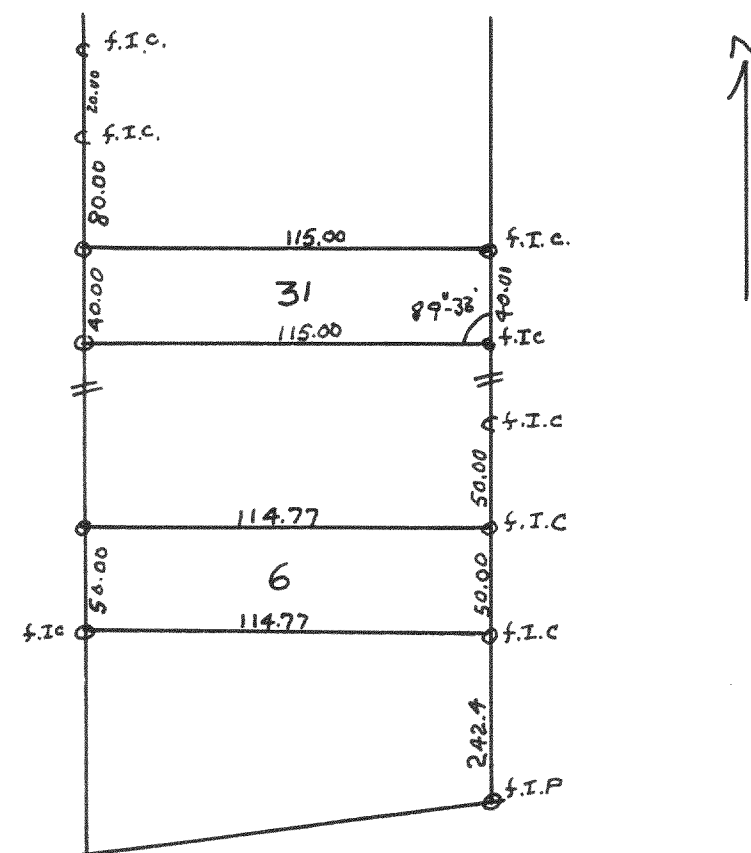


Plot of survey of lots 6 & 31 Block 14 in Sunset
Hills subdivision located in Section 33, T1N R17E

July 8, 1948

Lloyd S Jensen *sd*
County Surveyor

#1907

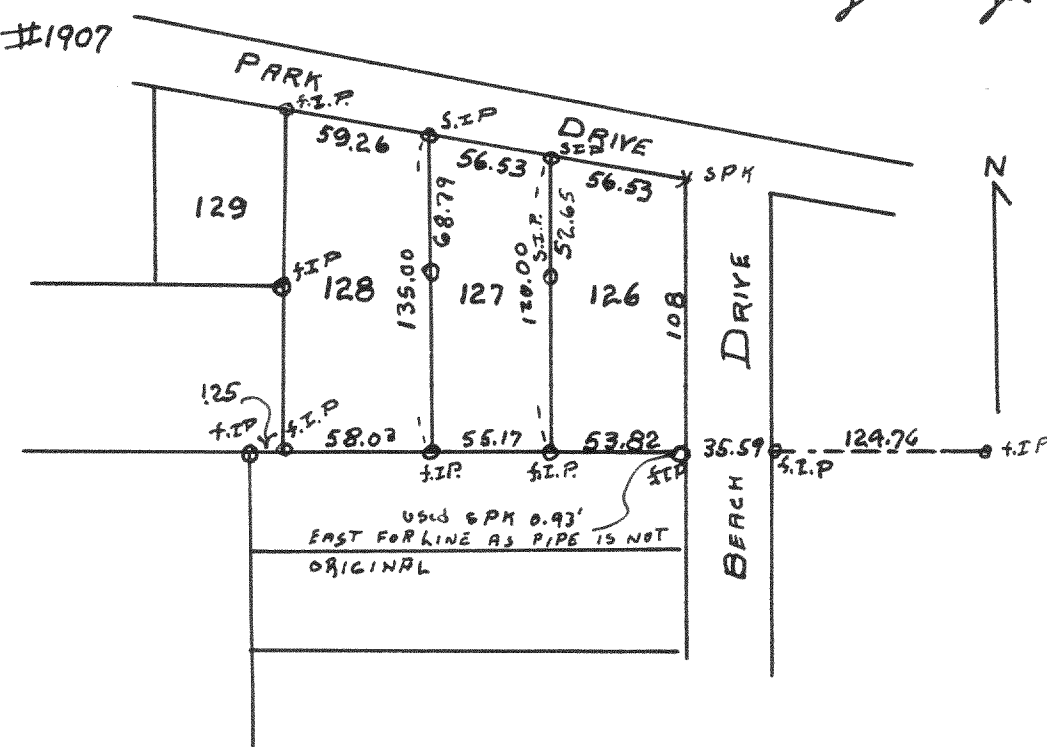


Plot of survey of lot 127 Lake Geneva Beach
subdivision located in Section 11, T1N R17E Malworth County, Wis.

Oct 19, 1948

Lloyd S Jensen
County Surveyor
sd

#1906

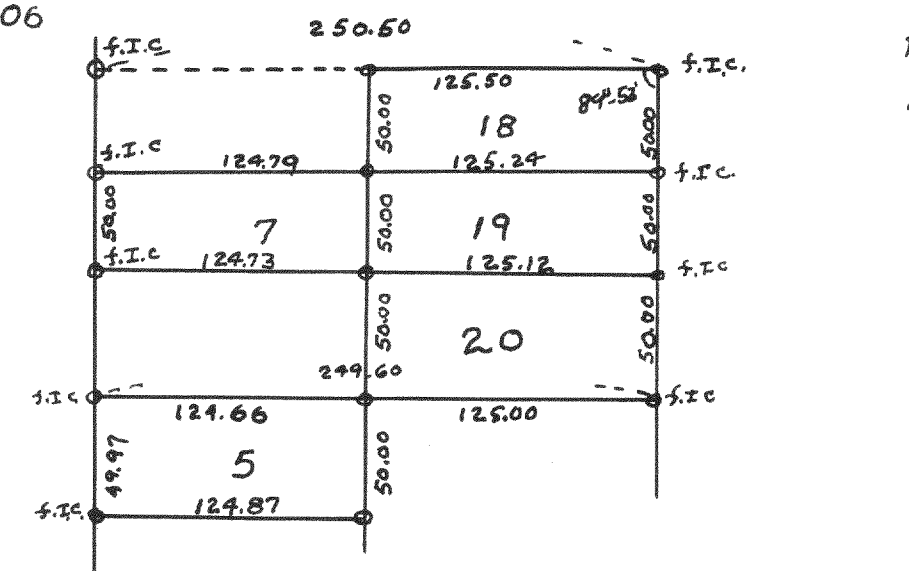


Plot of survey of lots 18, 19, & 20 of Block 24 Sunset Hills
subdivision located in Section 33, T1N R17E

July 1948

Lloyd S Jensen
County Surveyor
sd

#1908

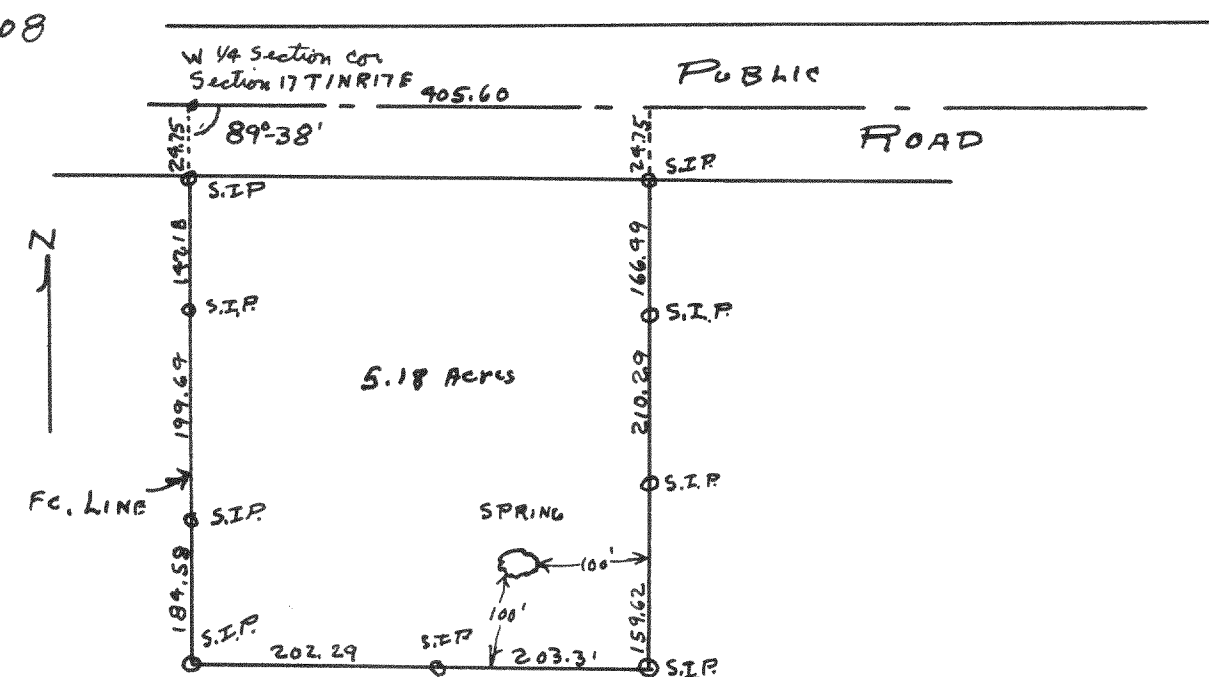

Plot of survey of parcel of land located in the SW 1/4 of
Section 17 T1N R17E of Malworth County, Wisconsin
December 24, 1948

Lloyd S Jensen
County Surveyor
sd