



368

1909

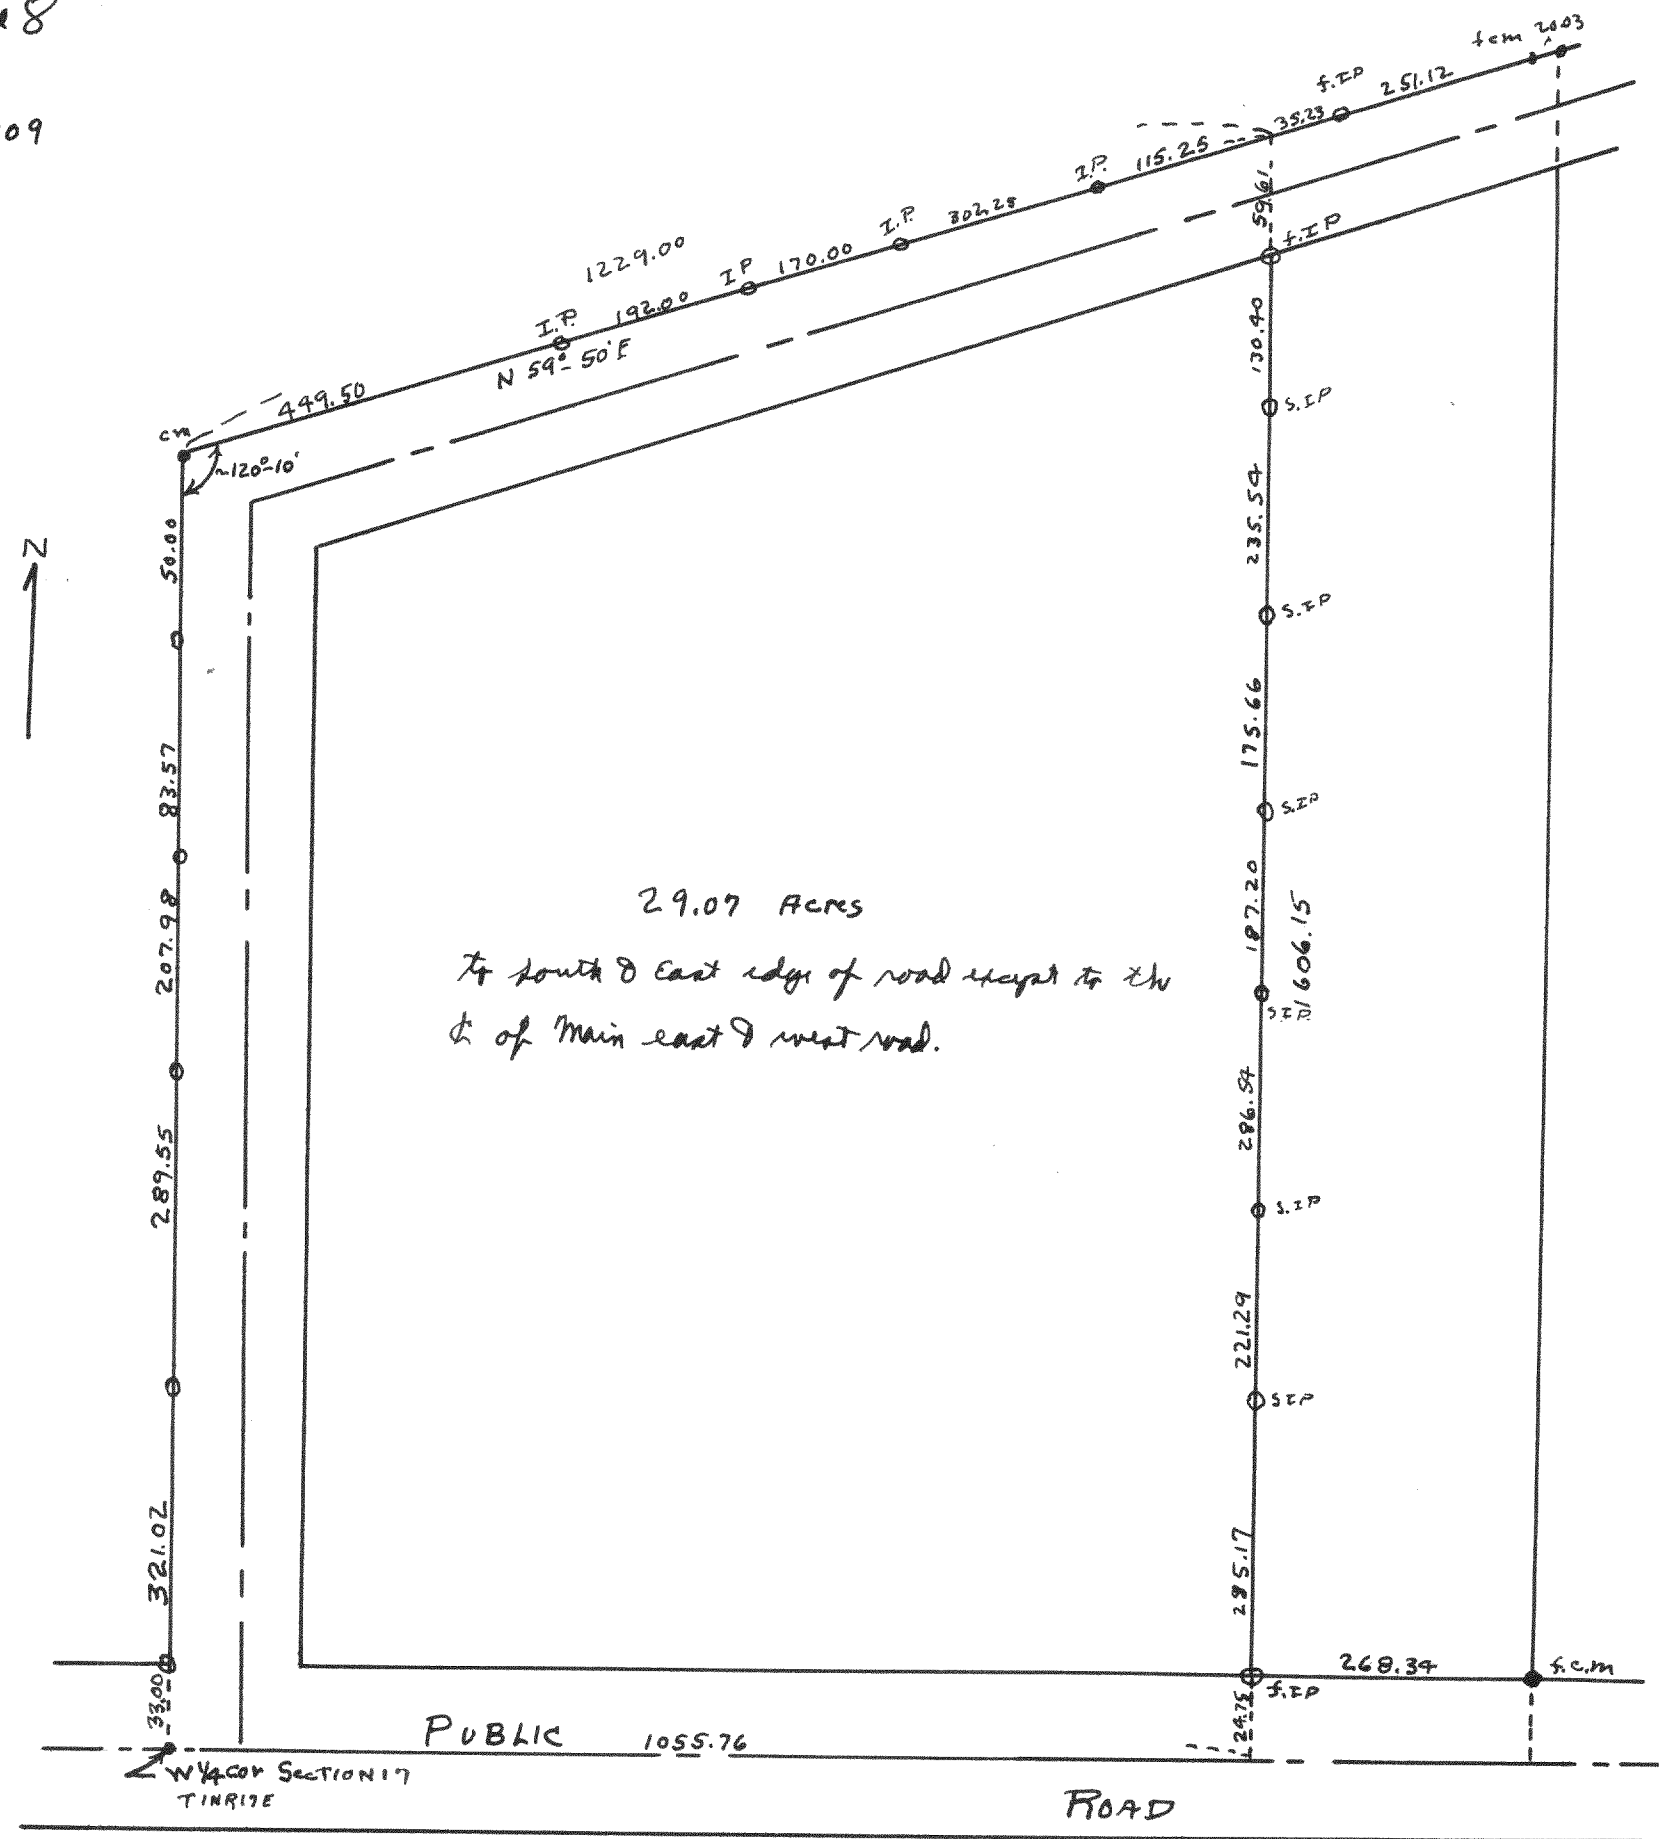

Plot of survey of a parcel of land located in the NW 1/4 of Section 17 T14N R17E of Walworth County Wisconsin
Dec 27, 1948
Lloyd S Jensen
County Surveyor
LSD

1910

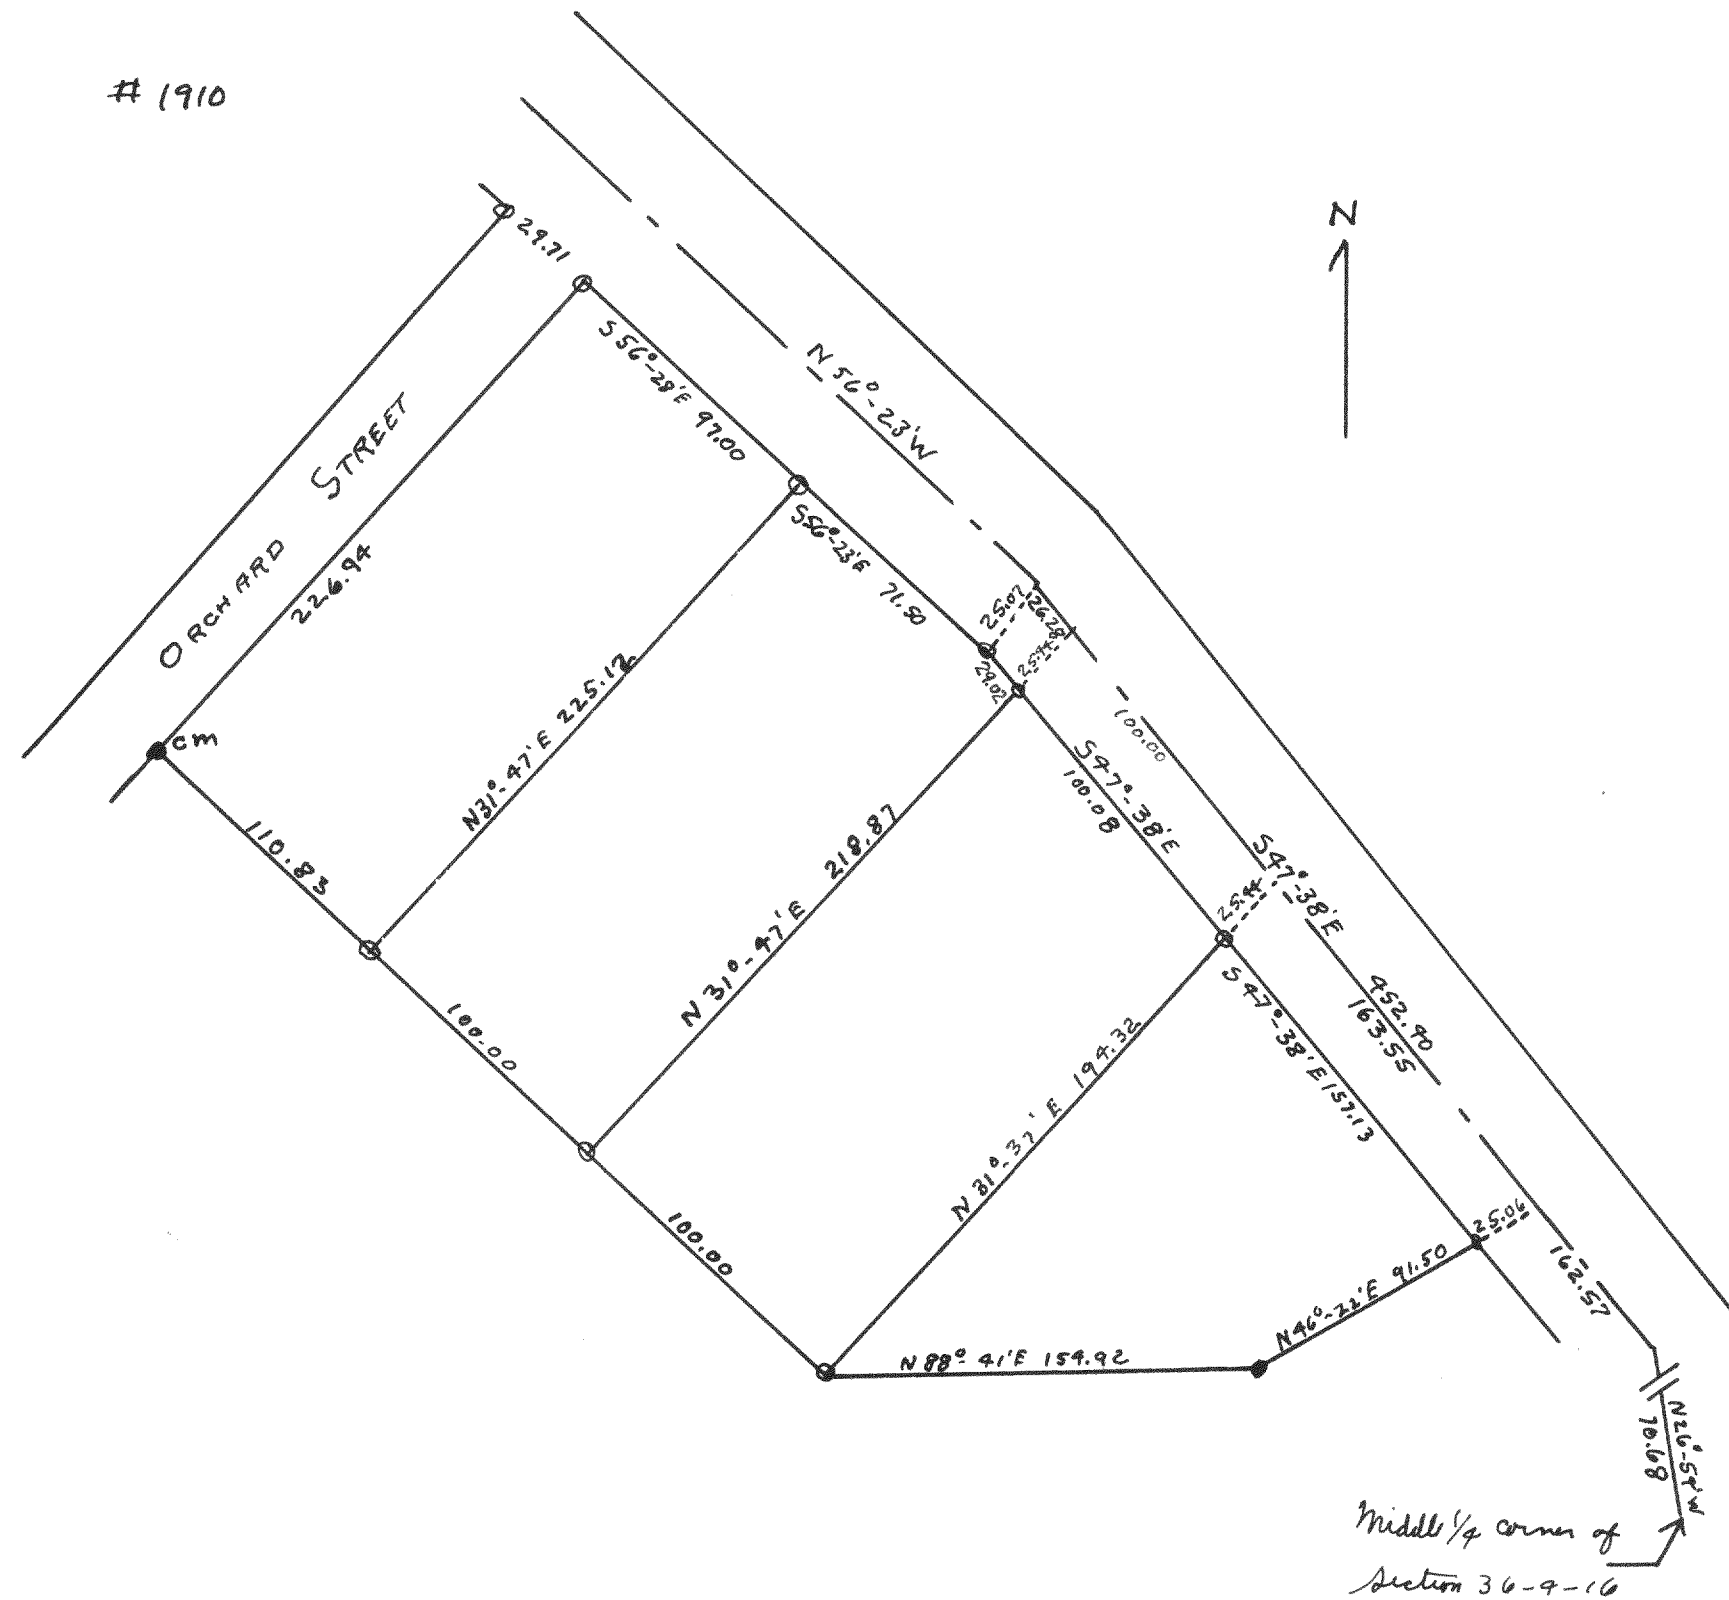

Plot of survey of land located in Section 36 T4N R16E of Walworth County, Wis
November 1948

Lloyd S Jensen
County Surveyor
LSD