


H 1911


N

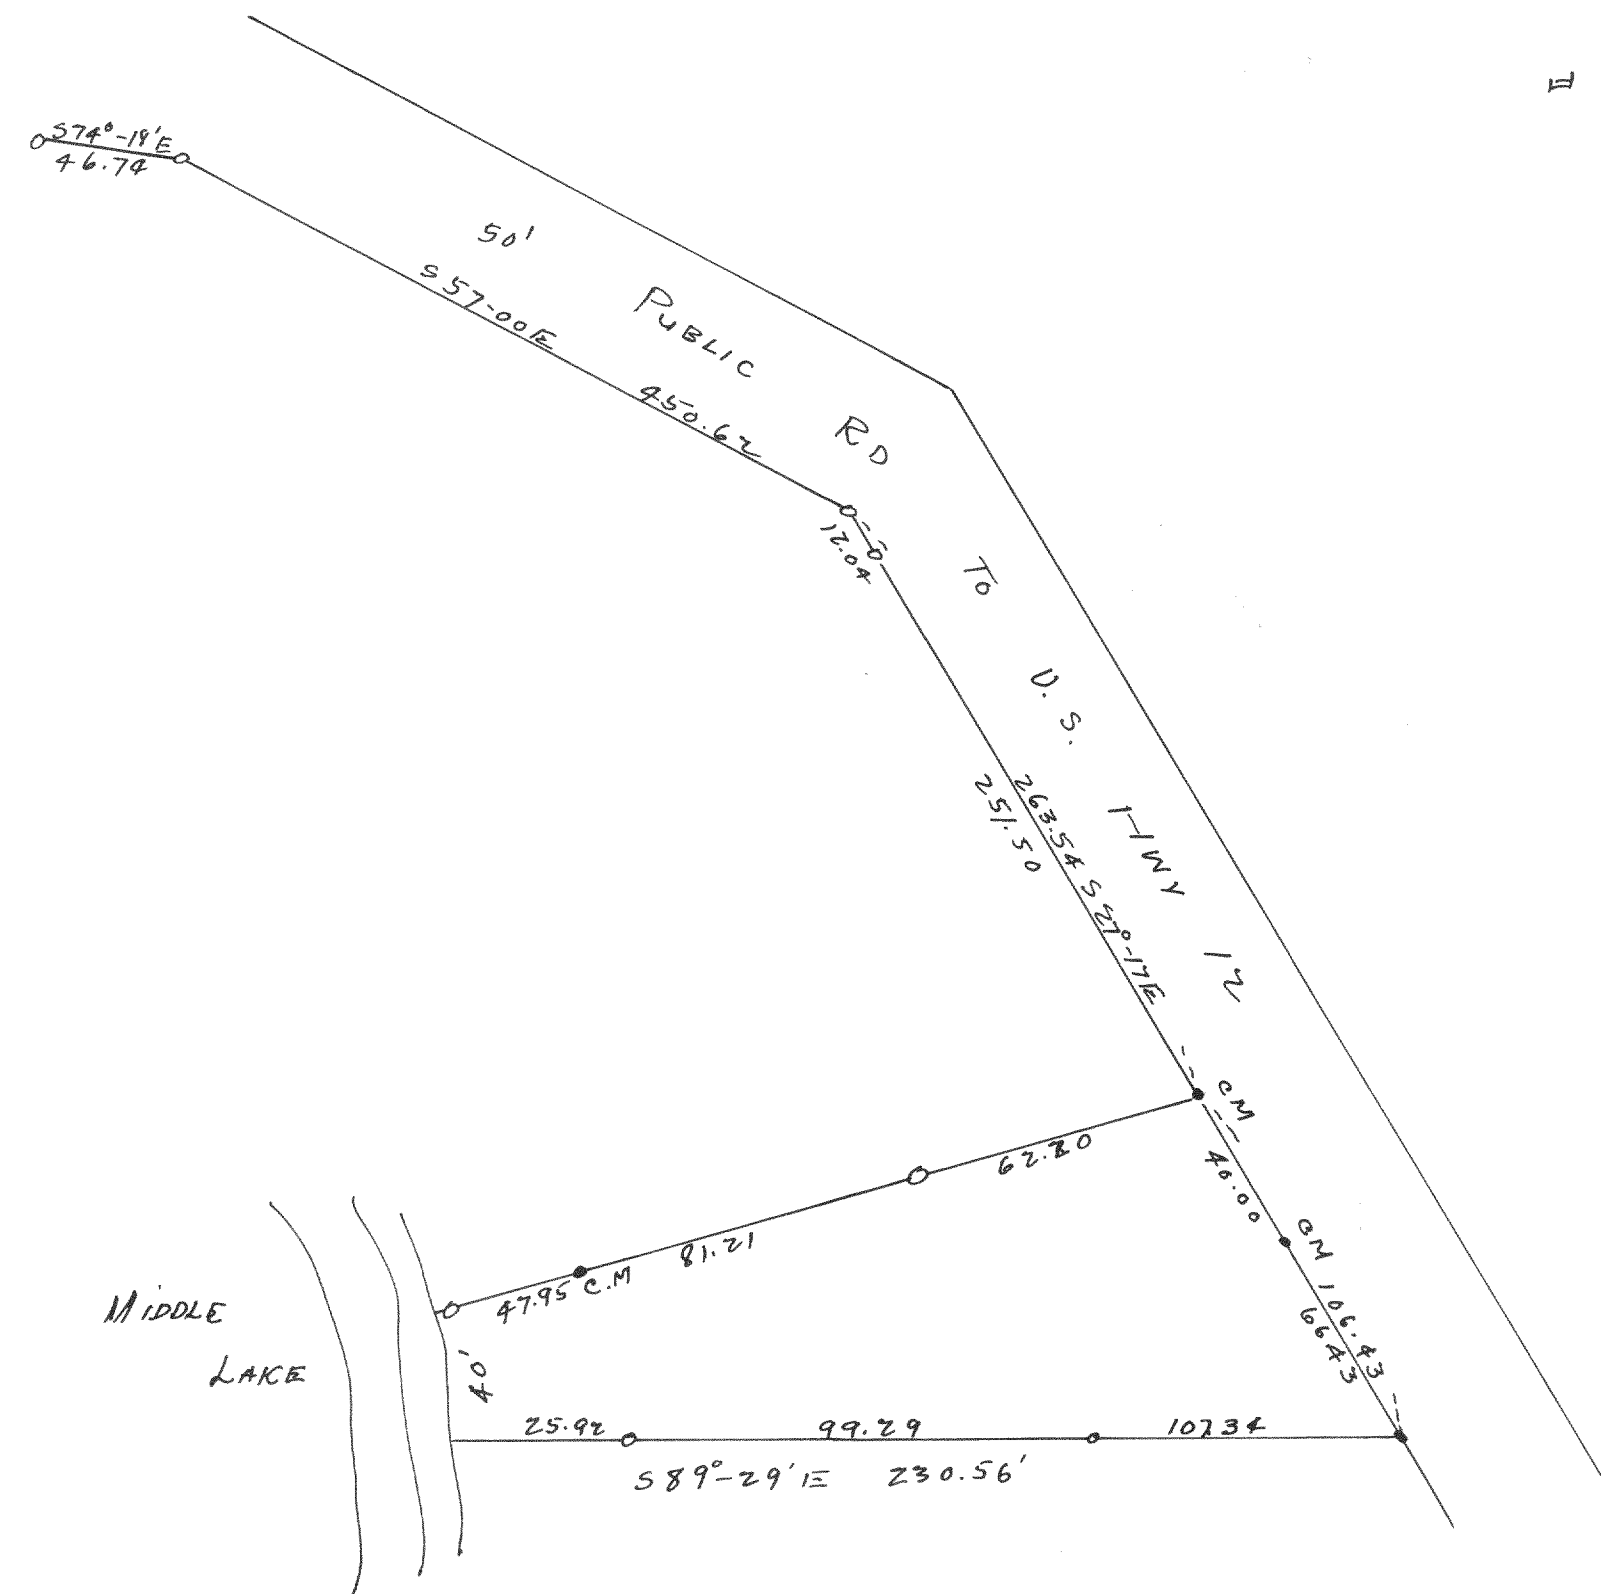

Plot of survey of land located in Government lot 4 being the $N \frac{1}{2}$ of the SW fractional $\frac{1}{4}$ of sec. 25 T4N R16E Walworth County Sept 10, 1948
Lloyd S. Jensen

H 1912

N

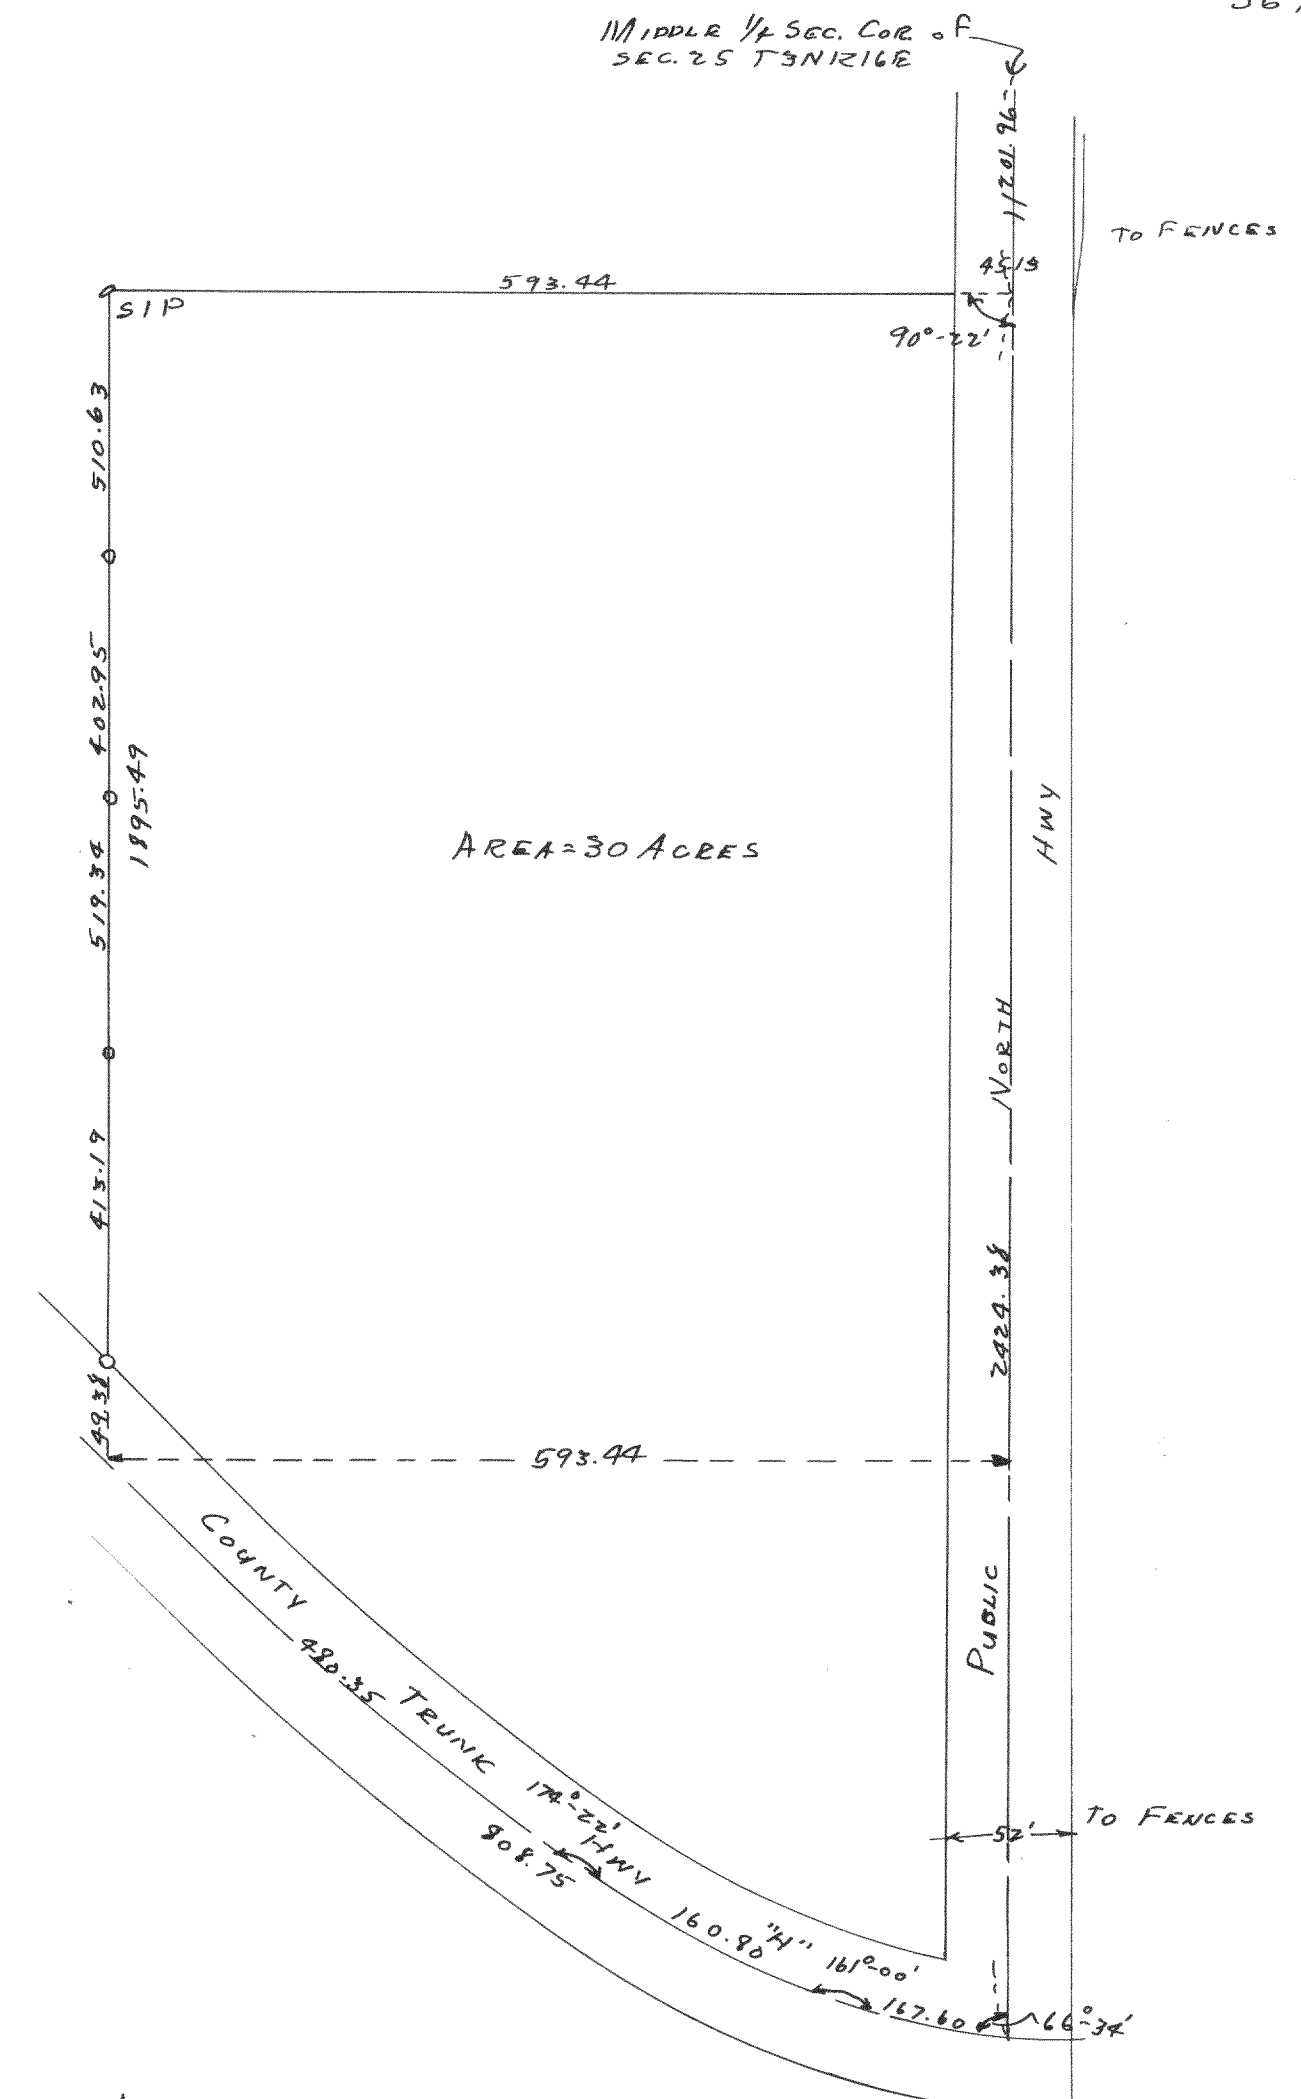

Plot of survey of a parcel of land located in the SW $\frac{1}{4}$ of section 25 T3N R16E Walworth County February 1948
Lloyd S. Jensen
civil.