


SURVEY NO. 1251

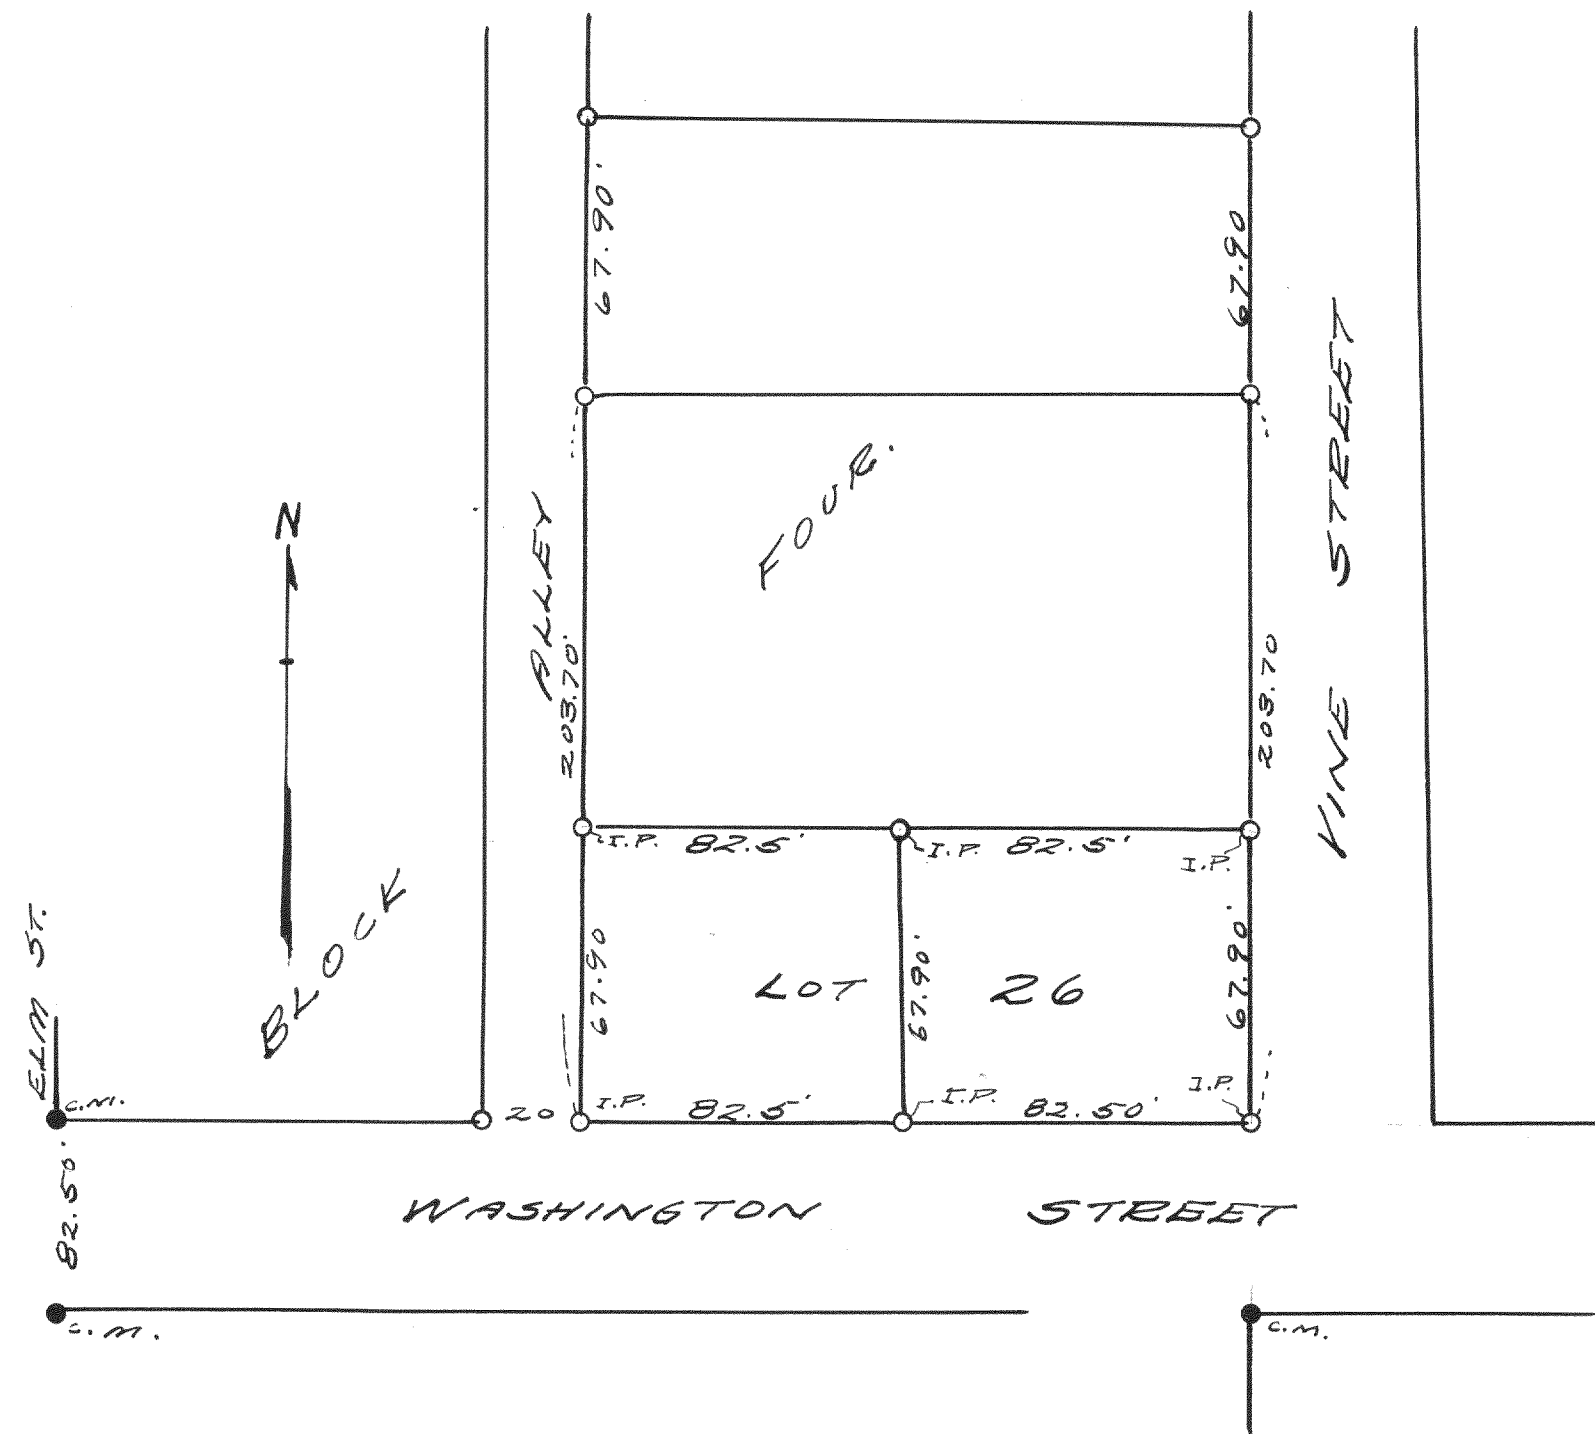


PLAT OF SURVEY OF THE EAST 82.5 FT. OF
LOT 26, BLOCK 4, OF F.K. PHOENIX' ADD. TO
THE CITY OF DELAVAN, WALWORTH COUNTY, WISC.

JUNE 9, 1941

Lloyd S. Jensen
K.E.J.

SURVEY NO. 1252

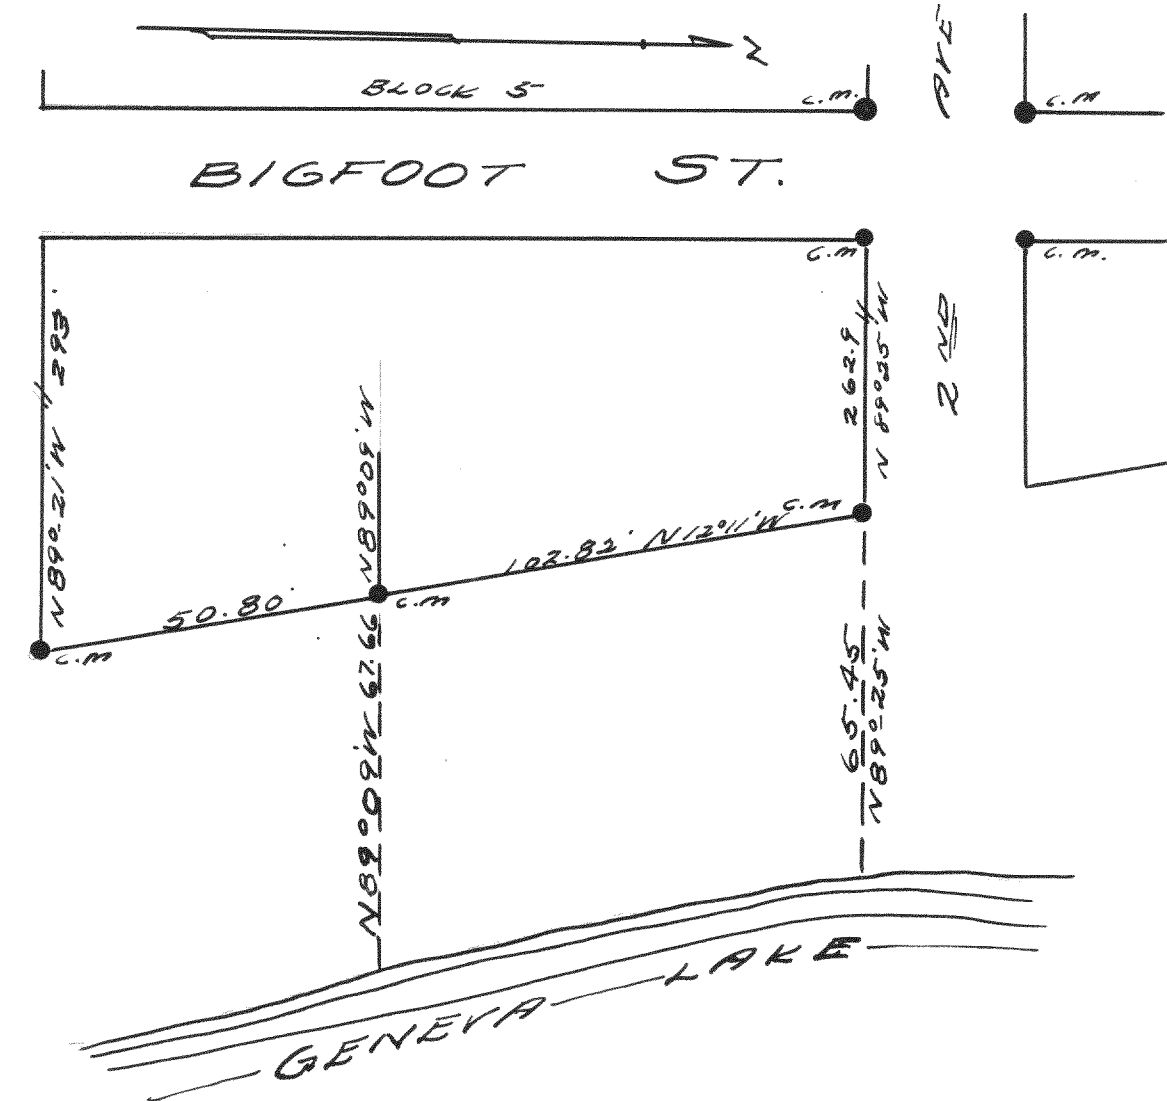

PLAT OF SURVEY OF LAND LOCATED
IN THE VILLAGE OF FONTANA-ON GENEVA
LAKE, WALWORTH COUNTY, WISCONSIN.
APRIL, 1941

Lloyd S. Jensen
K.E.J.