




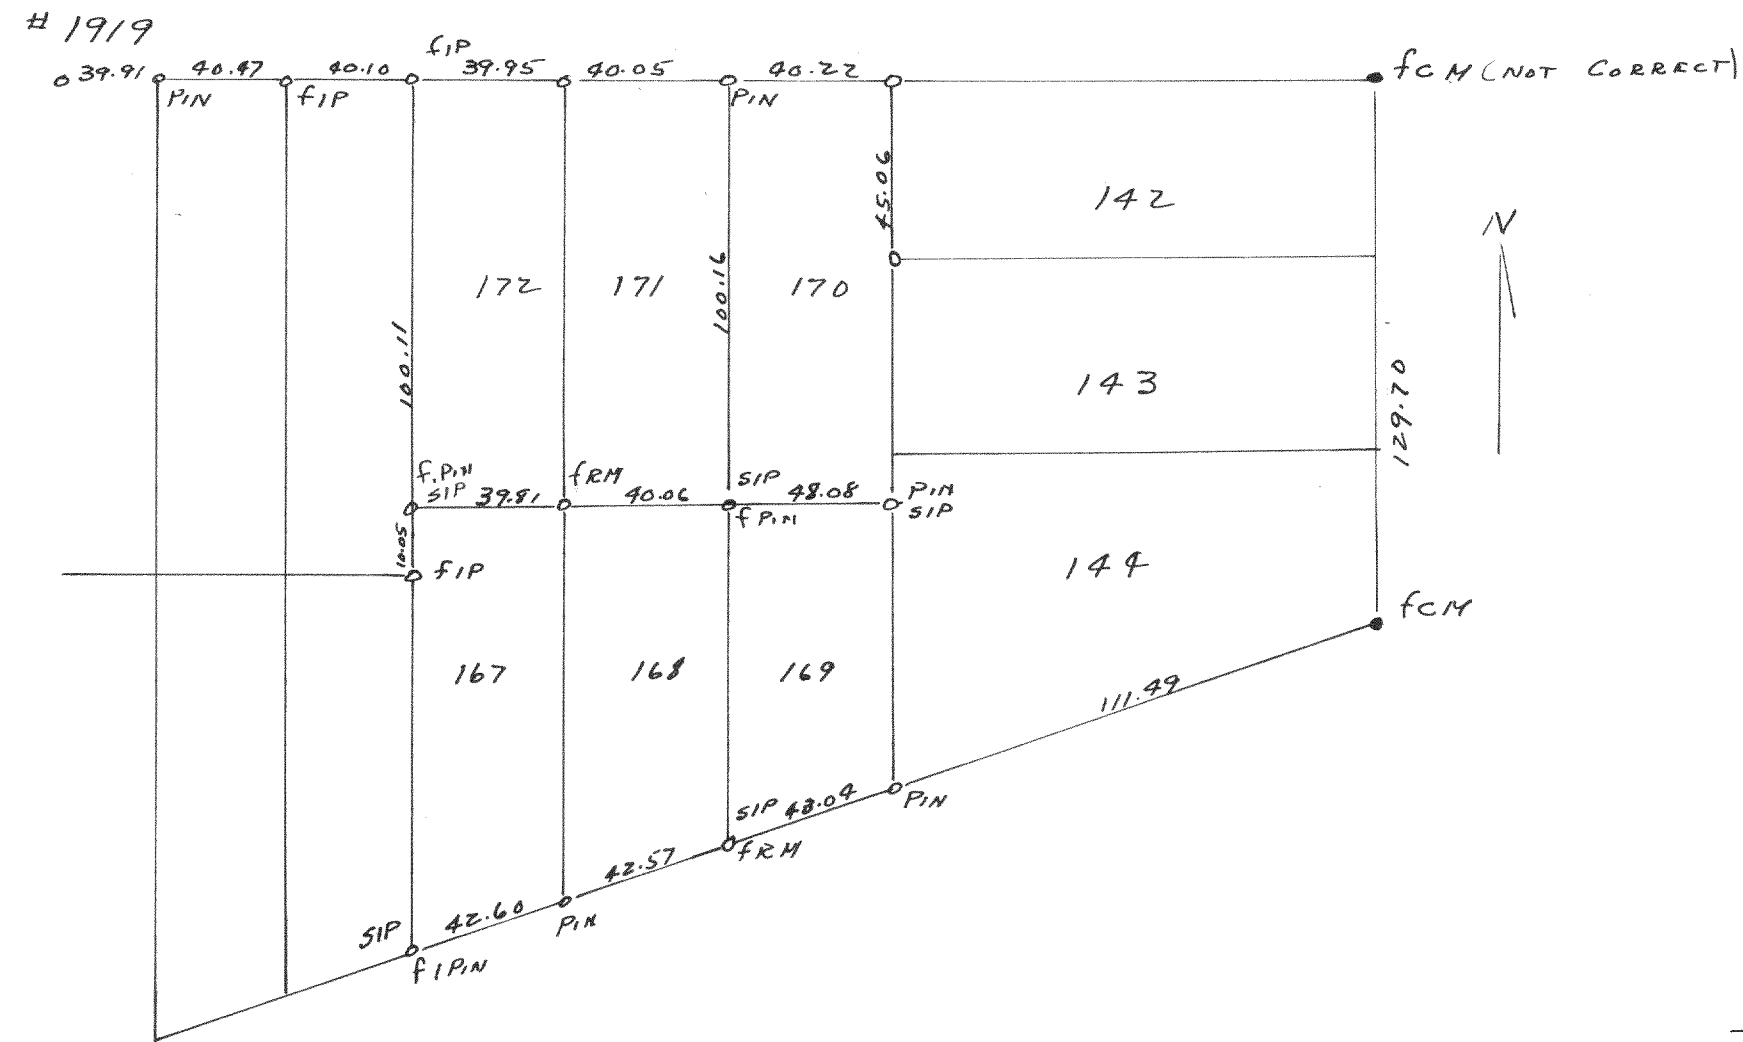

1920

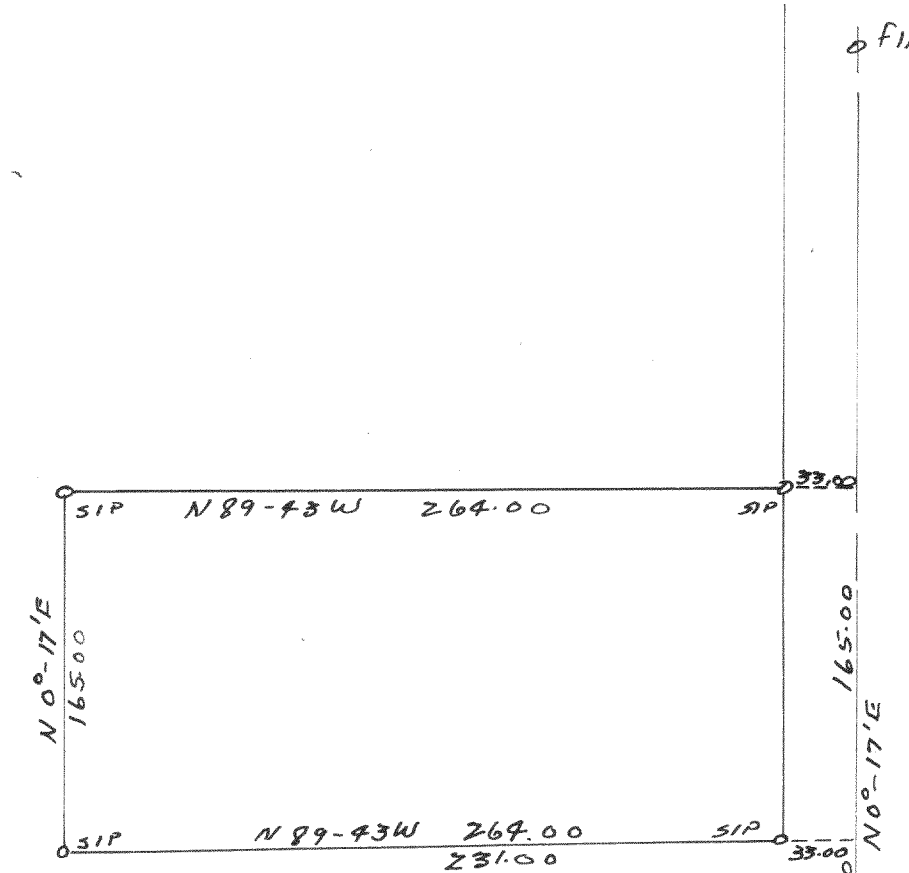

Plot of survey of lots 170-172, 167 & 168 in Krumhaar's
2nd Addition in Section 31 T2N R16E Walworth County.
July 2, 1948 Lloyd L. Jensen
CWS.

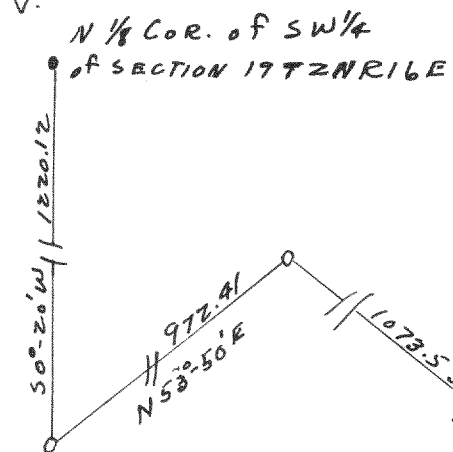

Plot of survey of parcels of land
located in Sec. 19, T2N R16E Walworth Co.
Sept. 1948 Lloyd L. Jensen
CWS.

