



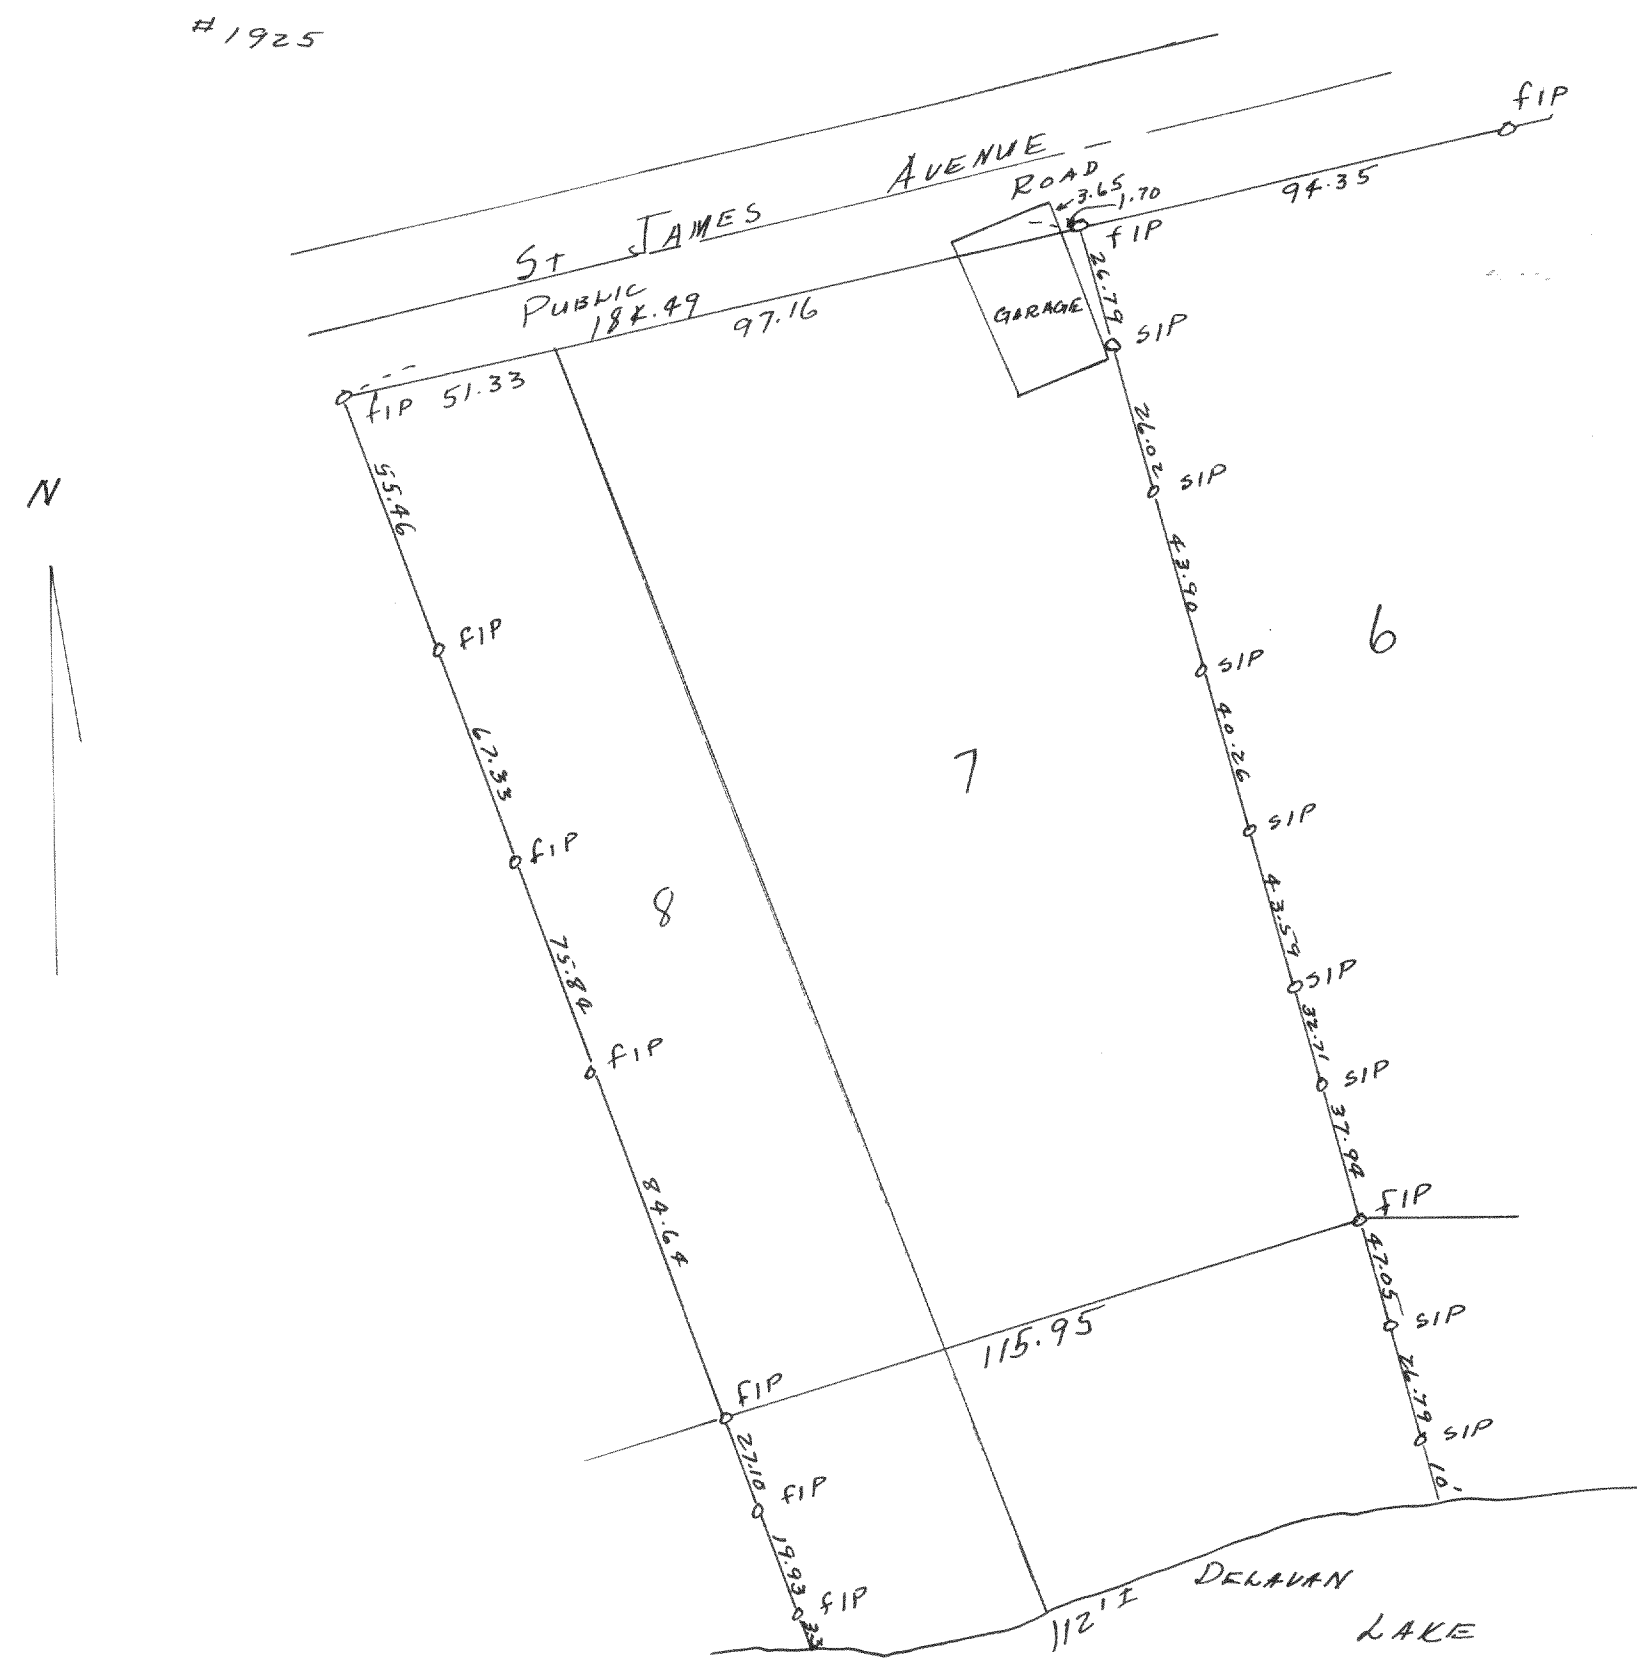

Plot of survey of lots 7 & 8 in St. Mary's Subdivision
located in section 28 T2N R16E Walworth County
Sept. 1948
Lloyd L. Jensen

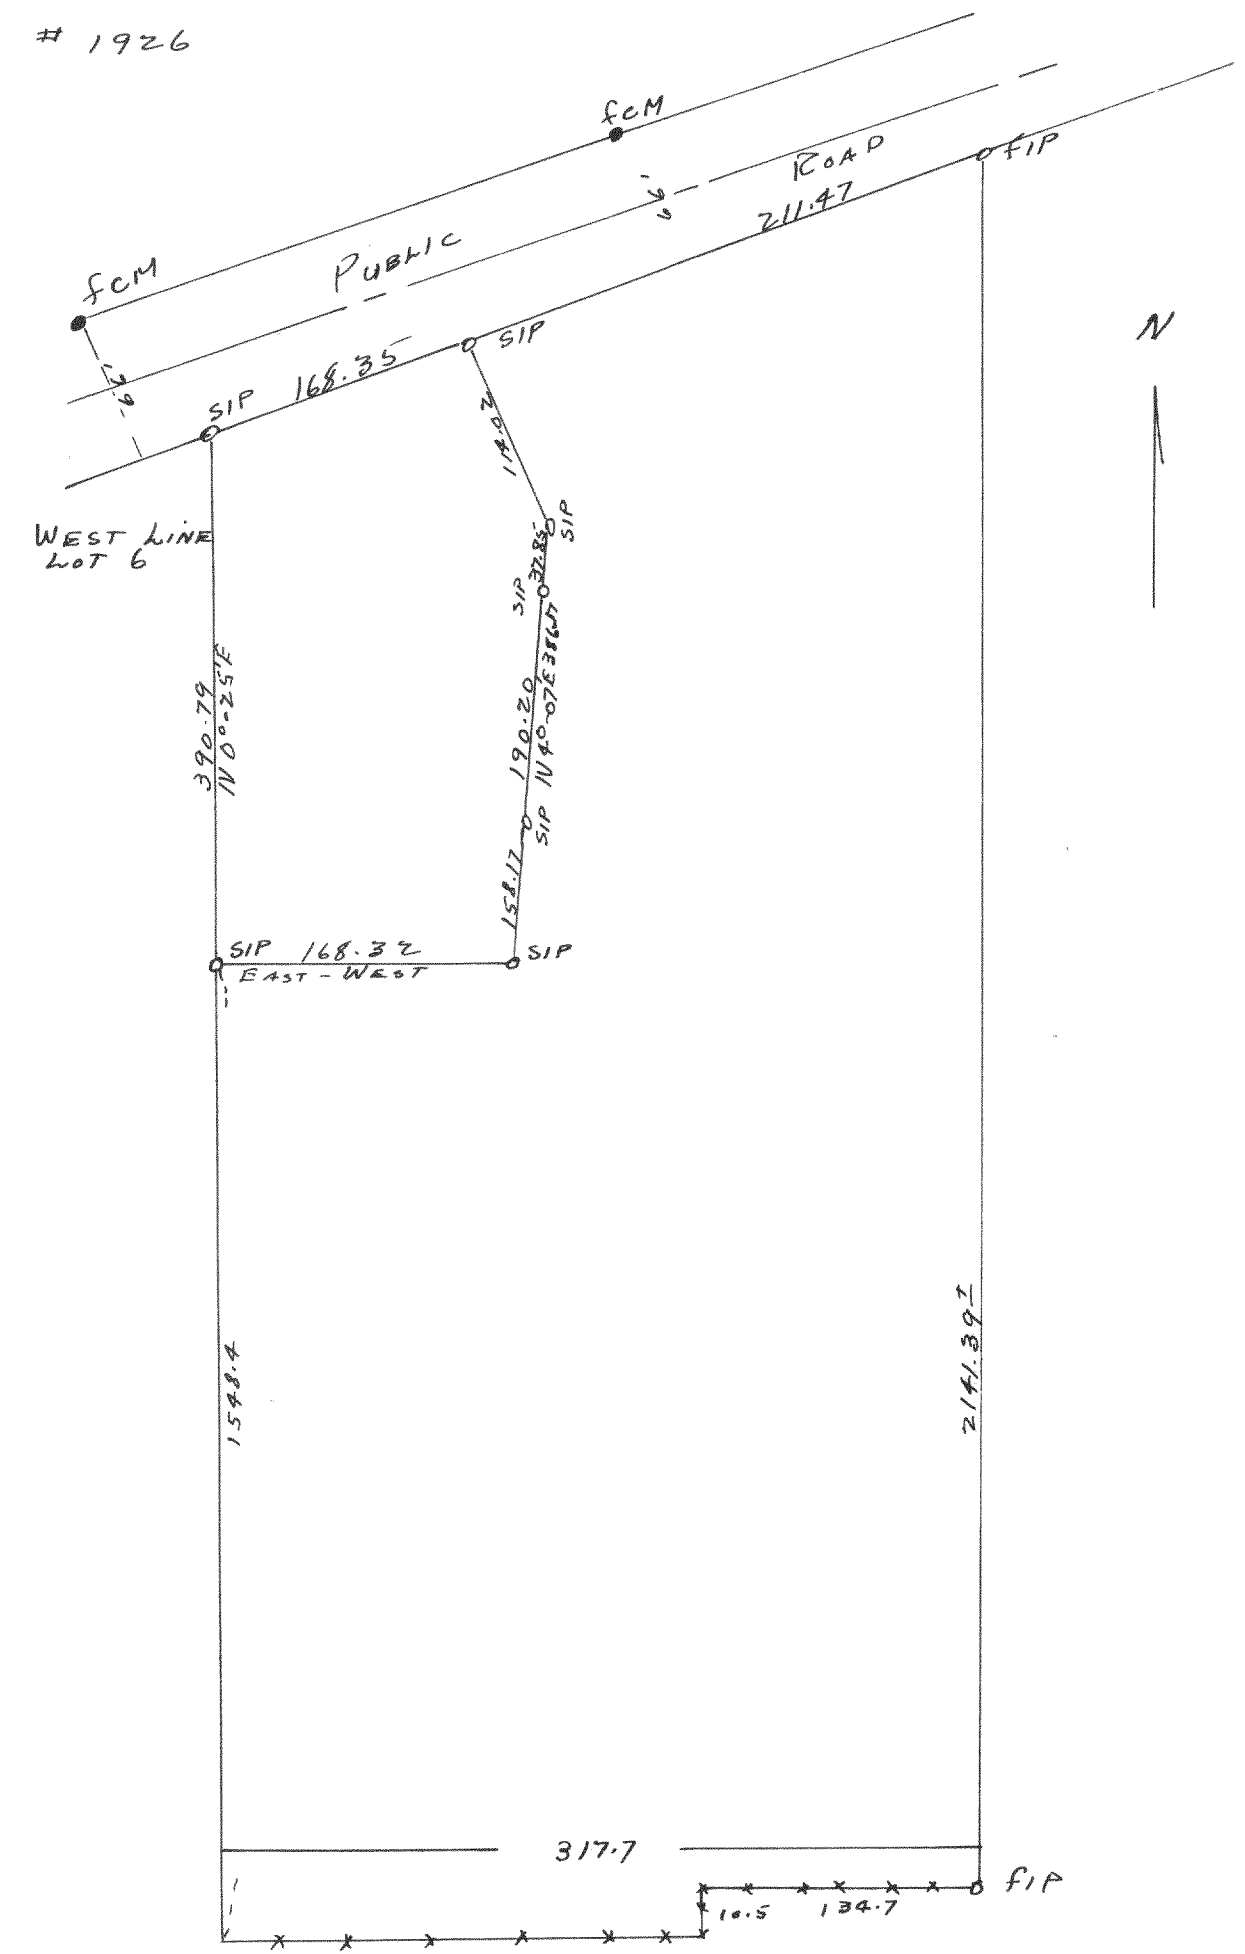

Plot of survey of parts of lot 6 & 1/2 lot 5 in The Subdivision
of the S.E. fractional 1/4 of section 28 and the N.E. fractional 1/4
of section 33 T2N R16E
Dec 1948
Lloyd L. Jensen
Cory.