



378

1927

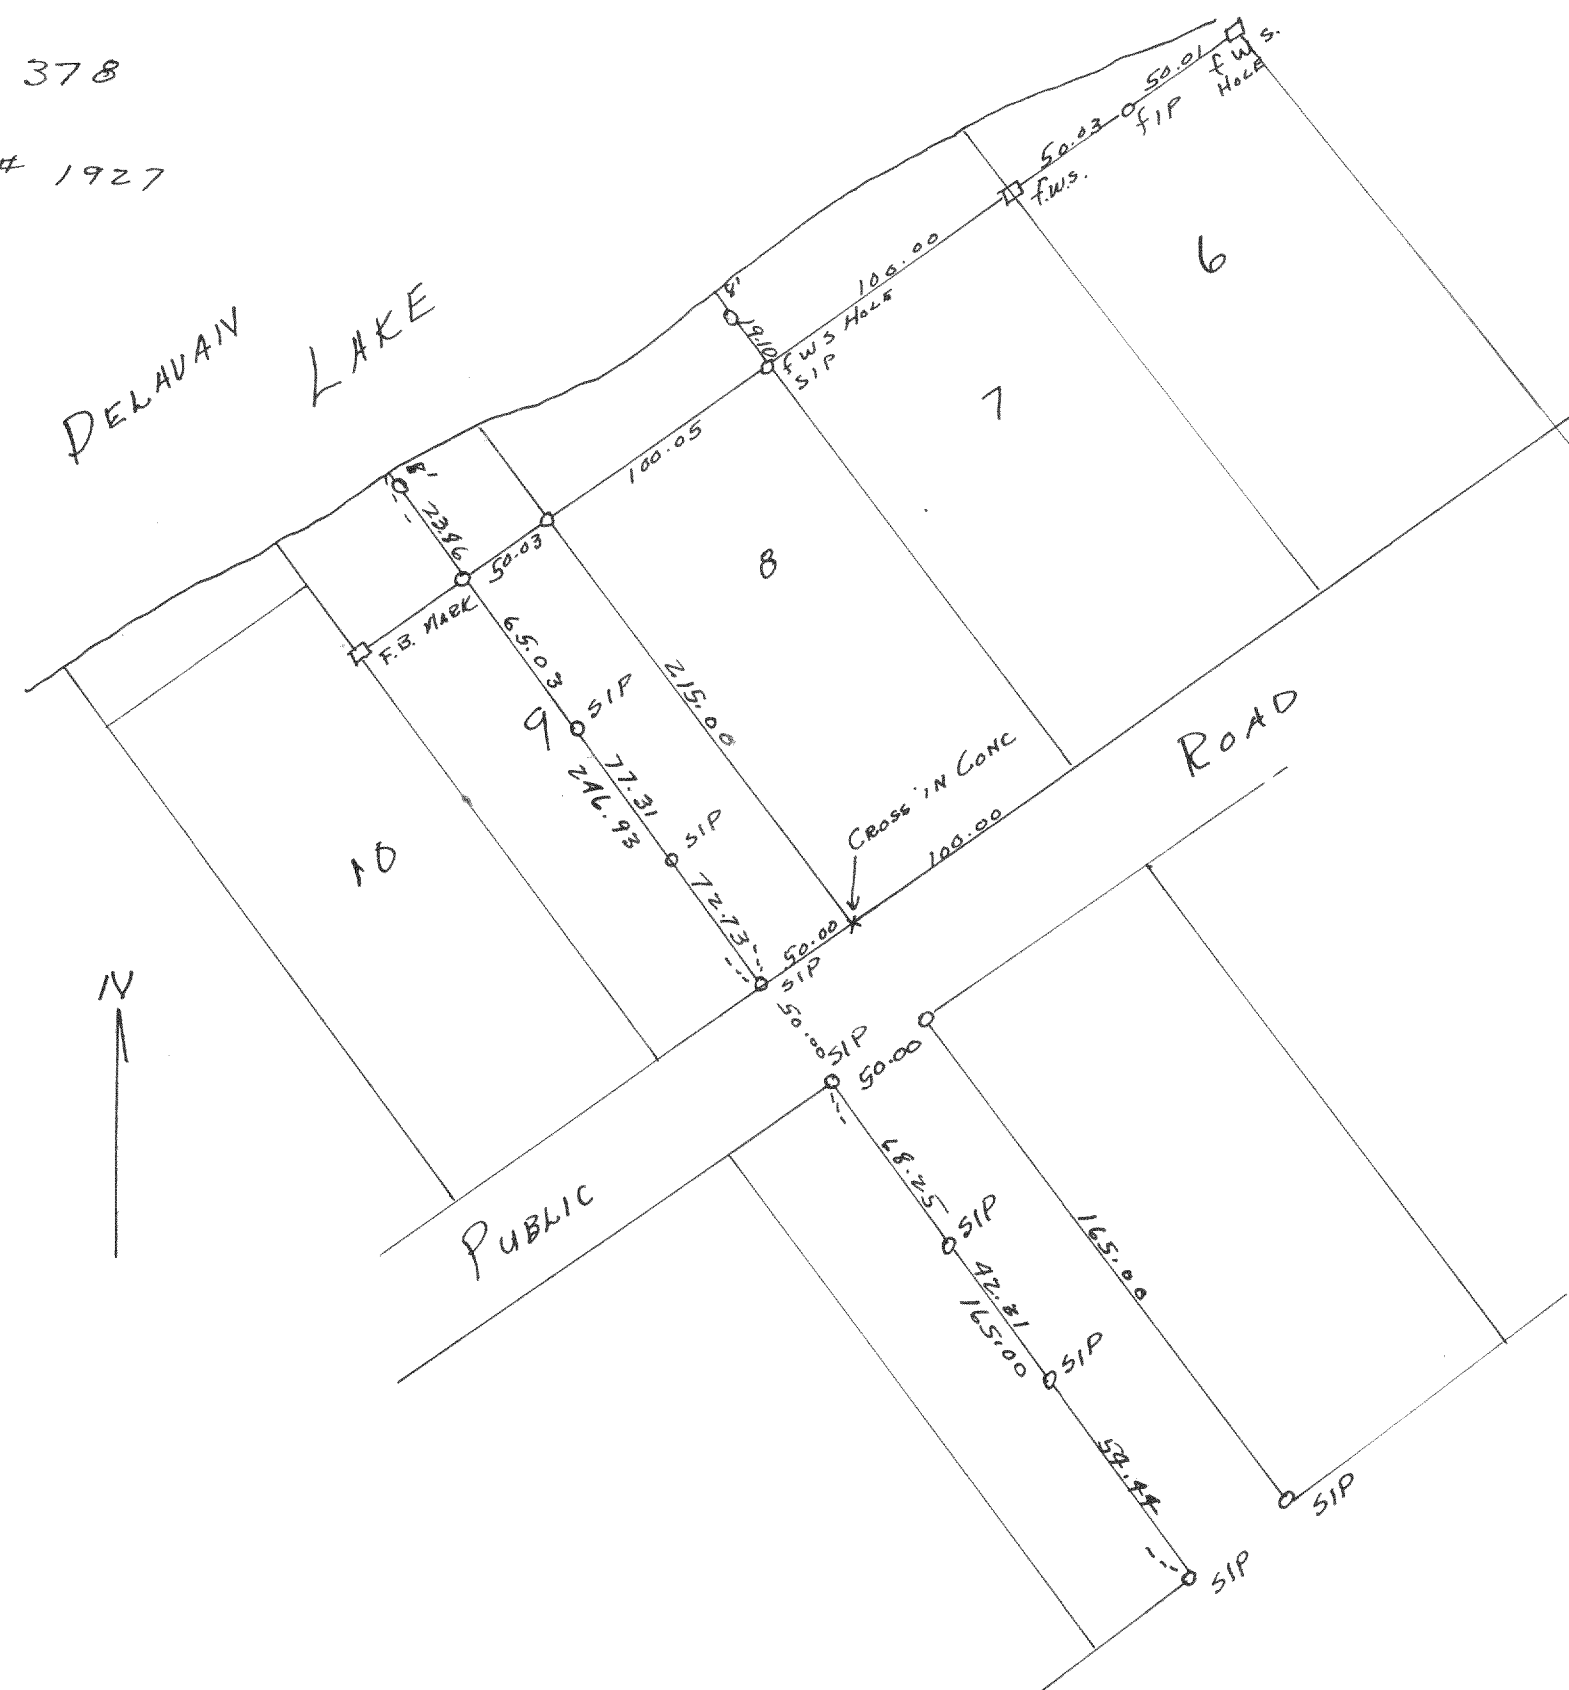

Plot of survey of the N. 1/2 of Lot 9 in Harrington's Subd
and parcels of unplatted land located in section 27, T2N R16E Walworth County
May 1948
Lloyd J. Jensen
CWS

1928

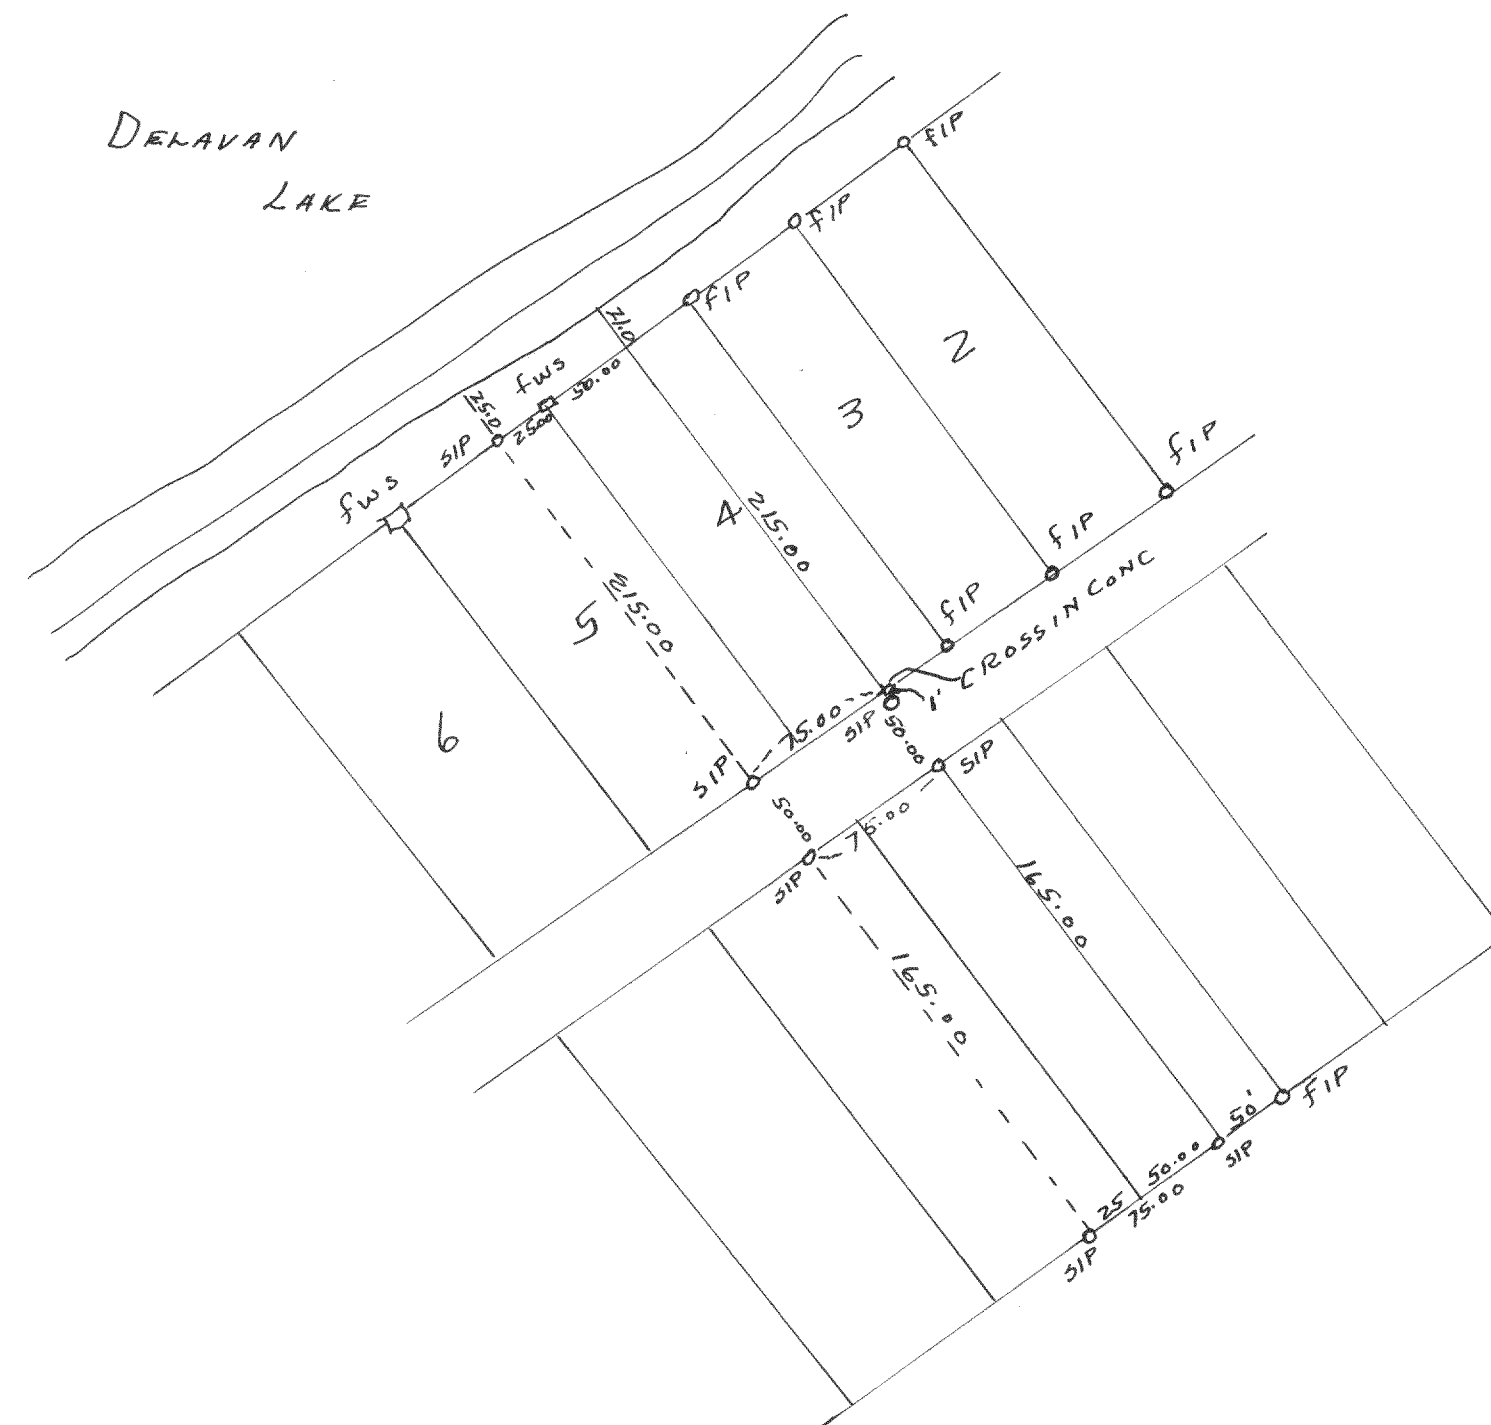

Plot of survey of the N.E 25' of Lot 5 and the southwesterly 1/2 of Lot 4
Harrington's Subdivision Section 27, T2N R16E Walworth County
July 1948
Lloyd J. Jensen
CWS