



1932

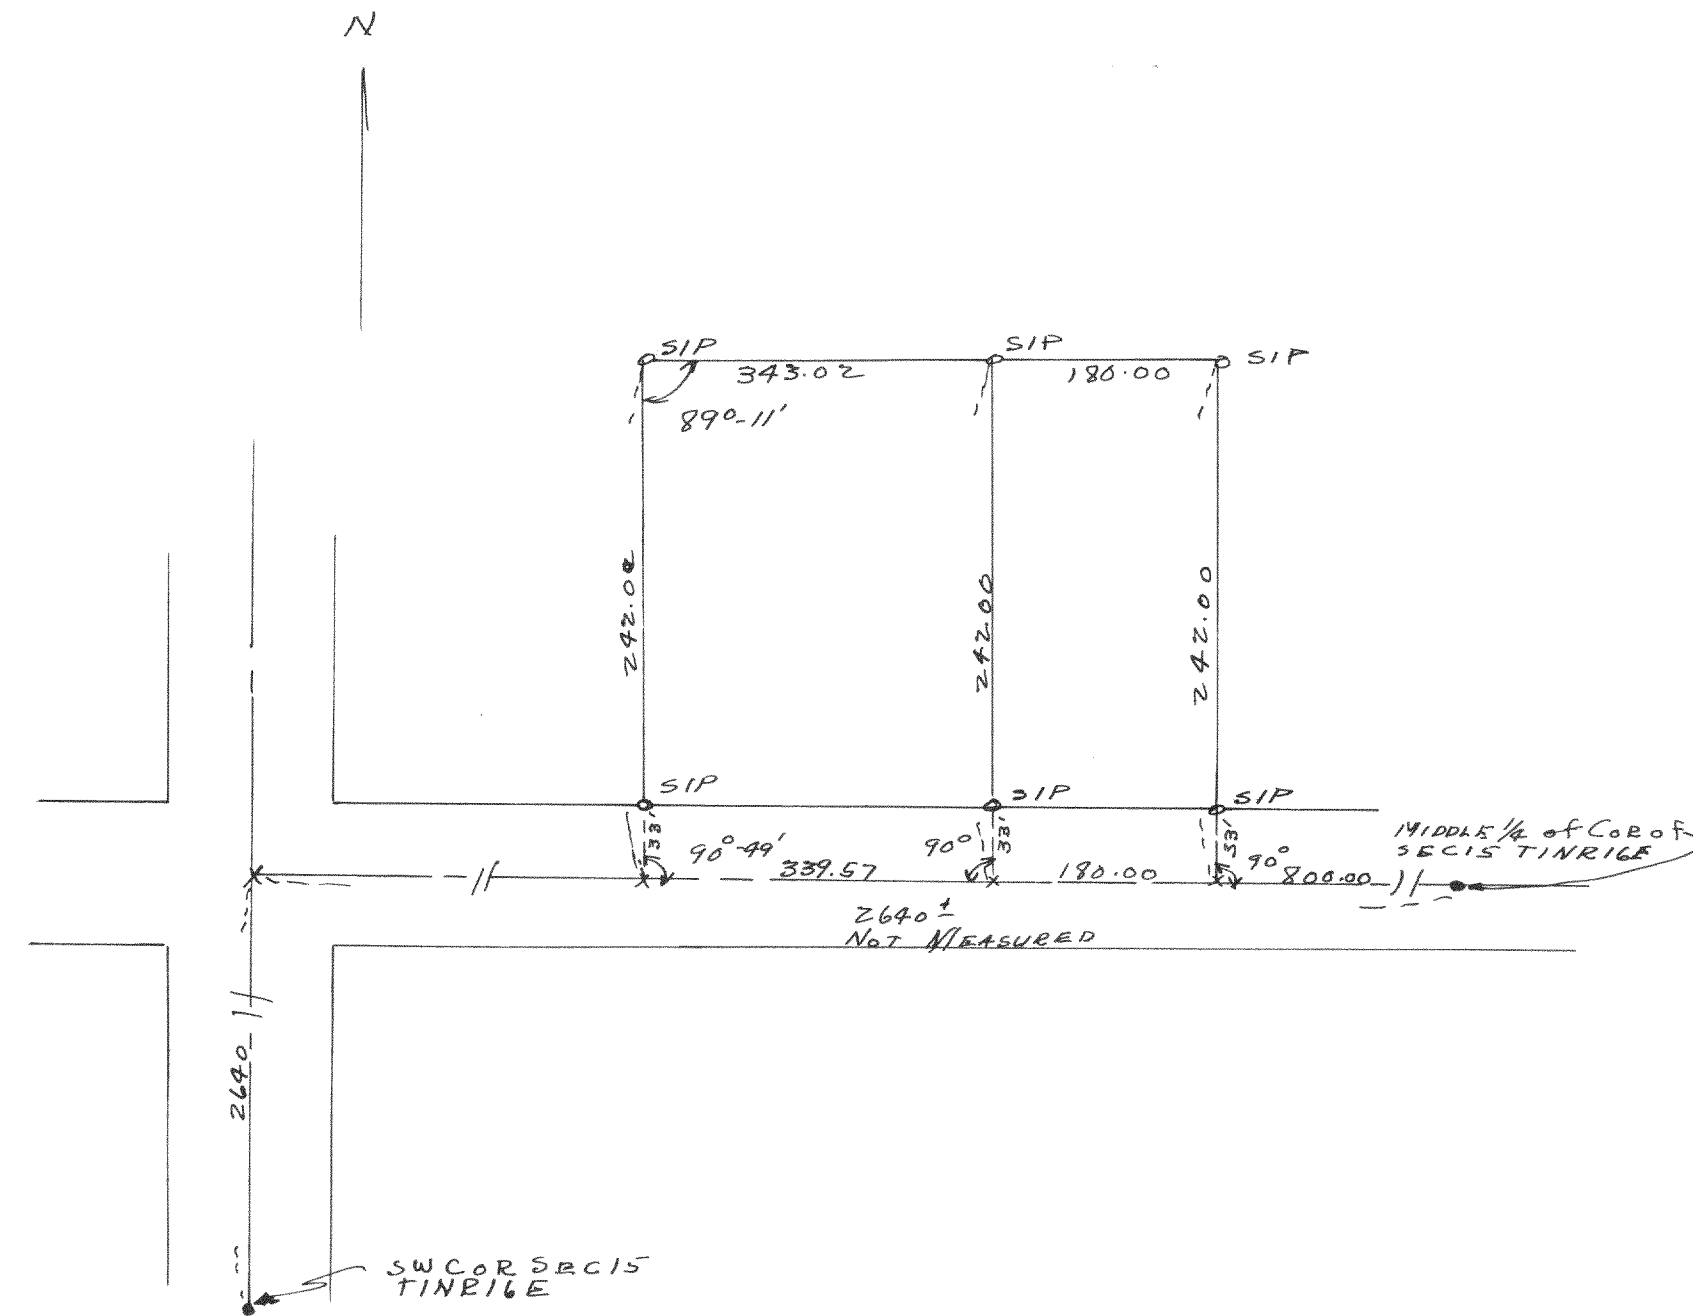

1933

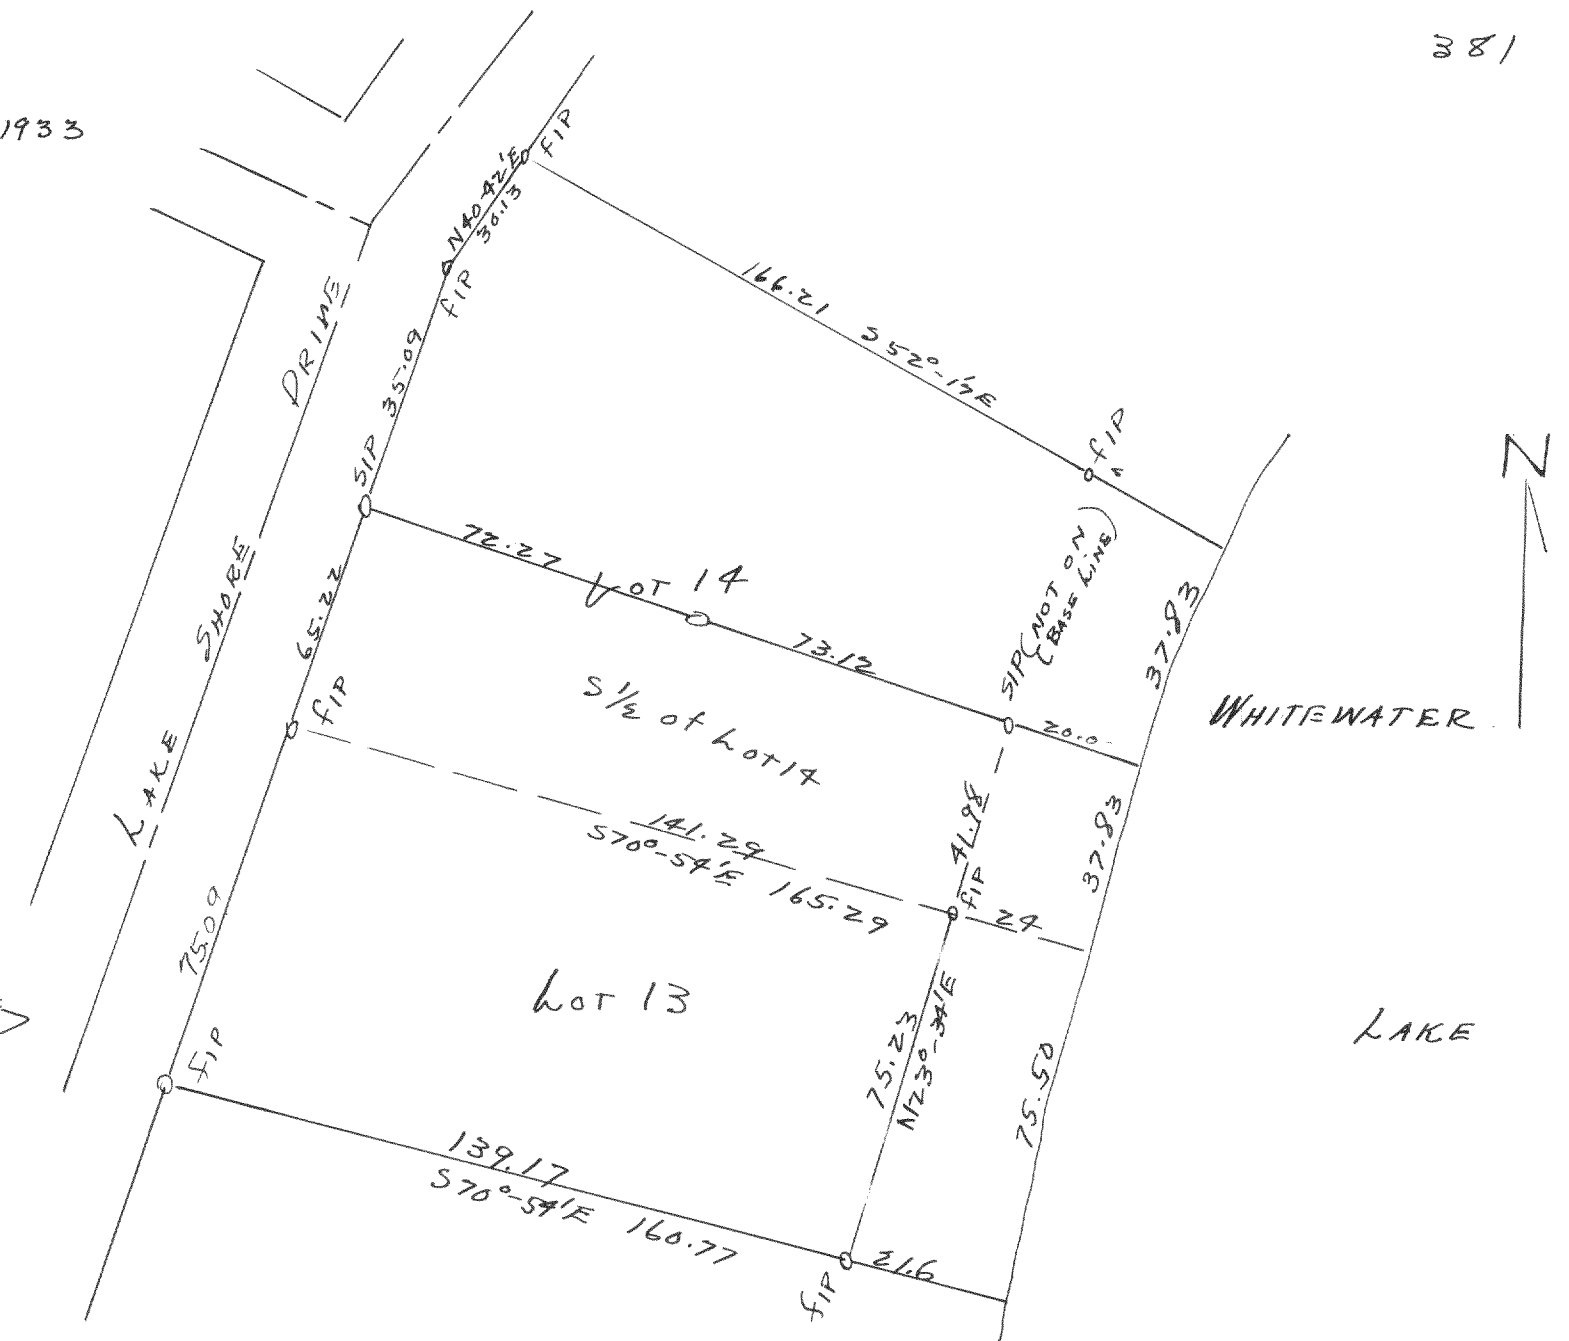

Plot of Survey of lot 13 + S. 1/2 of lot 14 Moraine Park Subdivision located in Sec. 34 T4N R15E Walworth County Oct. 17, 1948 Lloyd L. Jensen.