



# 1945

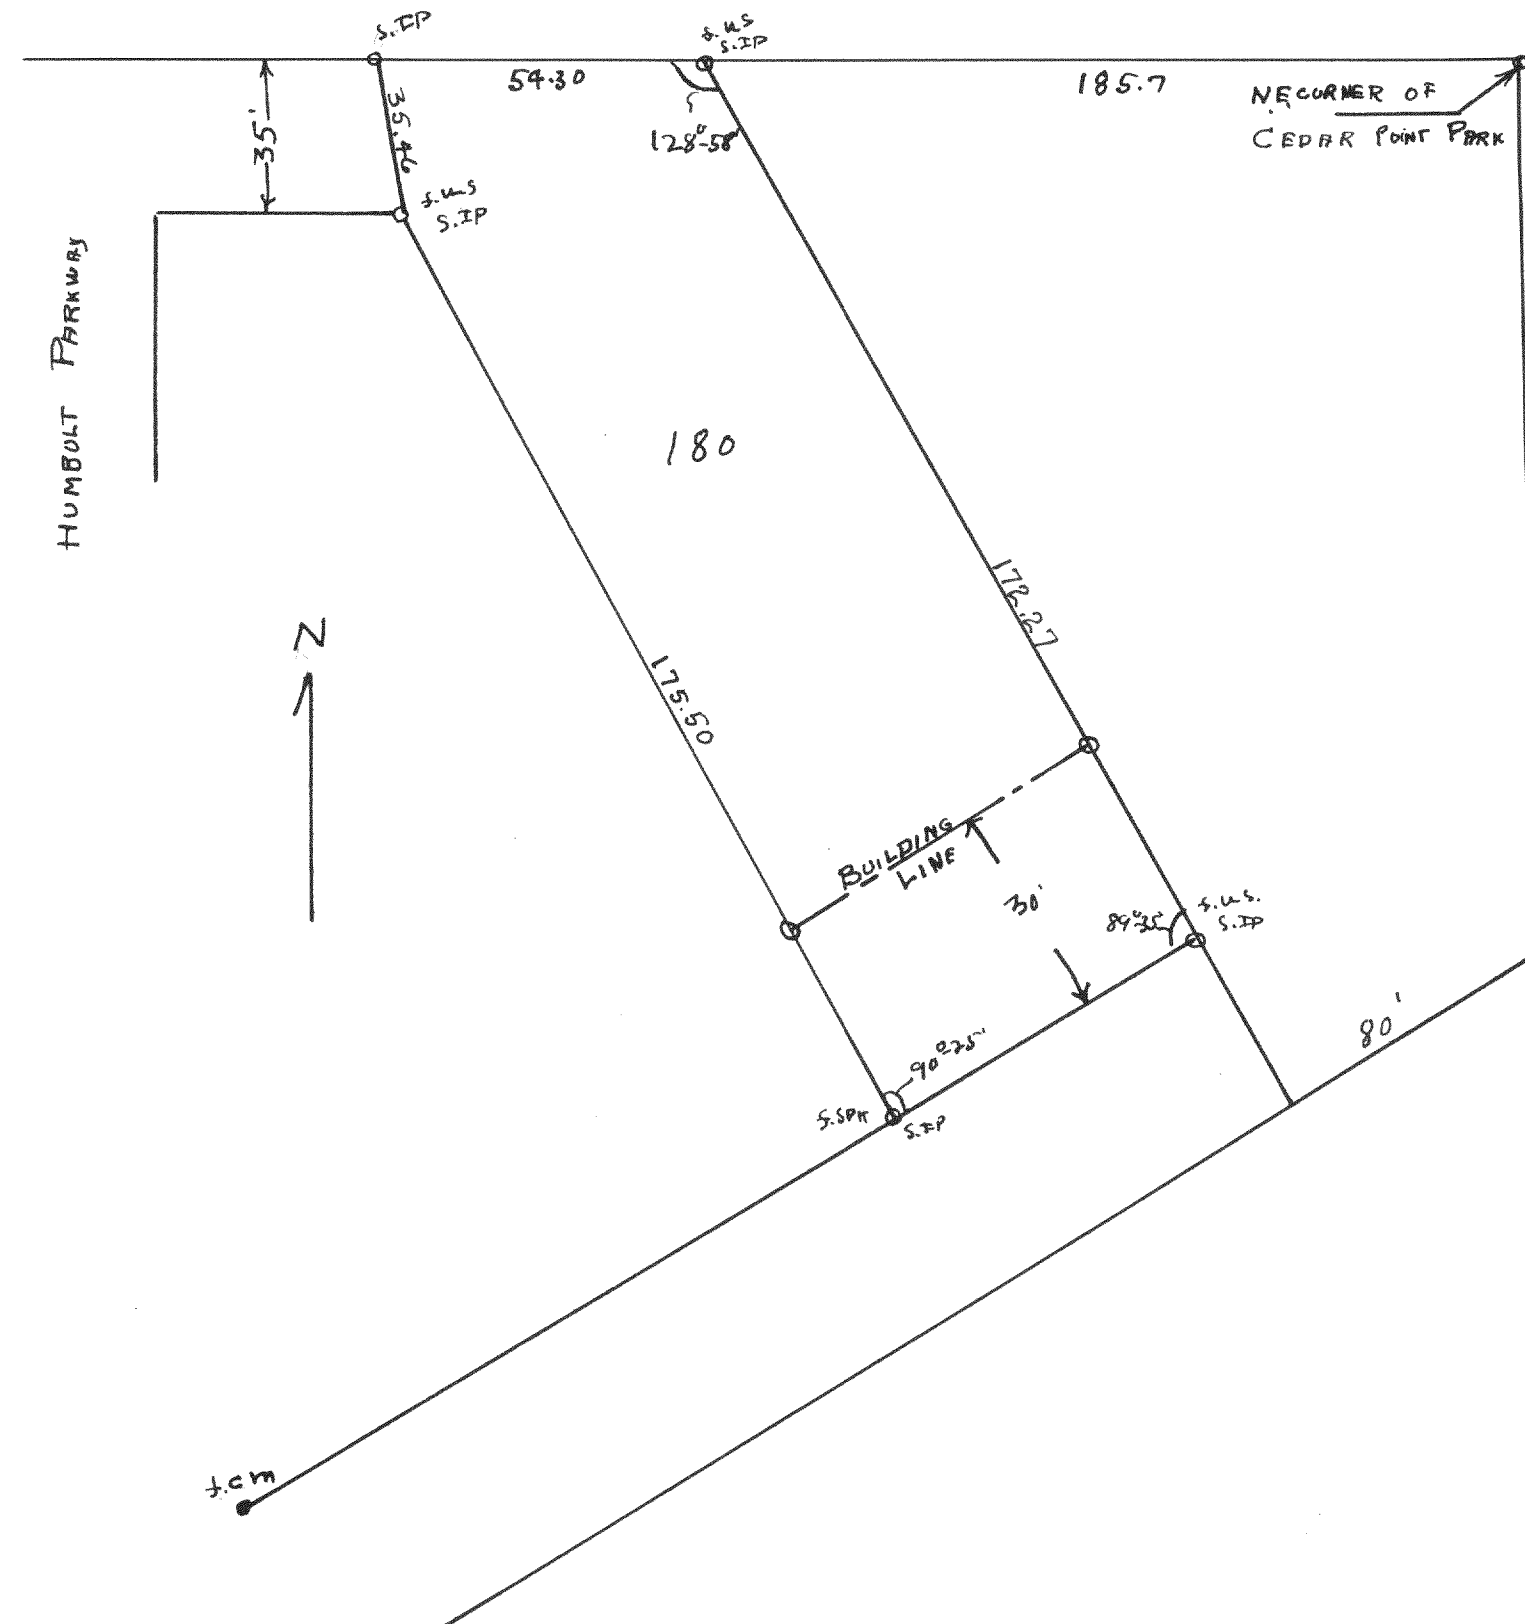

Plot of survey of Lot 180 Cedar Point Park Original Plot in the Village of Williams Bay  
November 18, 1998

Floyd & Jensen  
County Surveyor  
FJS

# 1946

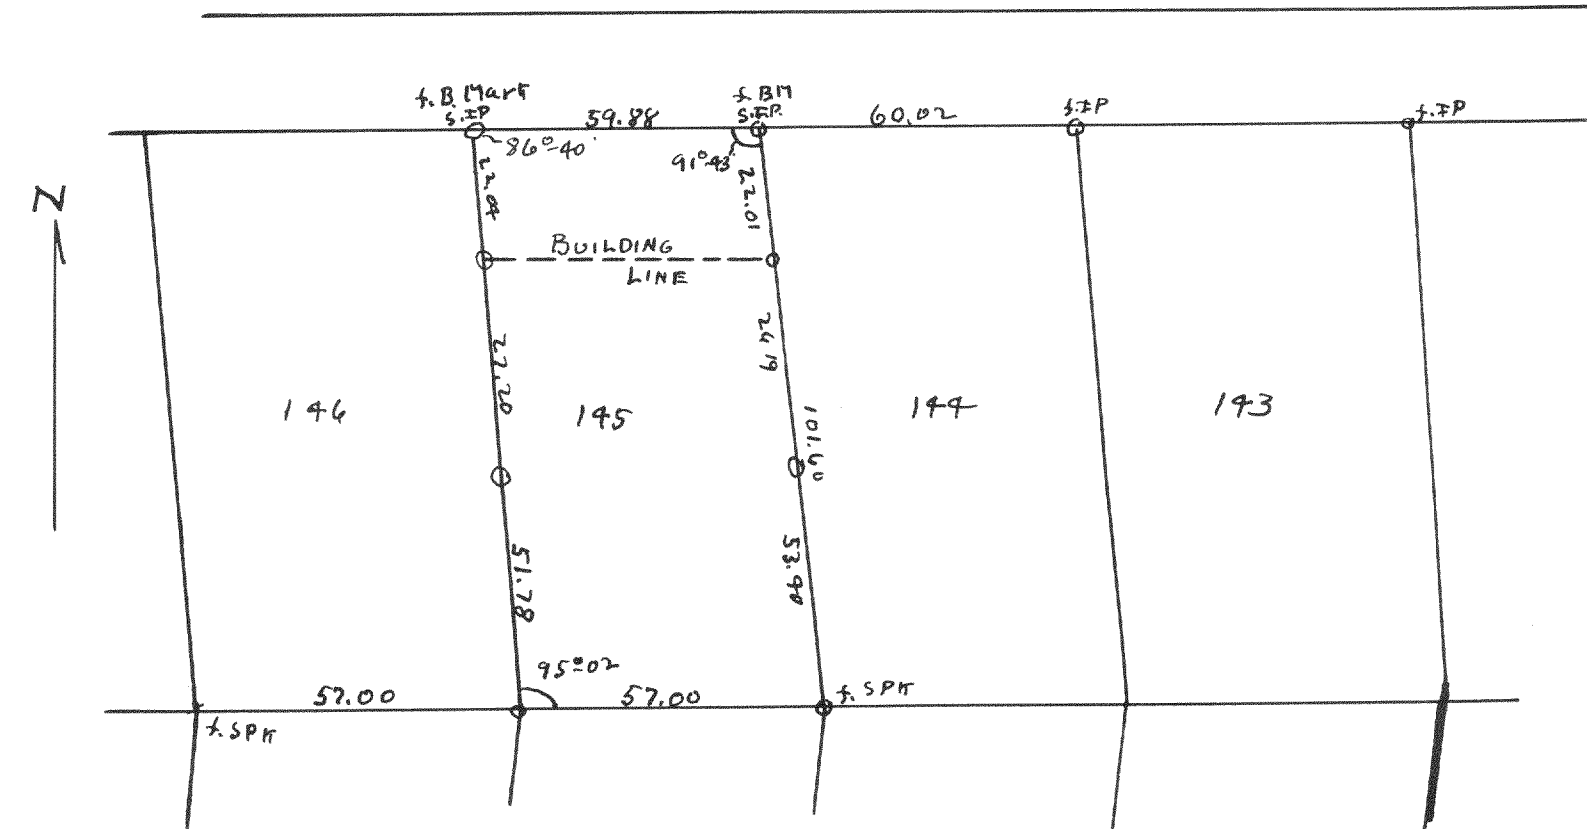

Plot of survey of lot 145 Cedar Point Park 2nd addition in the Village of Williams Bay, Walworth County, Wisconsin  
Sept 1998

Floyd & Jensen  
County Surveyor  
FJS