



1947

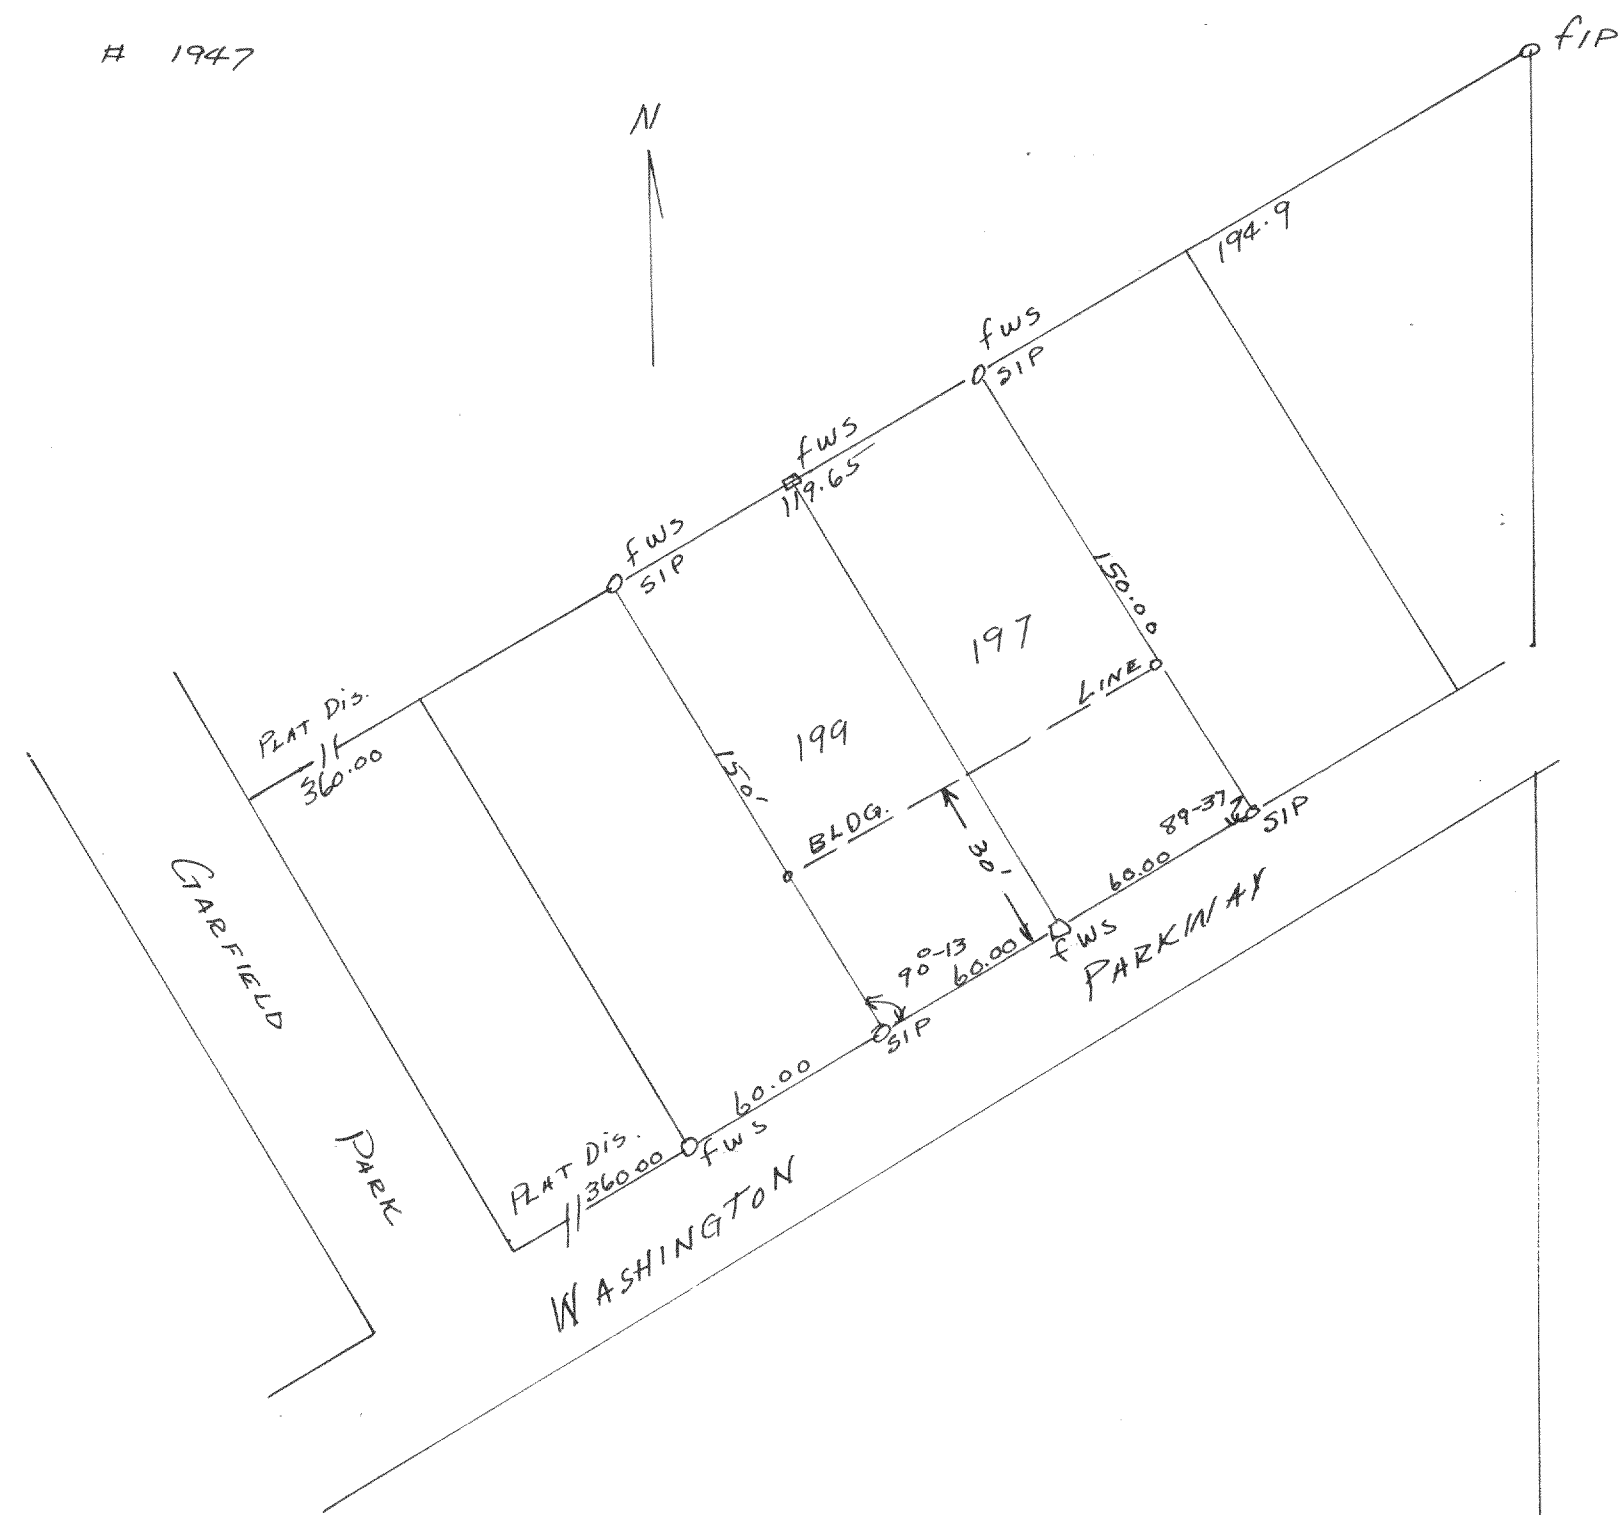

Plot of Survey of lots 197-199 of Cedar Point Park in the
Village of Williams Bay Waukesha County
Sept. 1948
Lloyd T. Jensen
Chg

1948

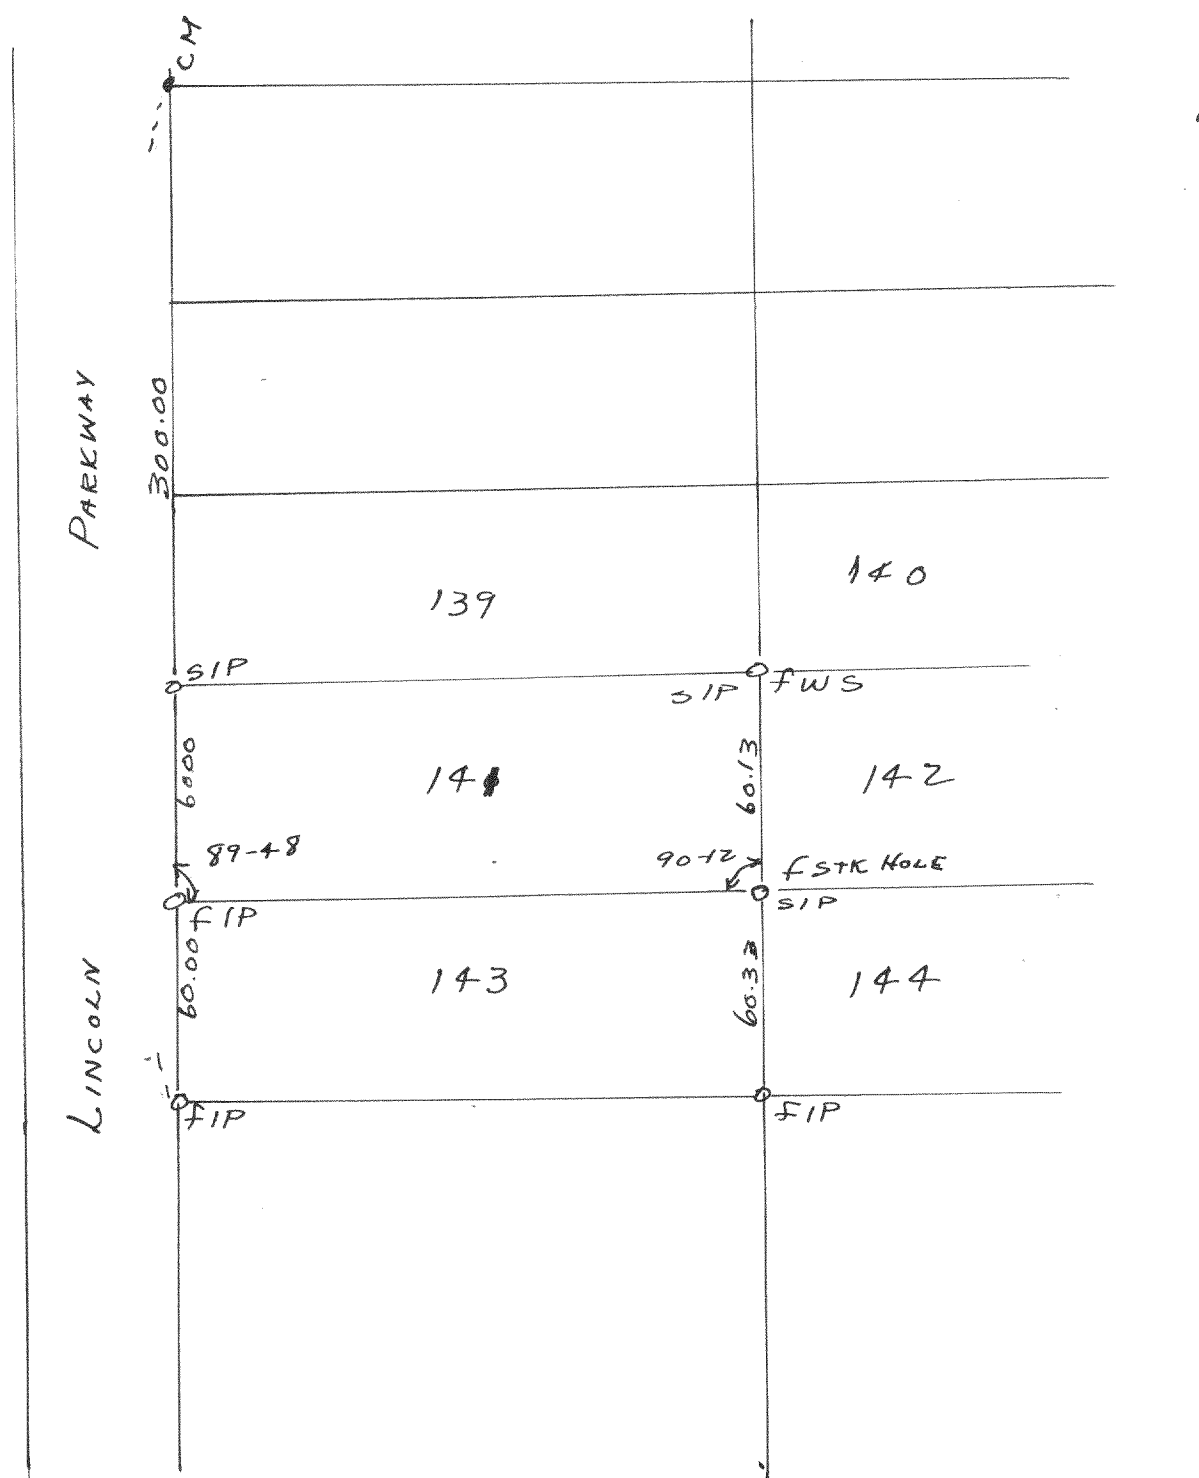

Plot of Survey of lot 141 Cedar Point Park in the
Village of Wilhoits Bay Walworth County
Oct. 1948
Lloyd L. Jensen
C.W.E.