


SURVEY NO. 1254

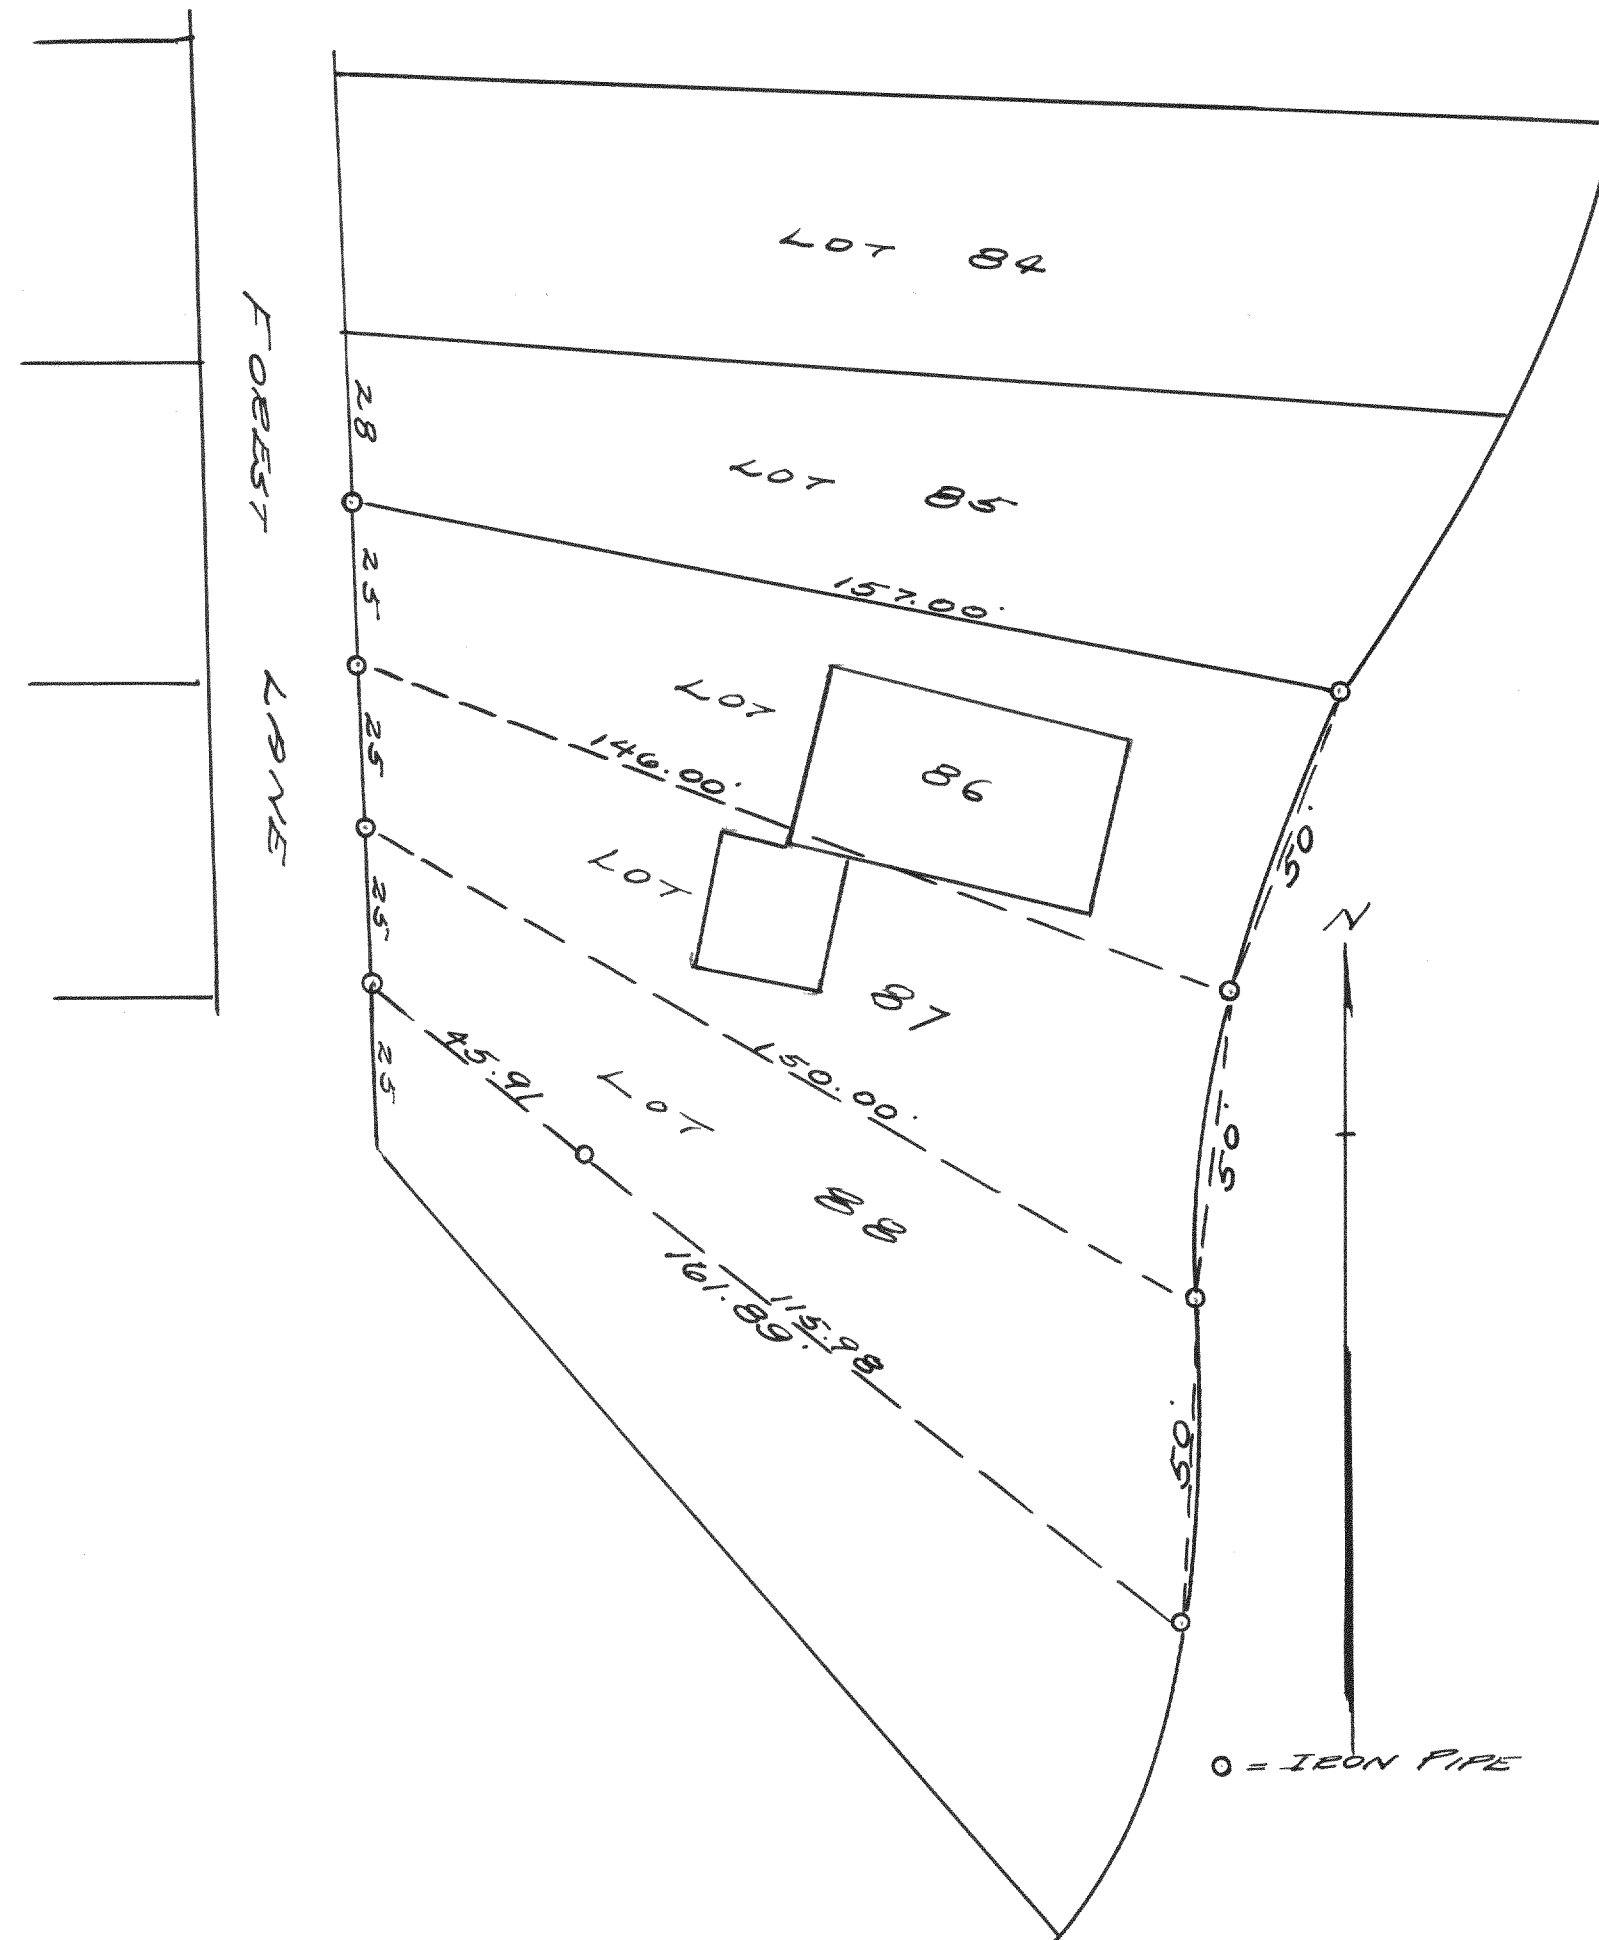


PLAT OF SURVEY OF LOTS 86 TO 88 OF BEUNIA
VISTA SUBD. IN THE VILLAGE OF FONTANA-ON-
GENEVA LAKE, WALWORTH COUNTY, WISCONSIN.

Oct., 1941

Lloyd L. Jensen
N.E.J.

SURVEY NO. 1255

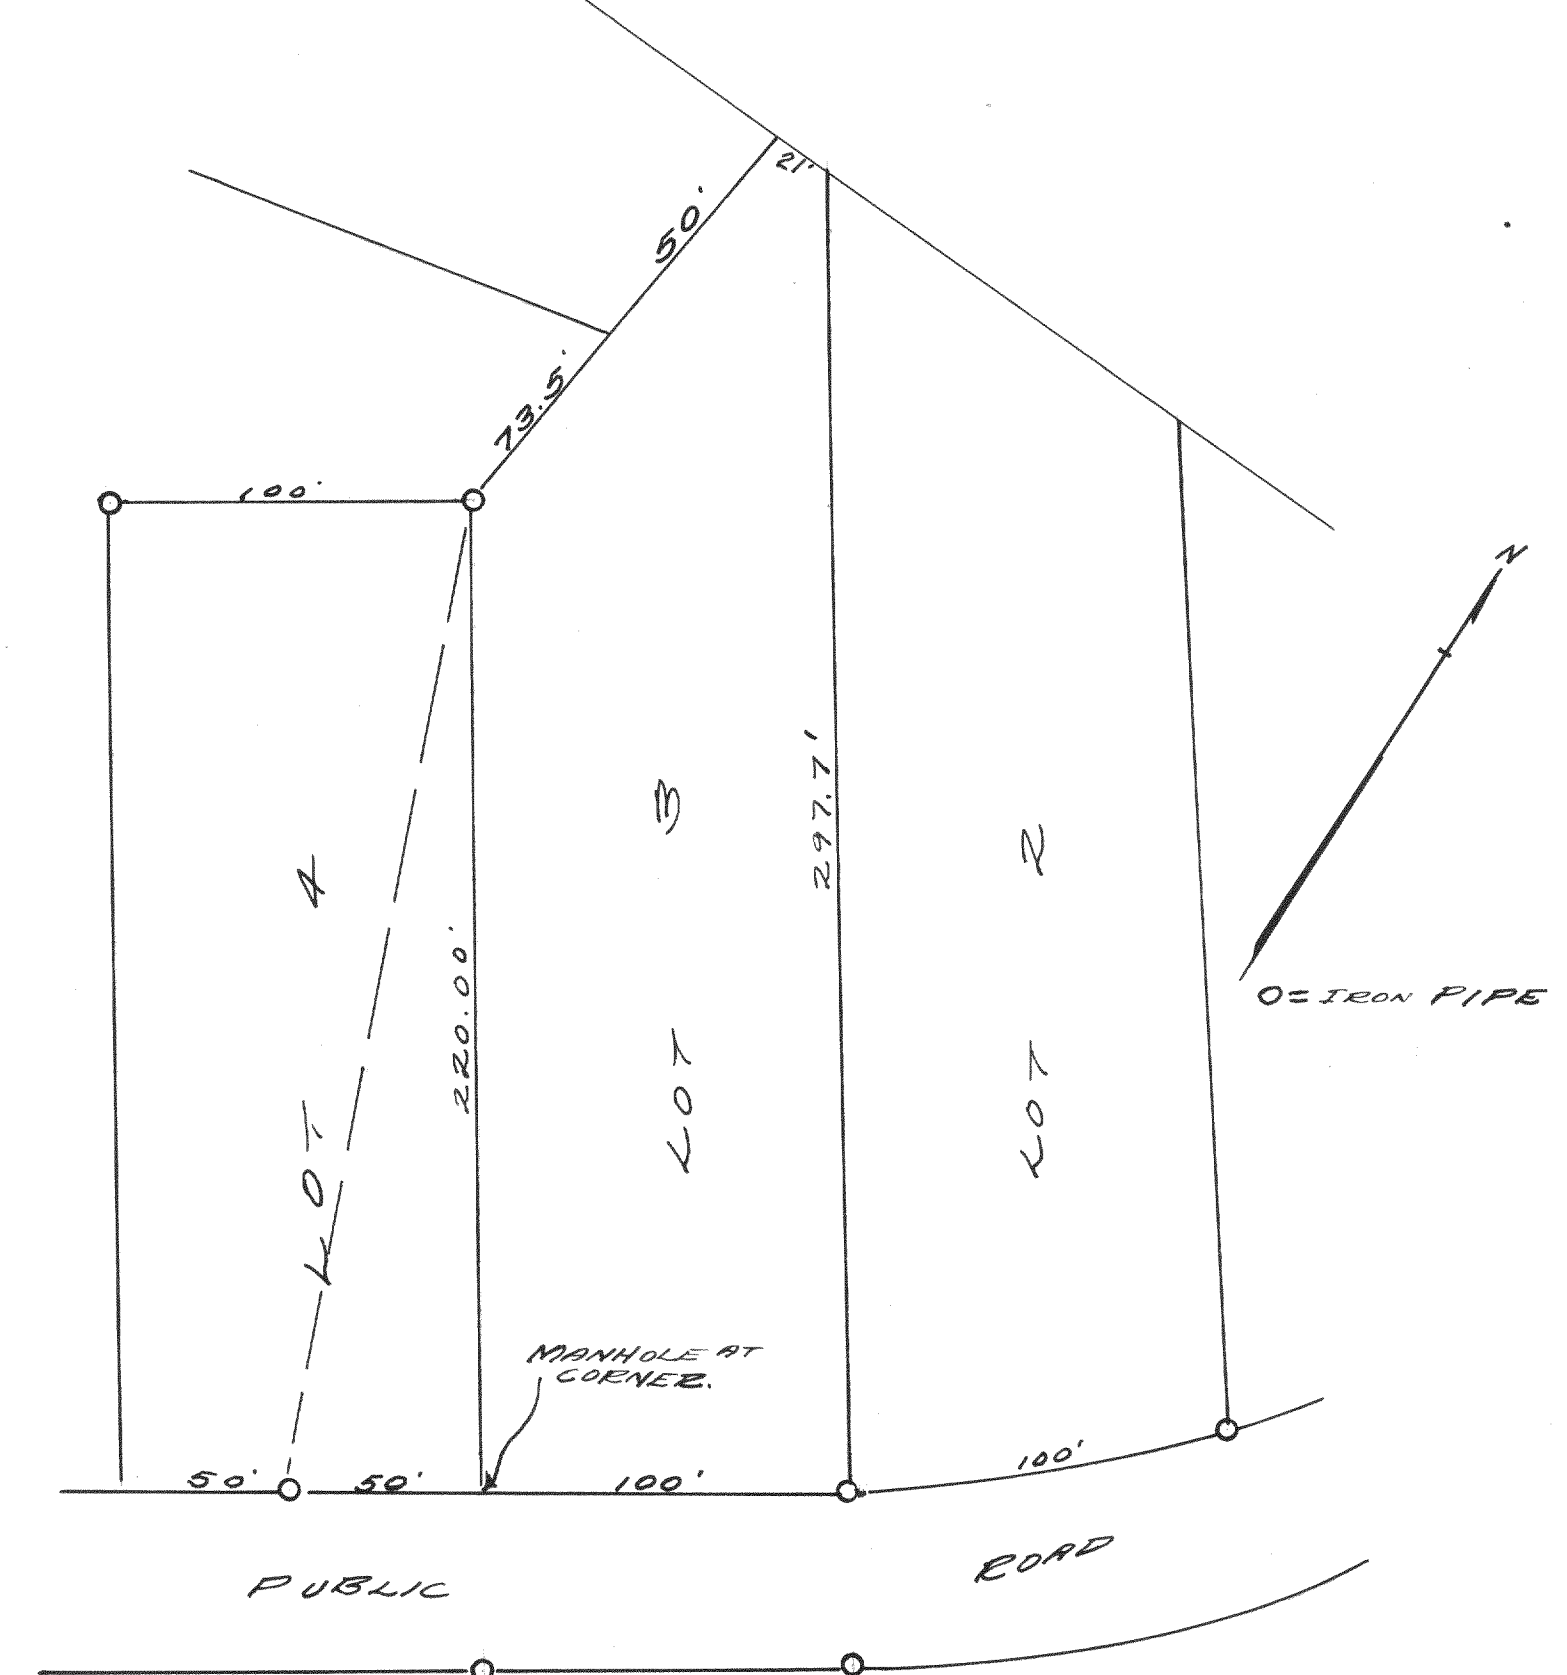

PLAT OF SURVEY OF LOT 3 OF UNIT ONE
OF COUNTRY CLUB ESTATES IN THE VILLAGE
OF FONTANA, WALWORTH COUNTY, WISCONSIN.

APRIL 14, 1941

Lloyd L. Jensen
H.E.J.