



390

1949

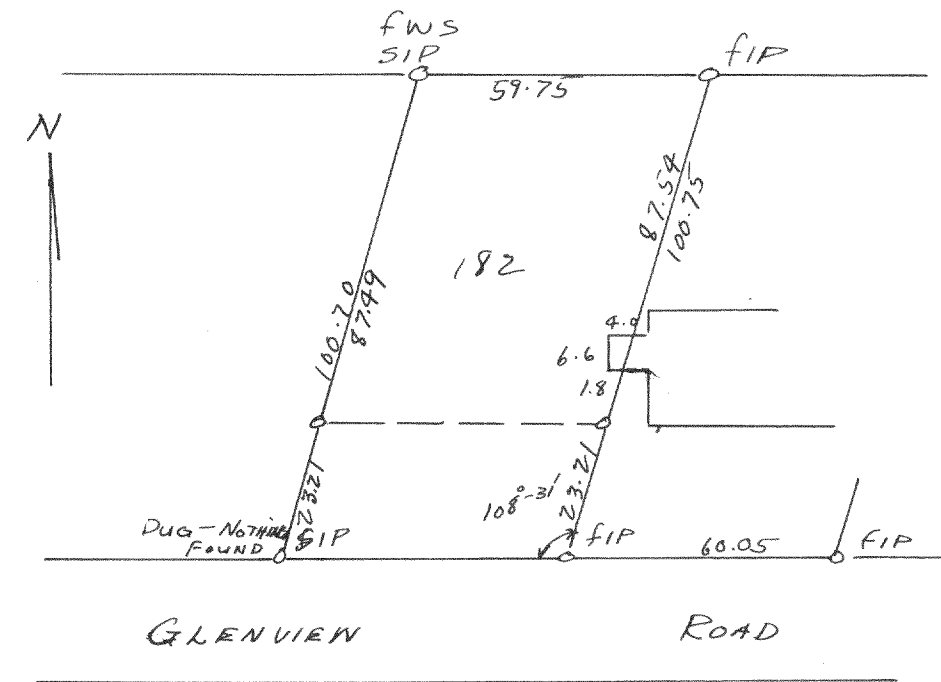


Plot of Survey of Lot 182 Cedar Point Park 2nd Addition
Village of Williams Bay Walworth County
Aug. 1948
Lloyd L. Jensen
CWS

1950

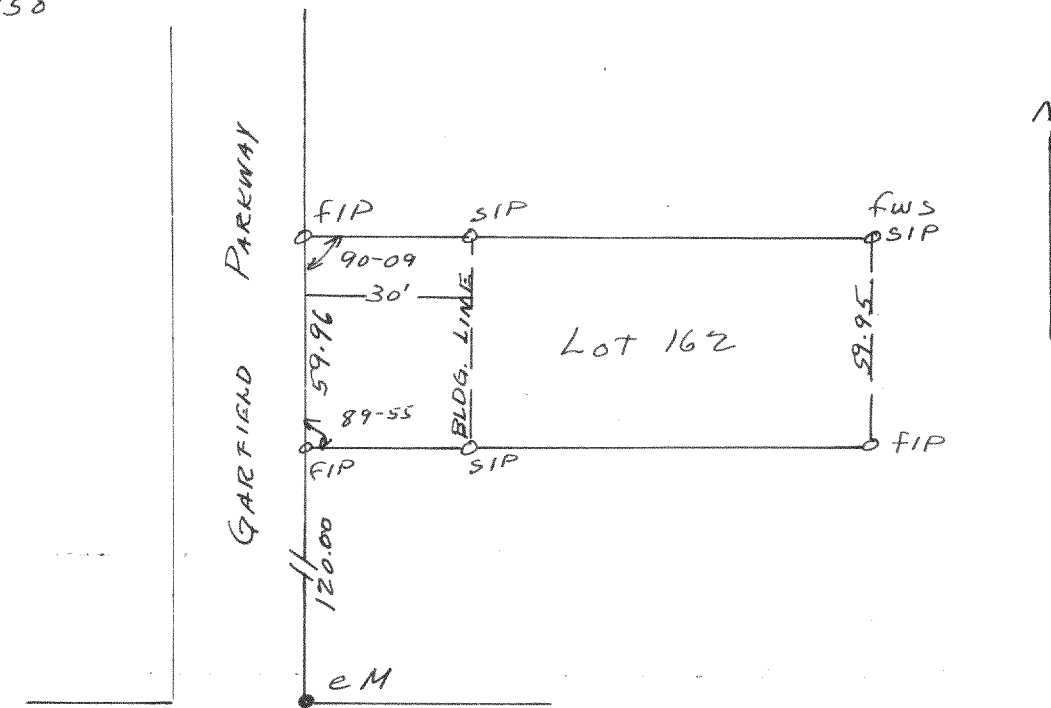


Plot of survey of Lot 162 Cedar Point Park Subdivision
Village of Williams Bay Walworth County
Aug 1948
Lloyd L. Jensen
CWS

1951

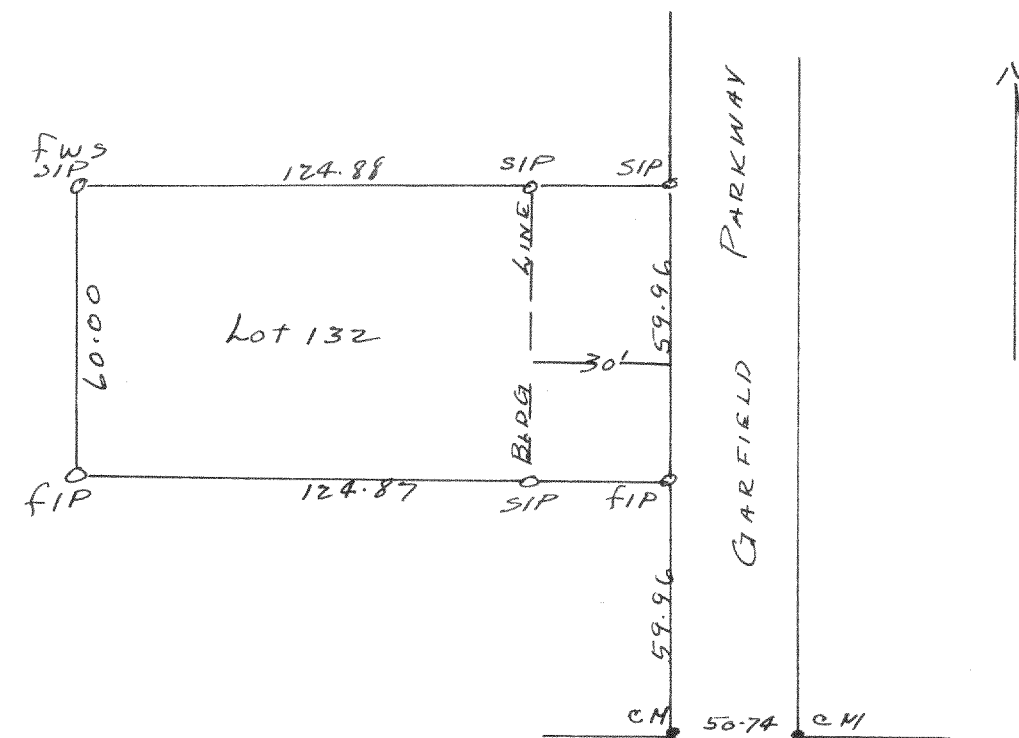

Plot of Survey of lot 132 Cedar Point Park Subdivision
in the Village of Williams Bay Walworth County
Aug 1948

1953

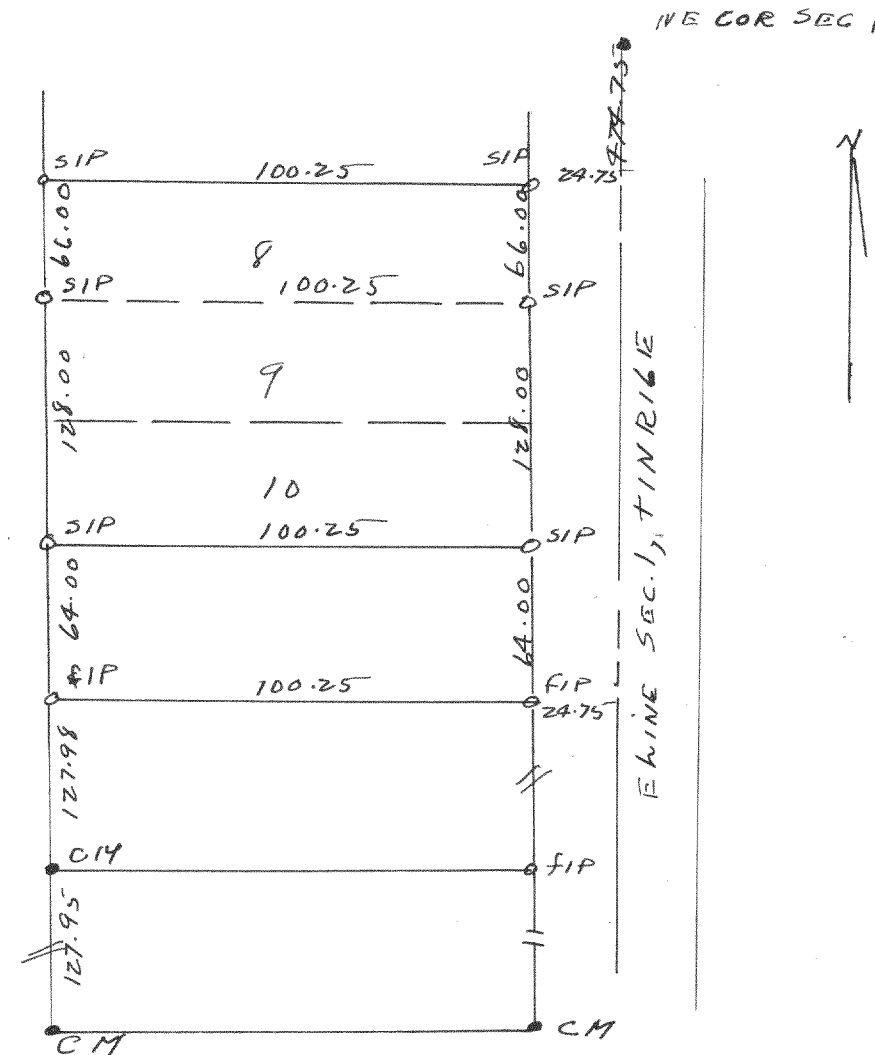

Plot of Survey of Lots 8, 9, 10 of William H. Francis Subdivision
in Village of Williams Bay, Walworth County
Aug 1948
Lloyd L. Jensen
CWS