



# 1954

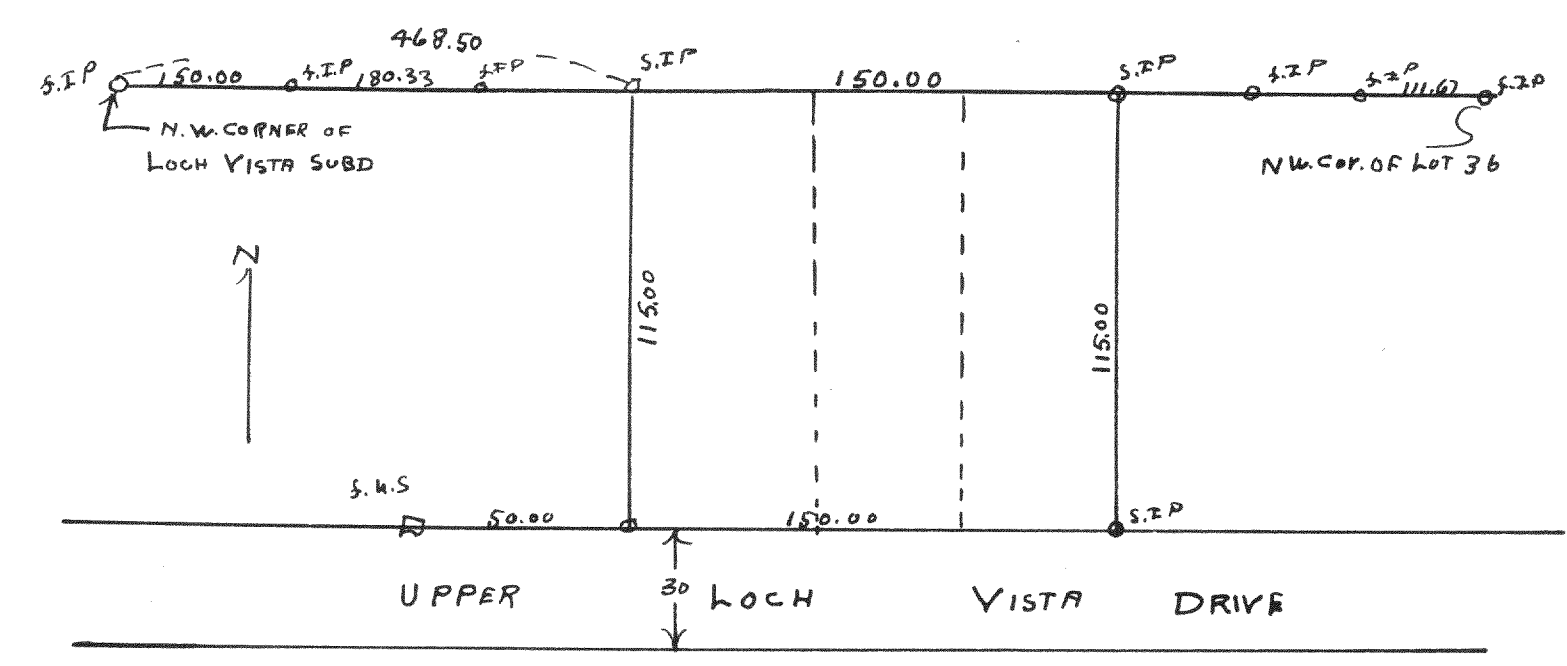


Plot of survey of lots 4, 5 & 6 of Loch Vista Subdivision No. 1  
 Village of Williams Bay, Walworth County, Wis.  
 July 1948  
 Lloyd S. Jensen  
 County Surveyor  
 W.S.

# 1955

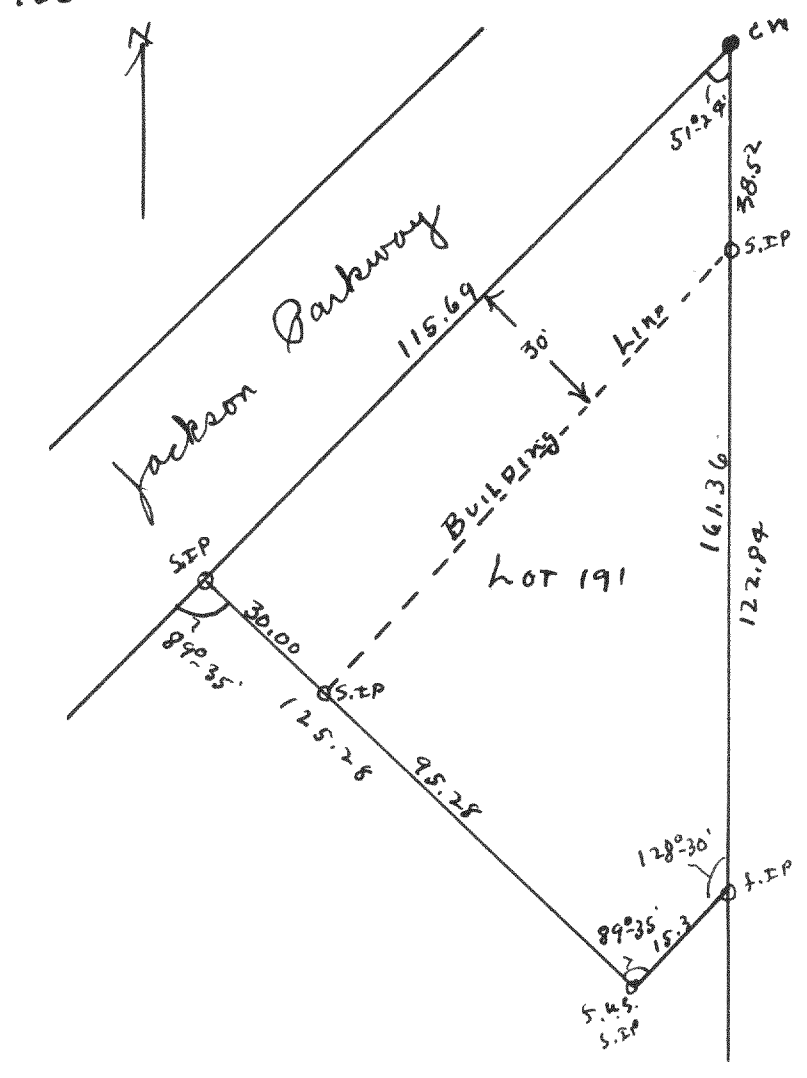


Plot of survey of Lot 191 Cedar Point Park Subdivision located in the Village of Williams Bay, Walworth County, Wis.  
 June 5, 1948  
 Lloyd S. Jensen  
 County Surveyor  
 W.S.

# 1956

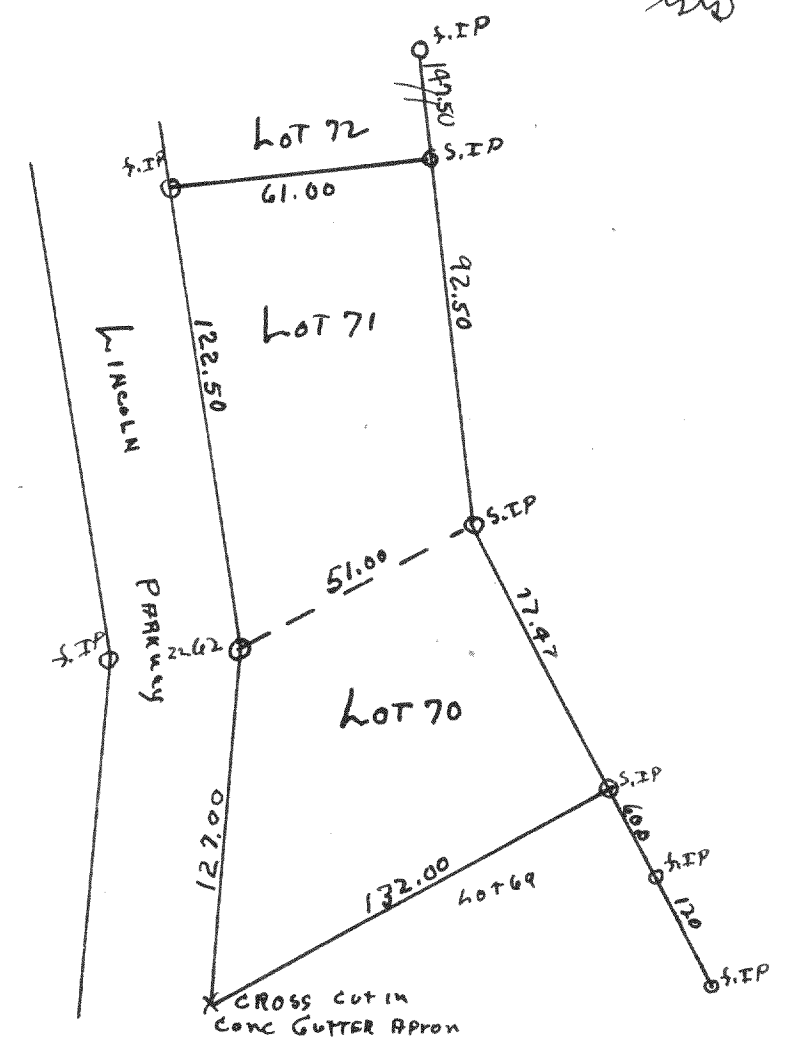

Plot of survey of lots 70 & 71 Cedar Point Park in the Village of Williams Bay, Walworth County, Wisconsin  
 August 1948  
 Lloyd S. Jensen  
 County Surveyor  
 W.S.

# 1957

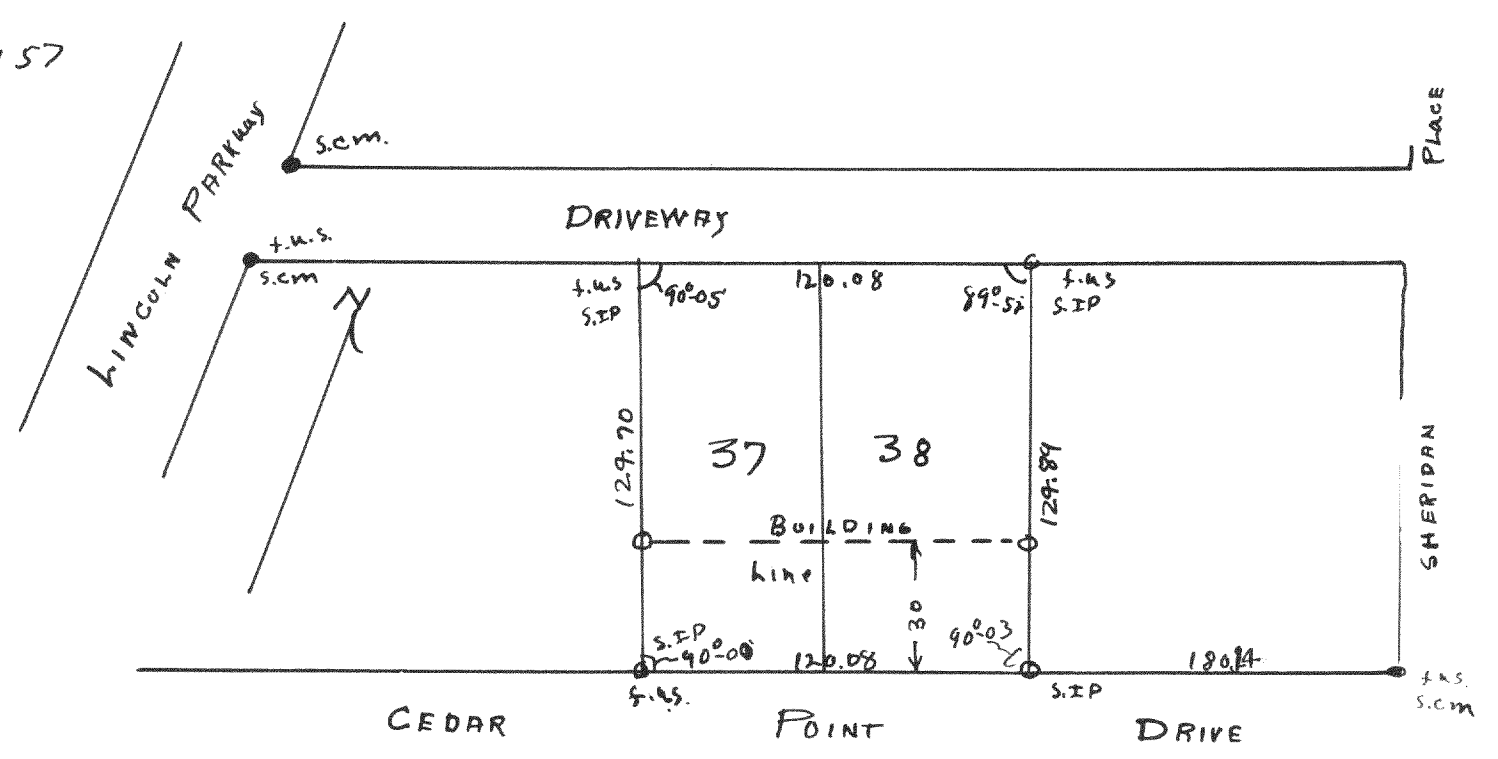

Plot of survey of lots 37 & 38 Cedar Point Park in the Village of Williams Bay, Walworth County, Wisconsin  
 June 5, 1948  
 Lloyd S. Jensen  
 County Surveyor  
 W.S.