



1958

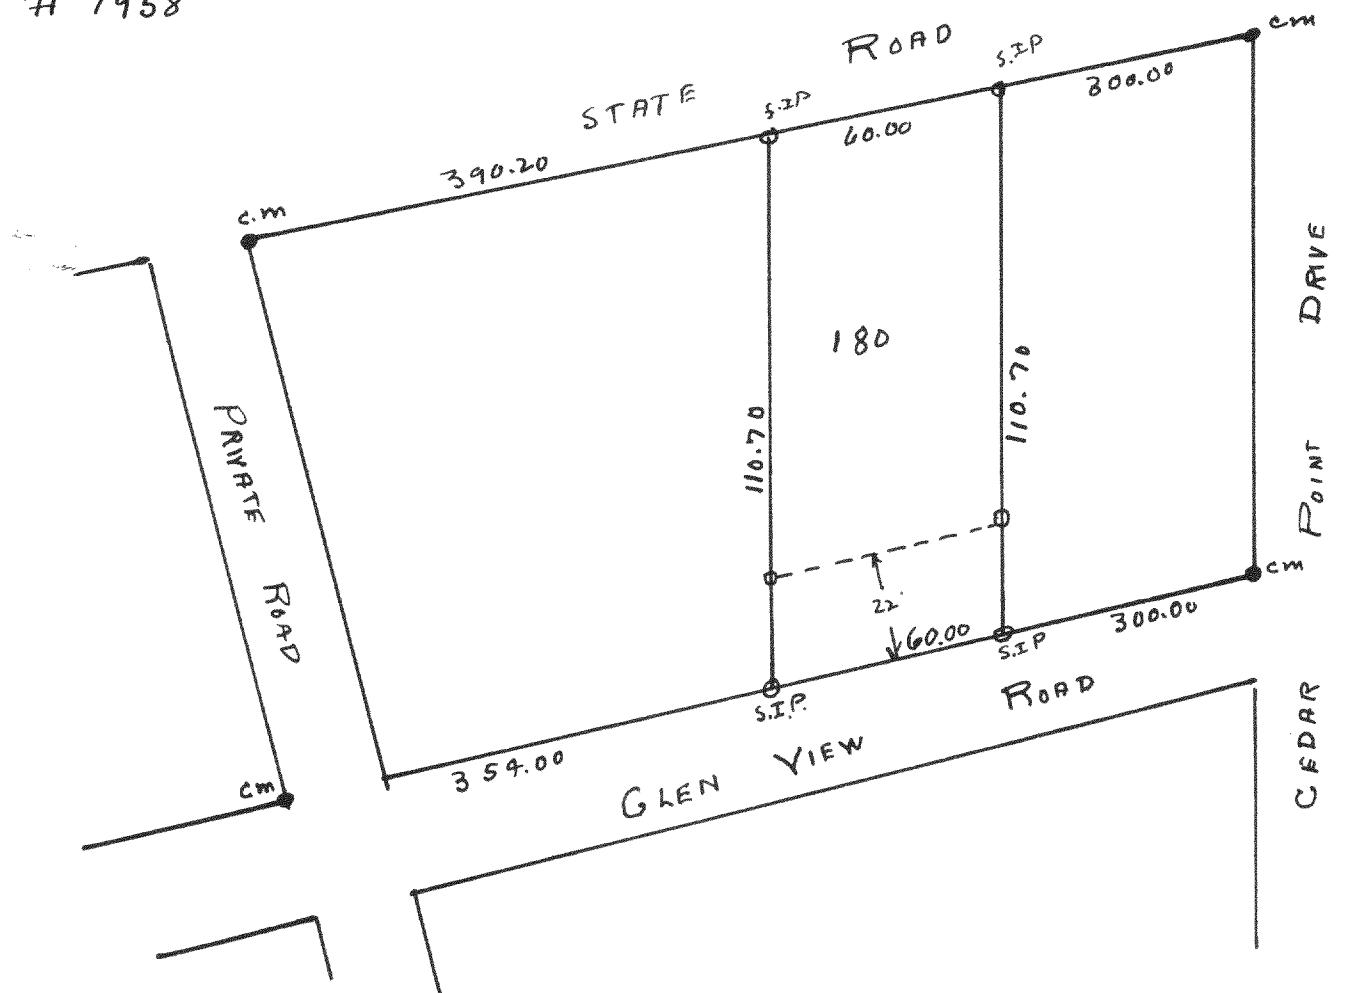


Plot of survey of Lot 180 of the 2nd addition to Cedar Point Park subdivision in the Village of William Bay August 5, 1948
 Lloyd S. Jensen (S.D.)
 County Surveyor

1960

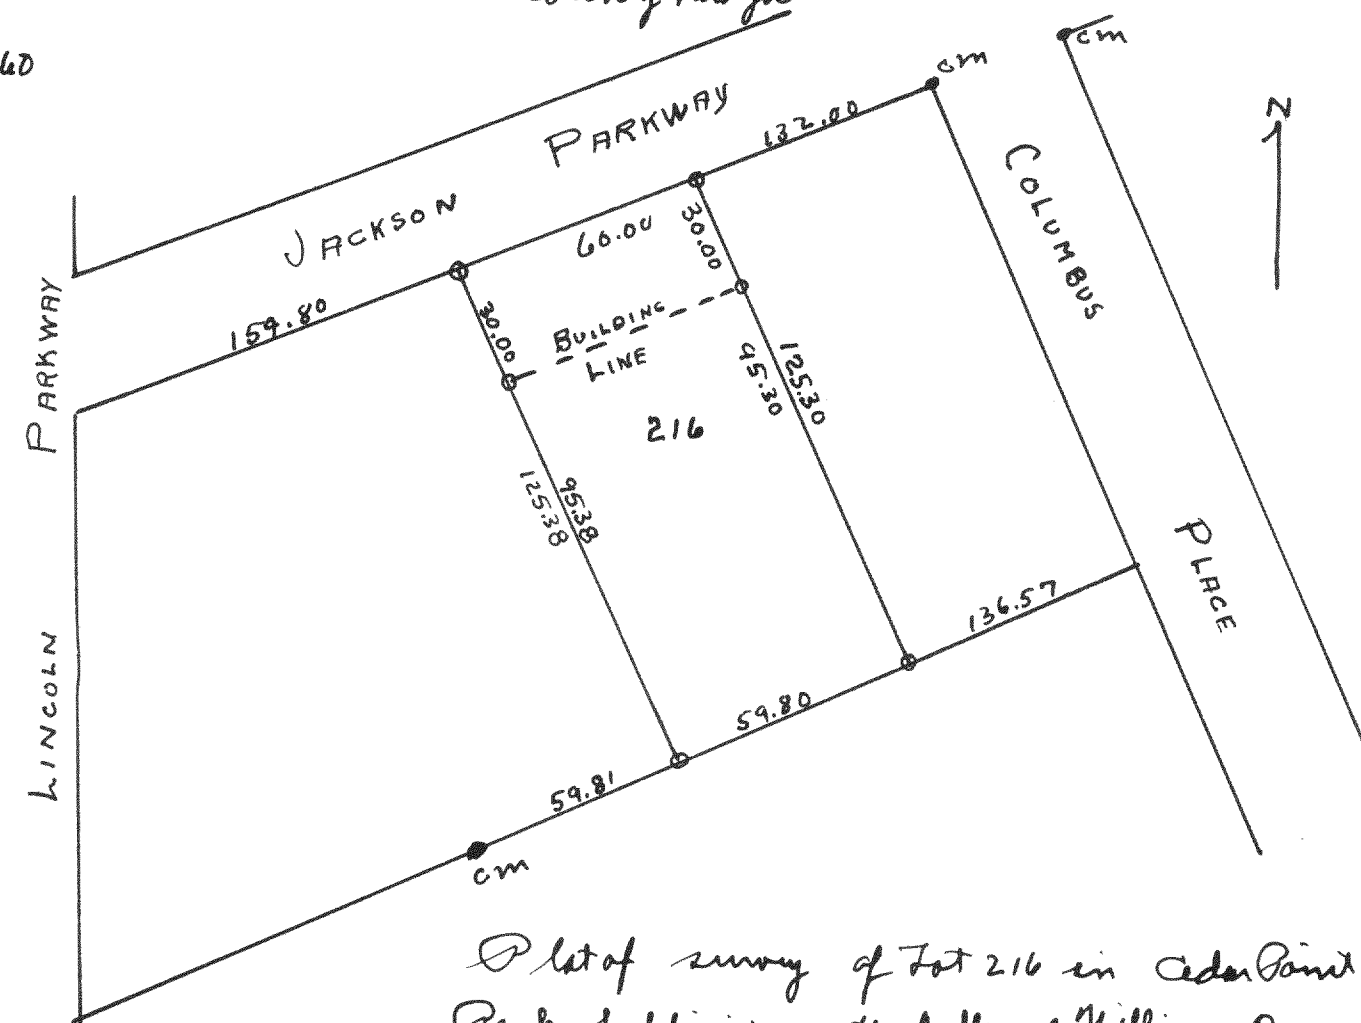


Plot of survey of Lot 216 in Cedar Point Park subdivision in the Village of William Bay April 9, 1948
 Lloyd S. Jensen
 County Surveyor

1959

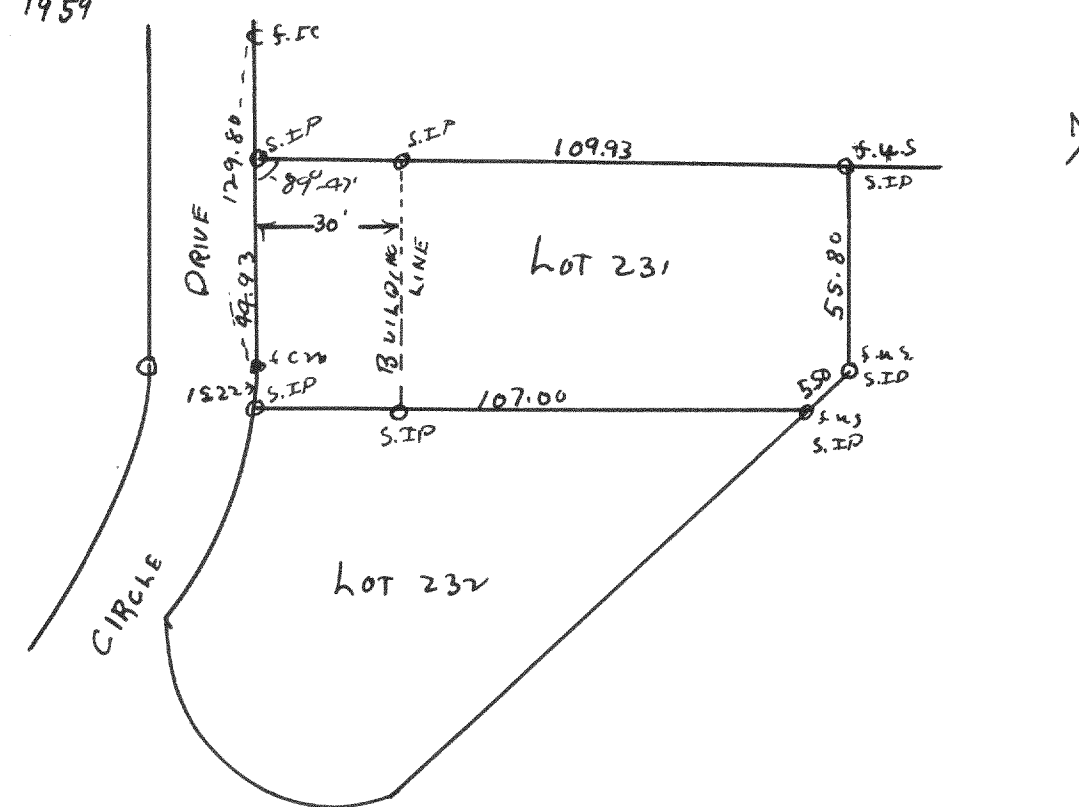

Plot of survey of Lot 231 of the 3rd addition to Cedar Point Park subdivision located in the Village of William Bay, Malheur County, Ore August 1948
 Lloyd S. Jensen
 County Surveyor

1961

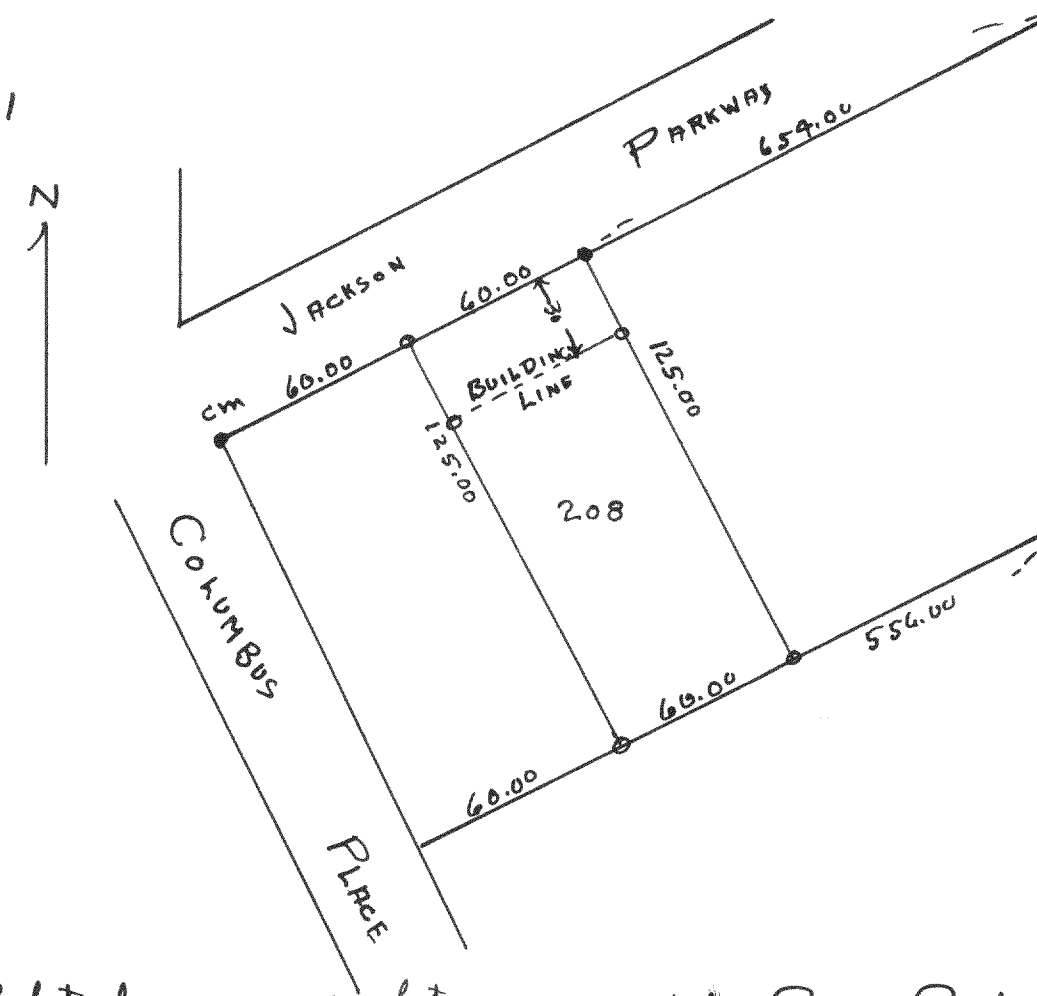

Plot of survey of Lot 208 in Cedar Point Park subdivision located in the Village of William Bay, Malheur County April 9, 1948
 Lloyd S. Jensen
 County Surveyor