



1962

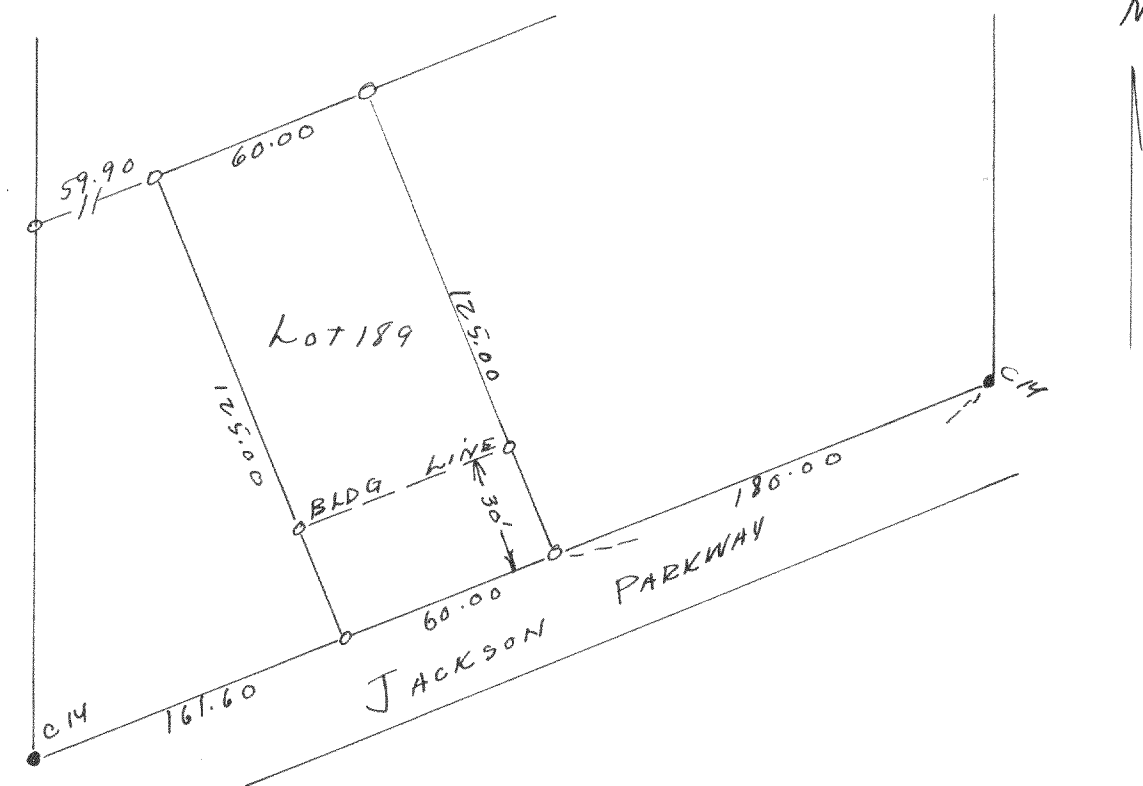

Plot of survey of lot 189 of Cedar Point Park Subd.
Village of Williams Bay, Walworth County.
April 1948
Lloyd L. Jensen

1963

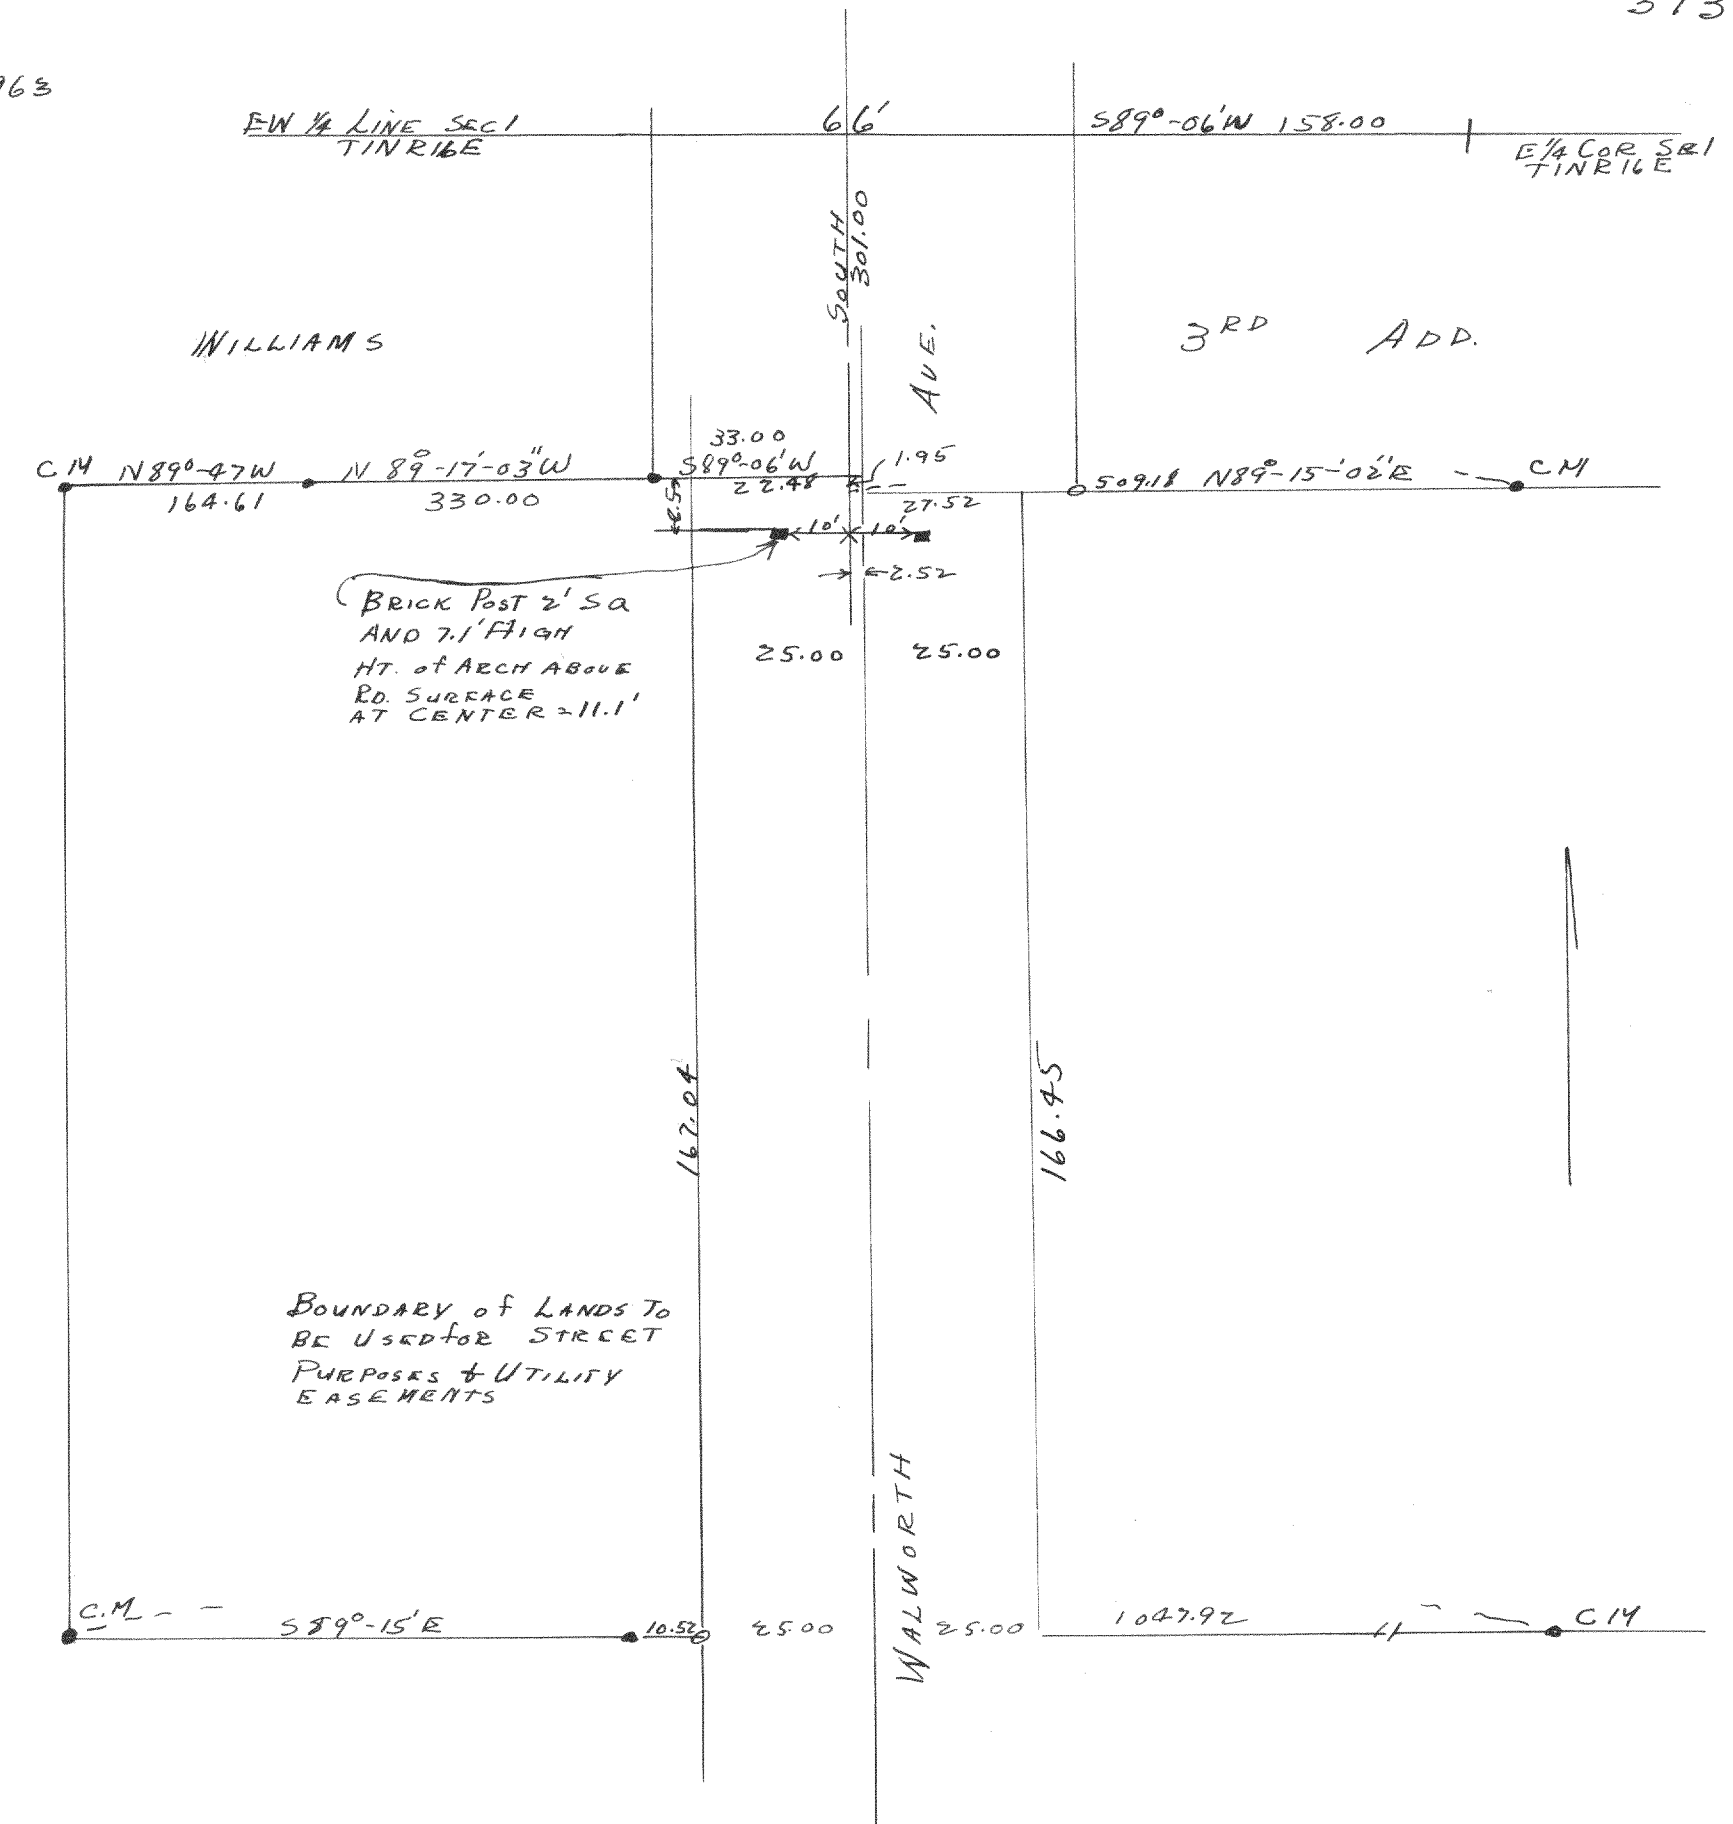

Plot of survey of a 50' strip located in the S.E. fractional 1/4 of Section 1
TINRIDGE Village of Williams Bay, Walworth County
January 79
Lloyd L. Jensen
Clerk.