



#1974

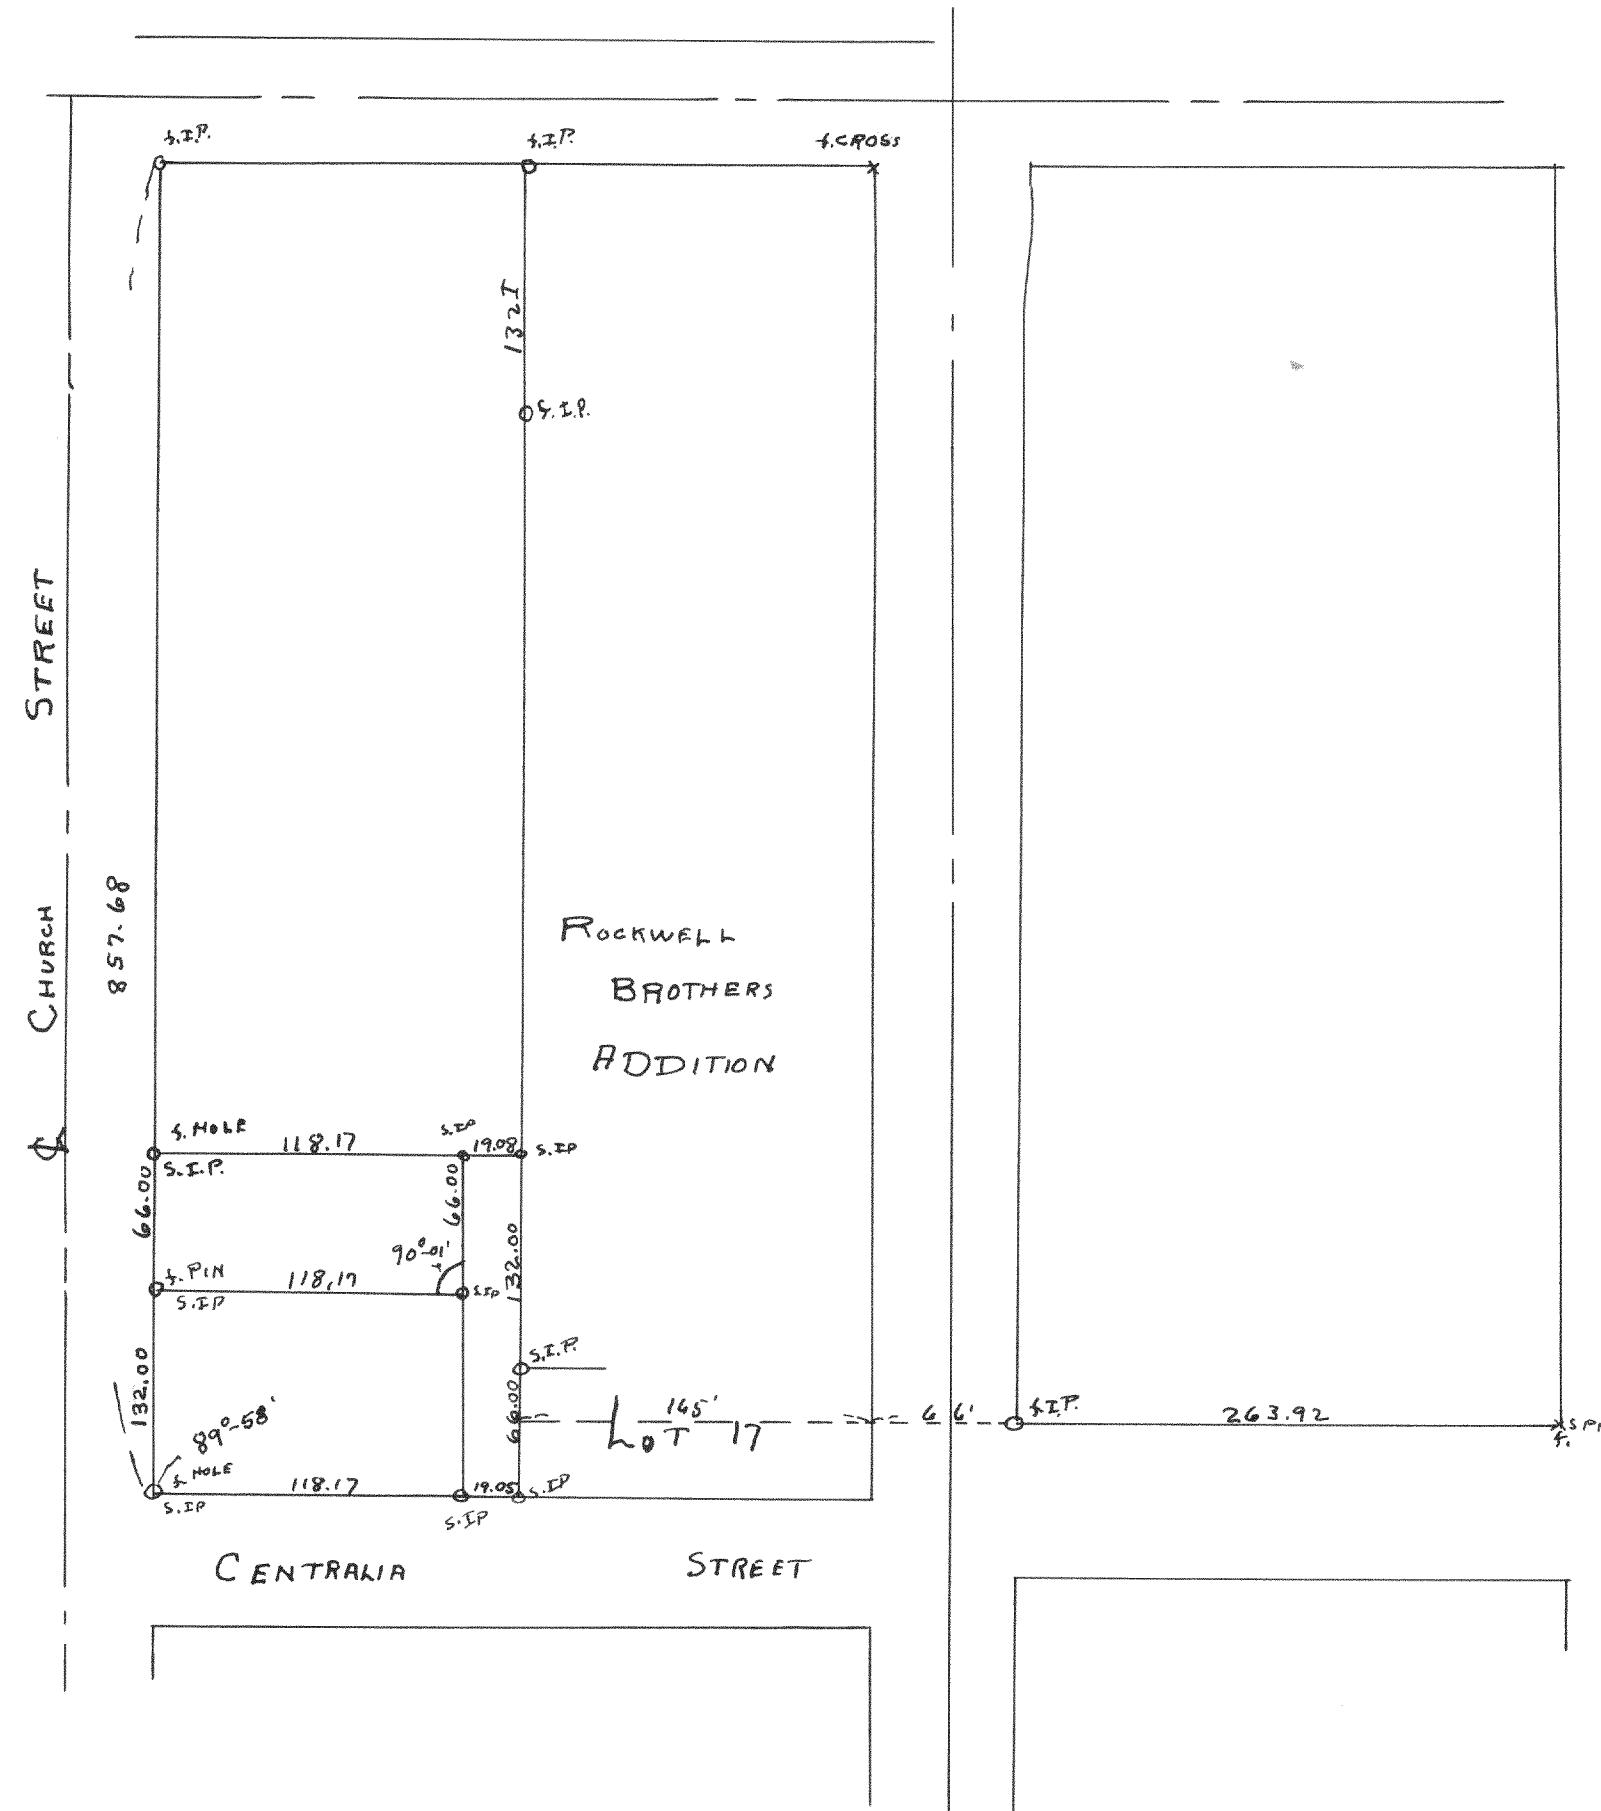

Plot of survey of a parcel of land located next to Rockwells Addition
in the city of Elkhorn, Walworth County Wisconsin
March 1948

Lloyd S Jensen
County Surveyor
LSD

#1975

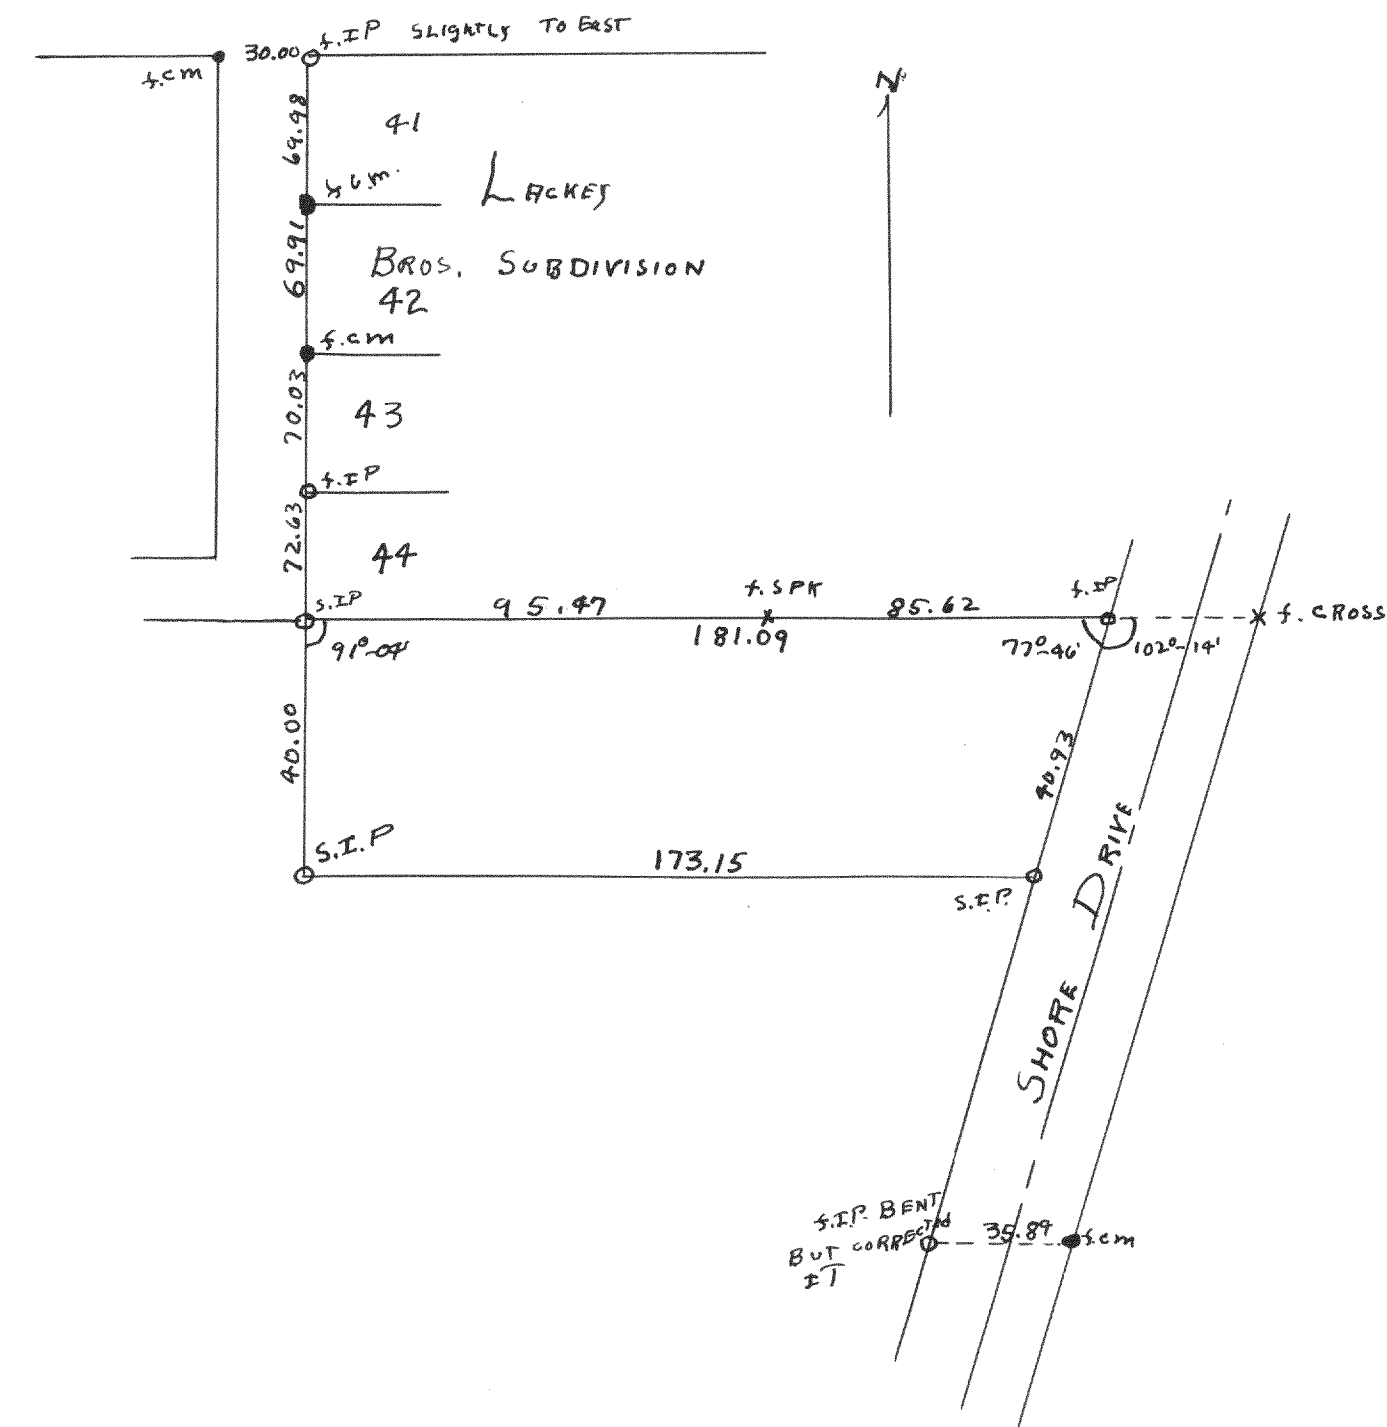

Plot of survey of a parcel of land adjoining the south line of Lacey
Brothers Subdivision in the Village of Williams Bay Walworth County Wisconsin
April 21, 1948

Lloyd S Jensen
County Surveyor
LSD