



1978

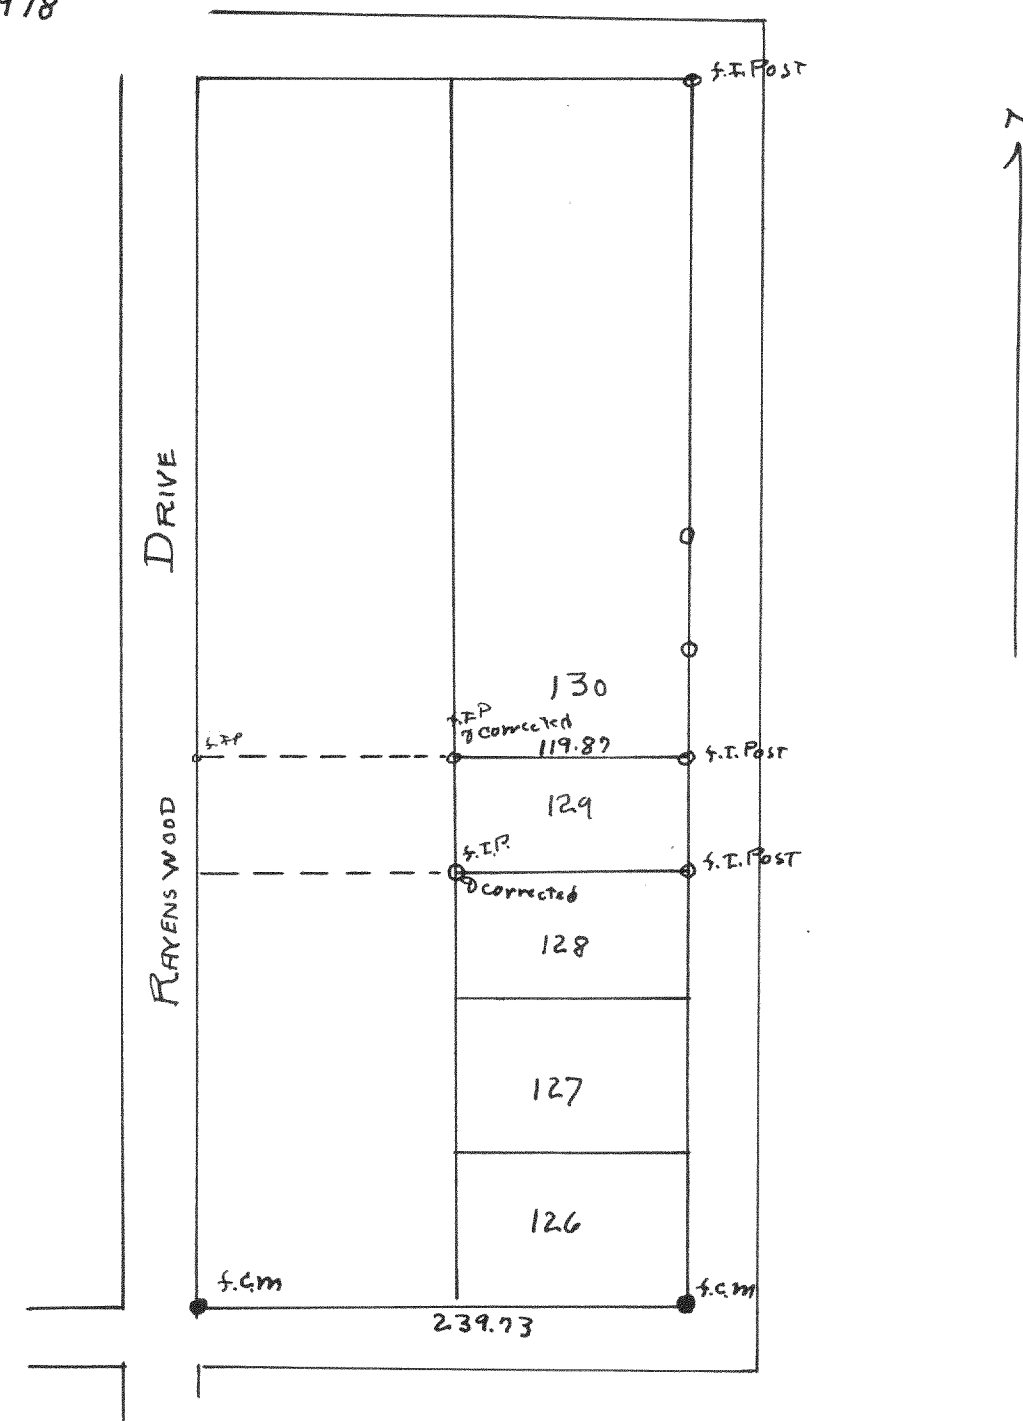

Plat of survey of lot 129 in Hummer's 2nd Addition
located in Section 31, T2N R16E Malworth County Wisconsin
May 8, 1998
Lloyd S Jensen
County Surveyor
L.S.J.

1979

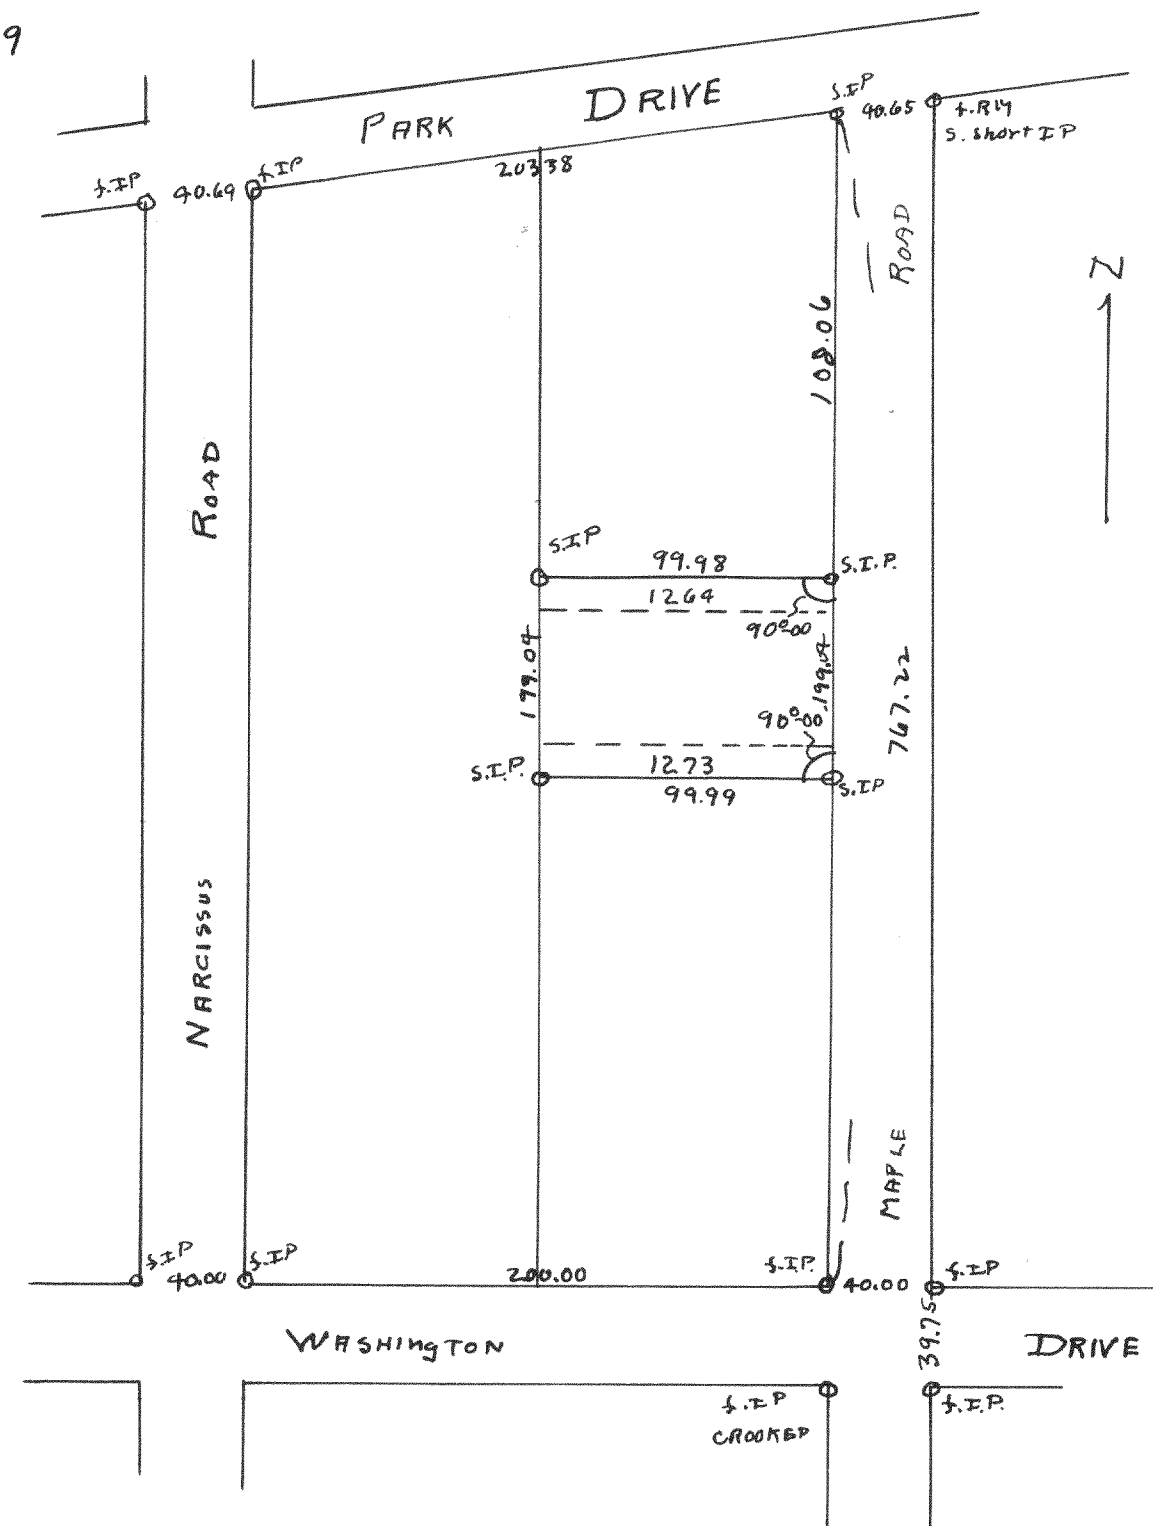

Plat of survey of lots 1264-1273 Lake Como Beach
Subdivision Malworth County Wisconsin
May 8, 1998
Lloyd S Jensen
County Surveyor
L.S.J.