


#1982

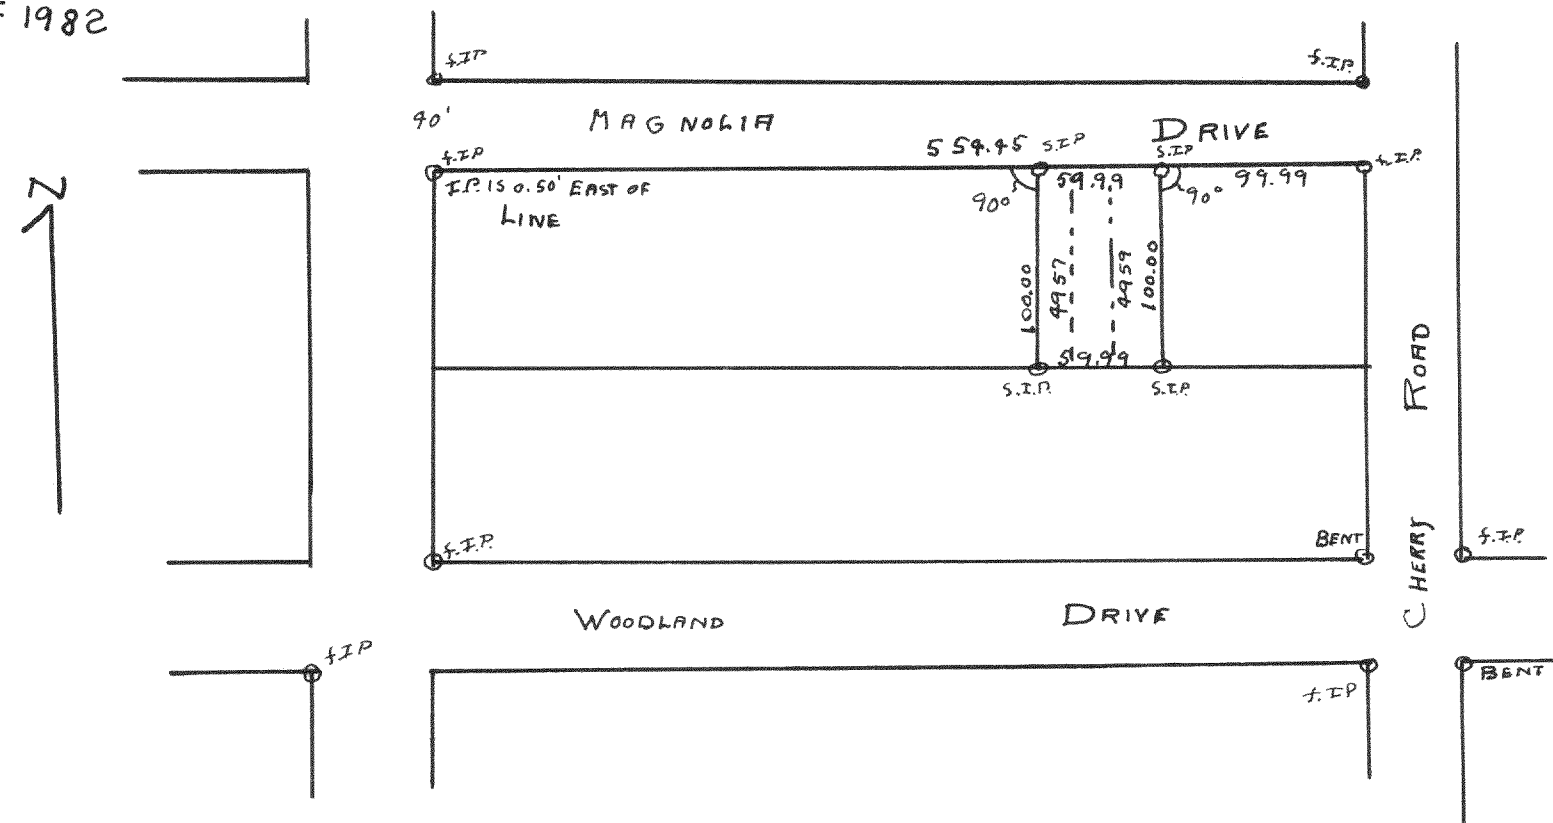


Plot of survey of lots 4957 to 4959 Lake Como Beach Subdivision
located in sections 21 & 22 T2N R17E of Walworth County, Wis.

November 10, 1948

Lloyd S. Jensen
County Surveyor
12th

#1983

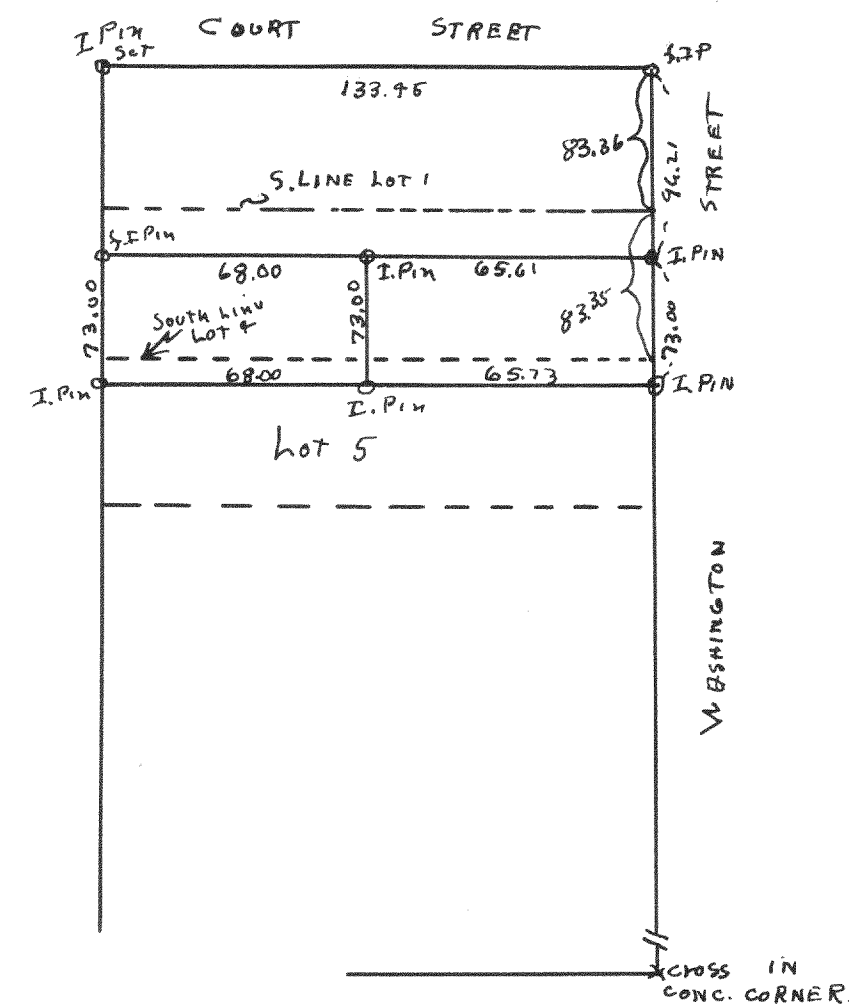

Plot of survey of part of lots 4 & 5 Block 20 of the Original Town-
City of Elkhorn, Walworth County Wisconsin

April 24, 1948

Lloyd S. Jensen
County Surveyor
12th