



#1984

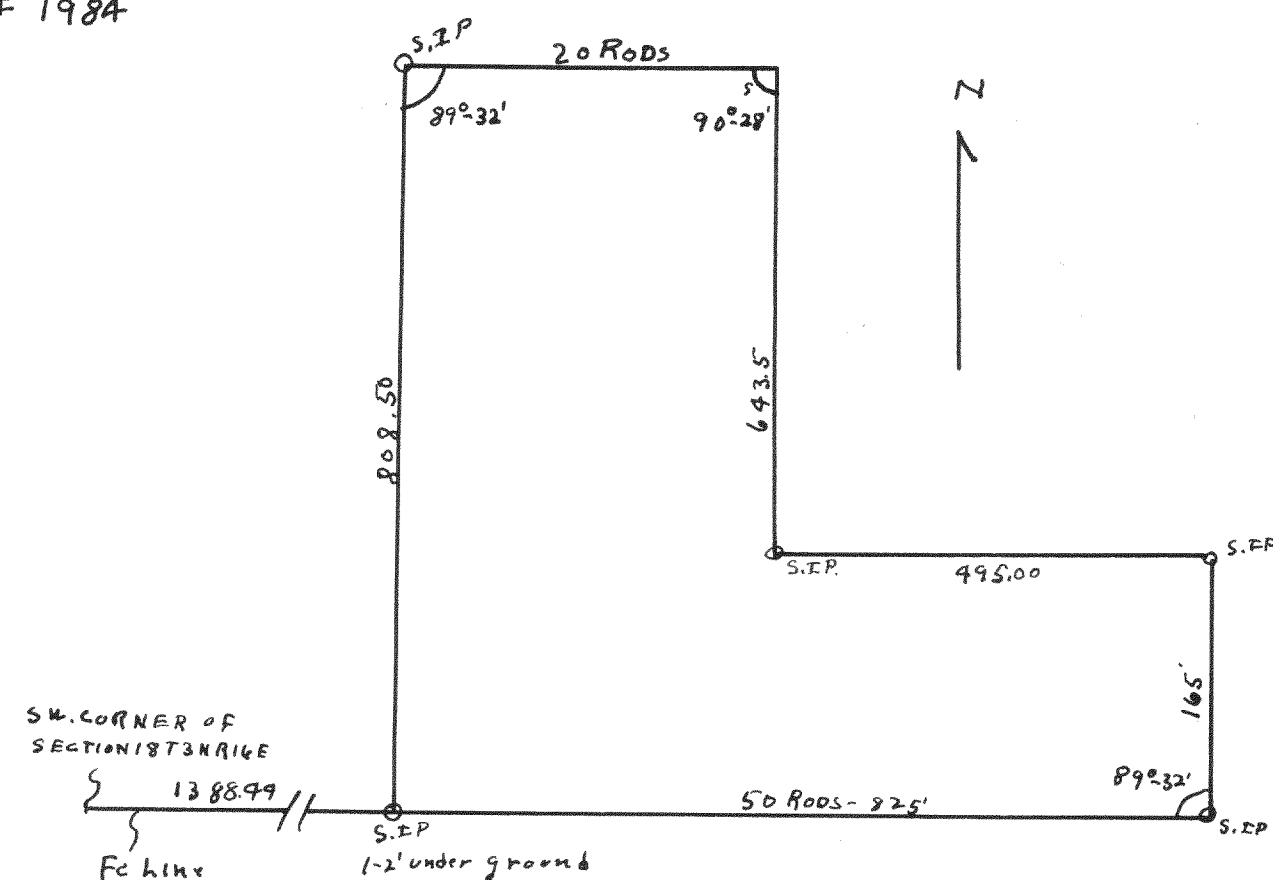

#1985

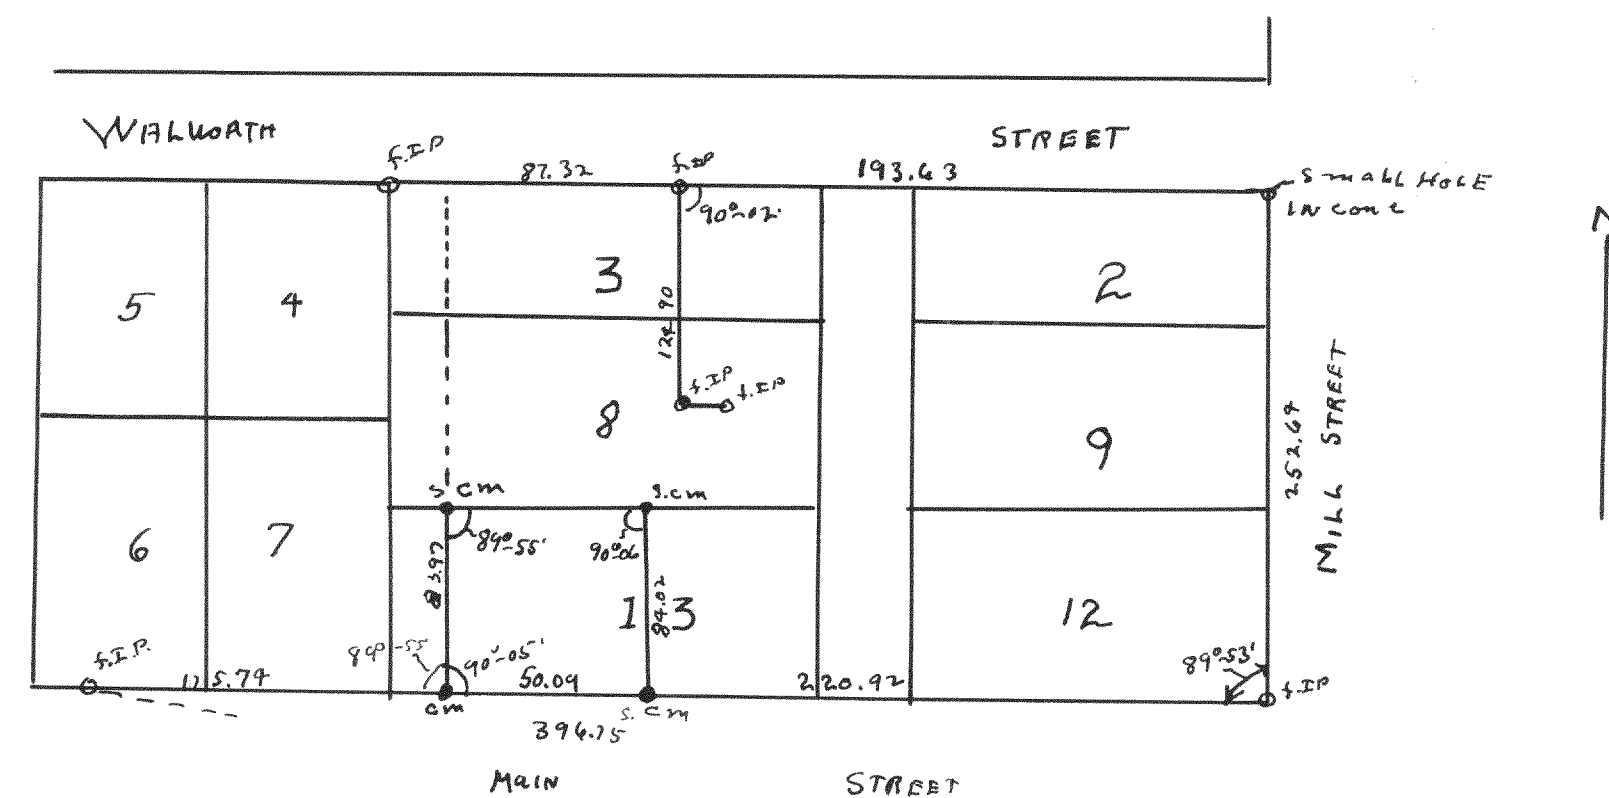


Plot of survey of part of Lot 13 of the original Plot of the Village of Geneva City Walworth County Wisconsin
1948

Lloyd S Jensen
County Surveyor
12/25


Plot of survey of a parcel of land located in the SW 1/4 of Section 18 T3N R14E Walworth County Wisconsin
April 19 1948
Lloyd S Jensen (S.D.)
County Surveyor

#1986

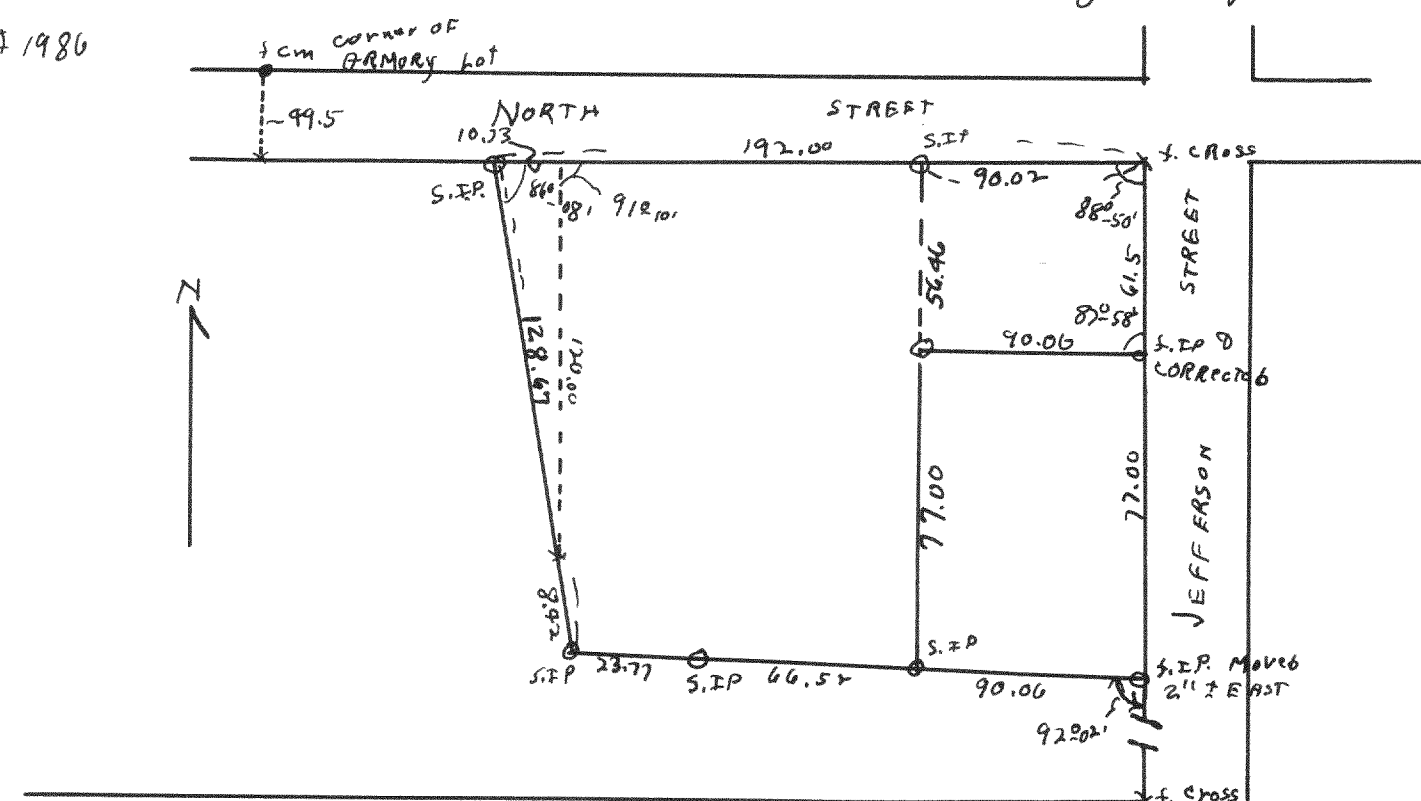

Plot of survey of land located in lots 8, 9, 10 of Wm. Bergs addition in the City of ~~Elkhorn~~ ^{Jefferson}, Walworth County Wis
1948
Lloyd S Jensen
County Surveyor
12/25

#1987

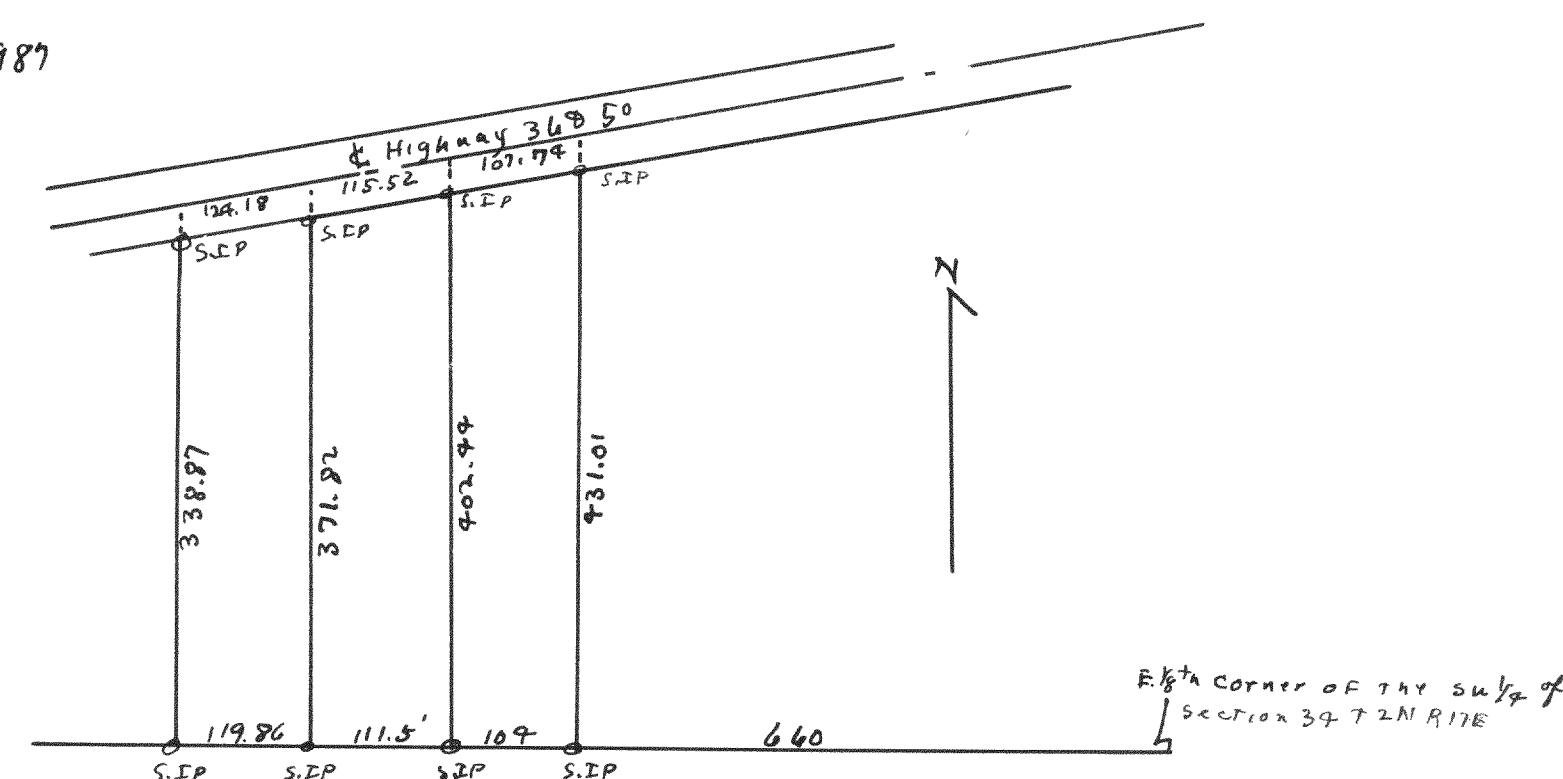

Plot of survey of parcels of land located in the SW 1/4 of Section 34 T2N R17E of Walworth County Wisconsin
July 8, 1948
Lloyd S Jensen
County Surveyor
12/25