


404


#1988

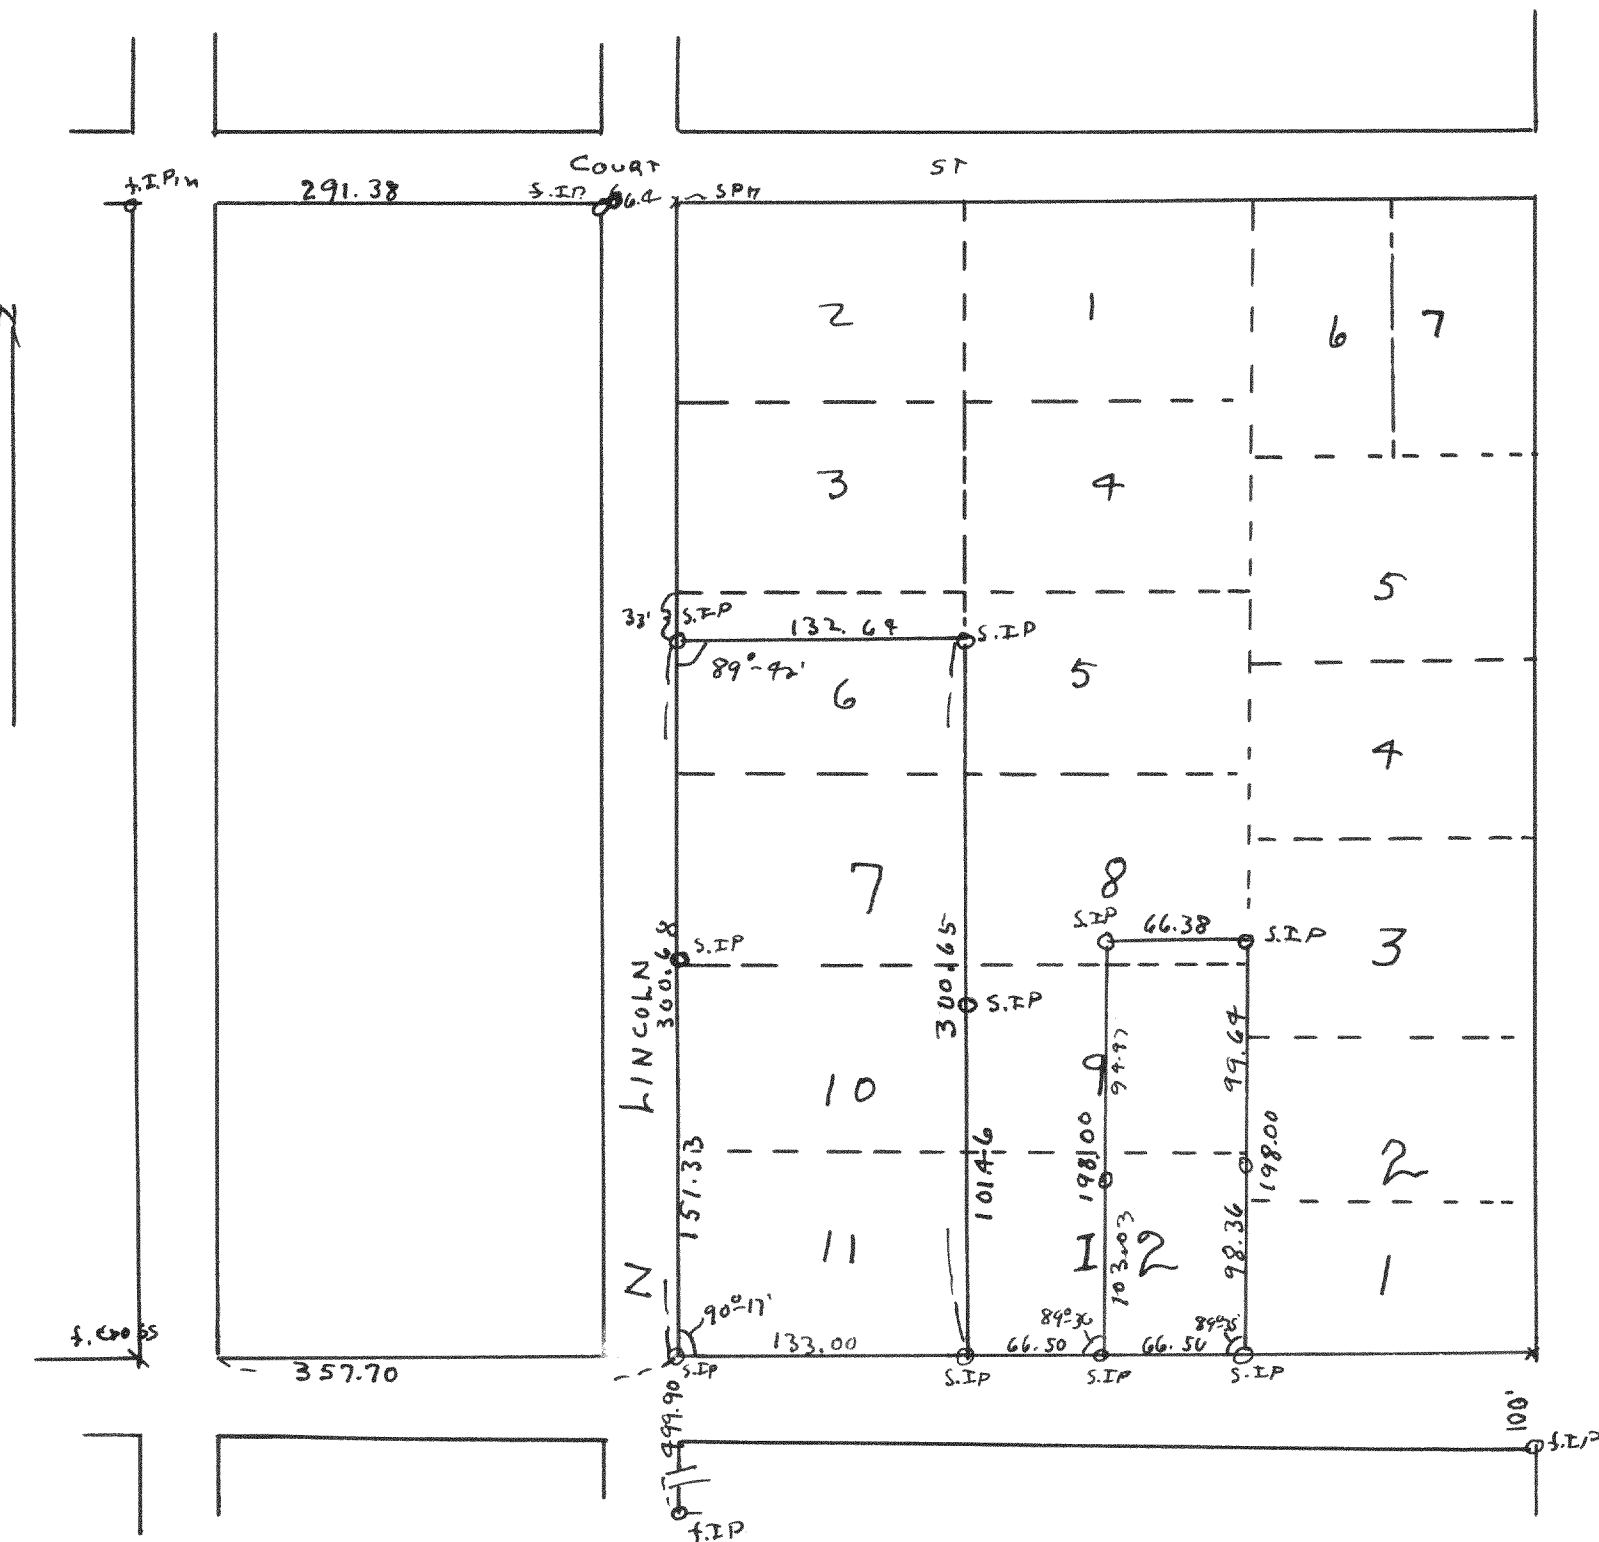

Plot of survey of lots 7, 10, 11, & part of lots 6, 8, 9 & 12 in Block 22
City of Elkhorn, Walworth County Wisconsin
July 15, 1948

Lloyd S Jensen
County Surveyor
L.S.J.

#1989

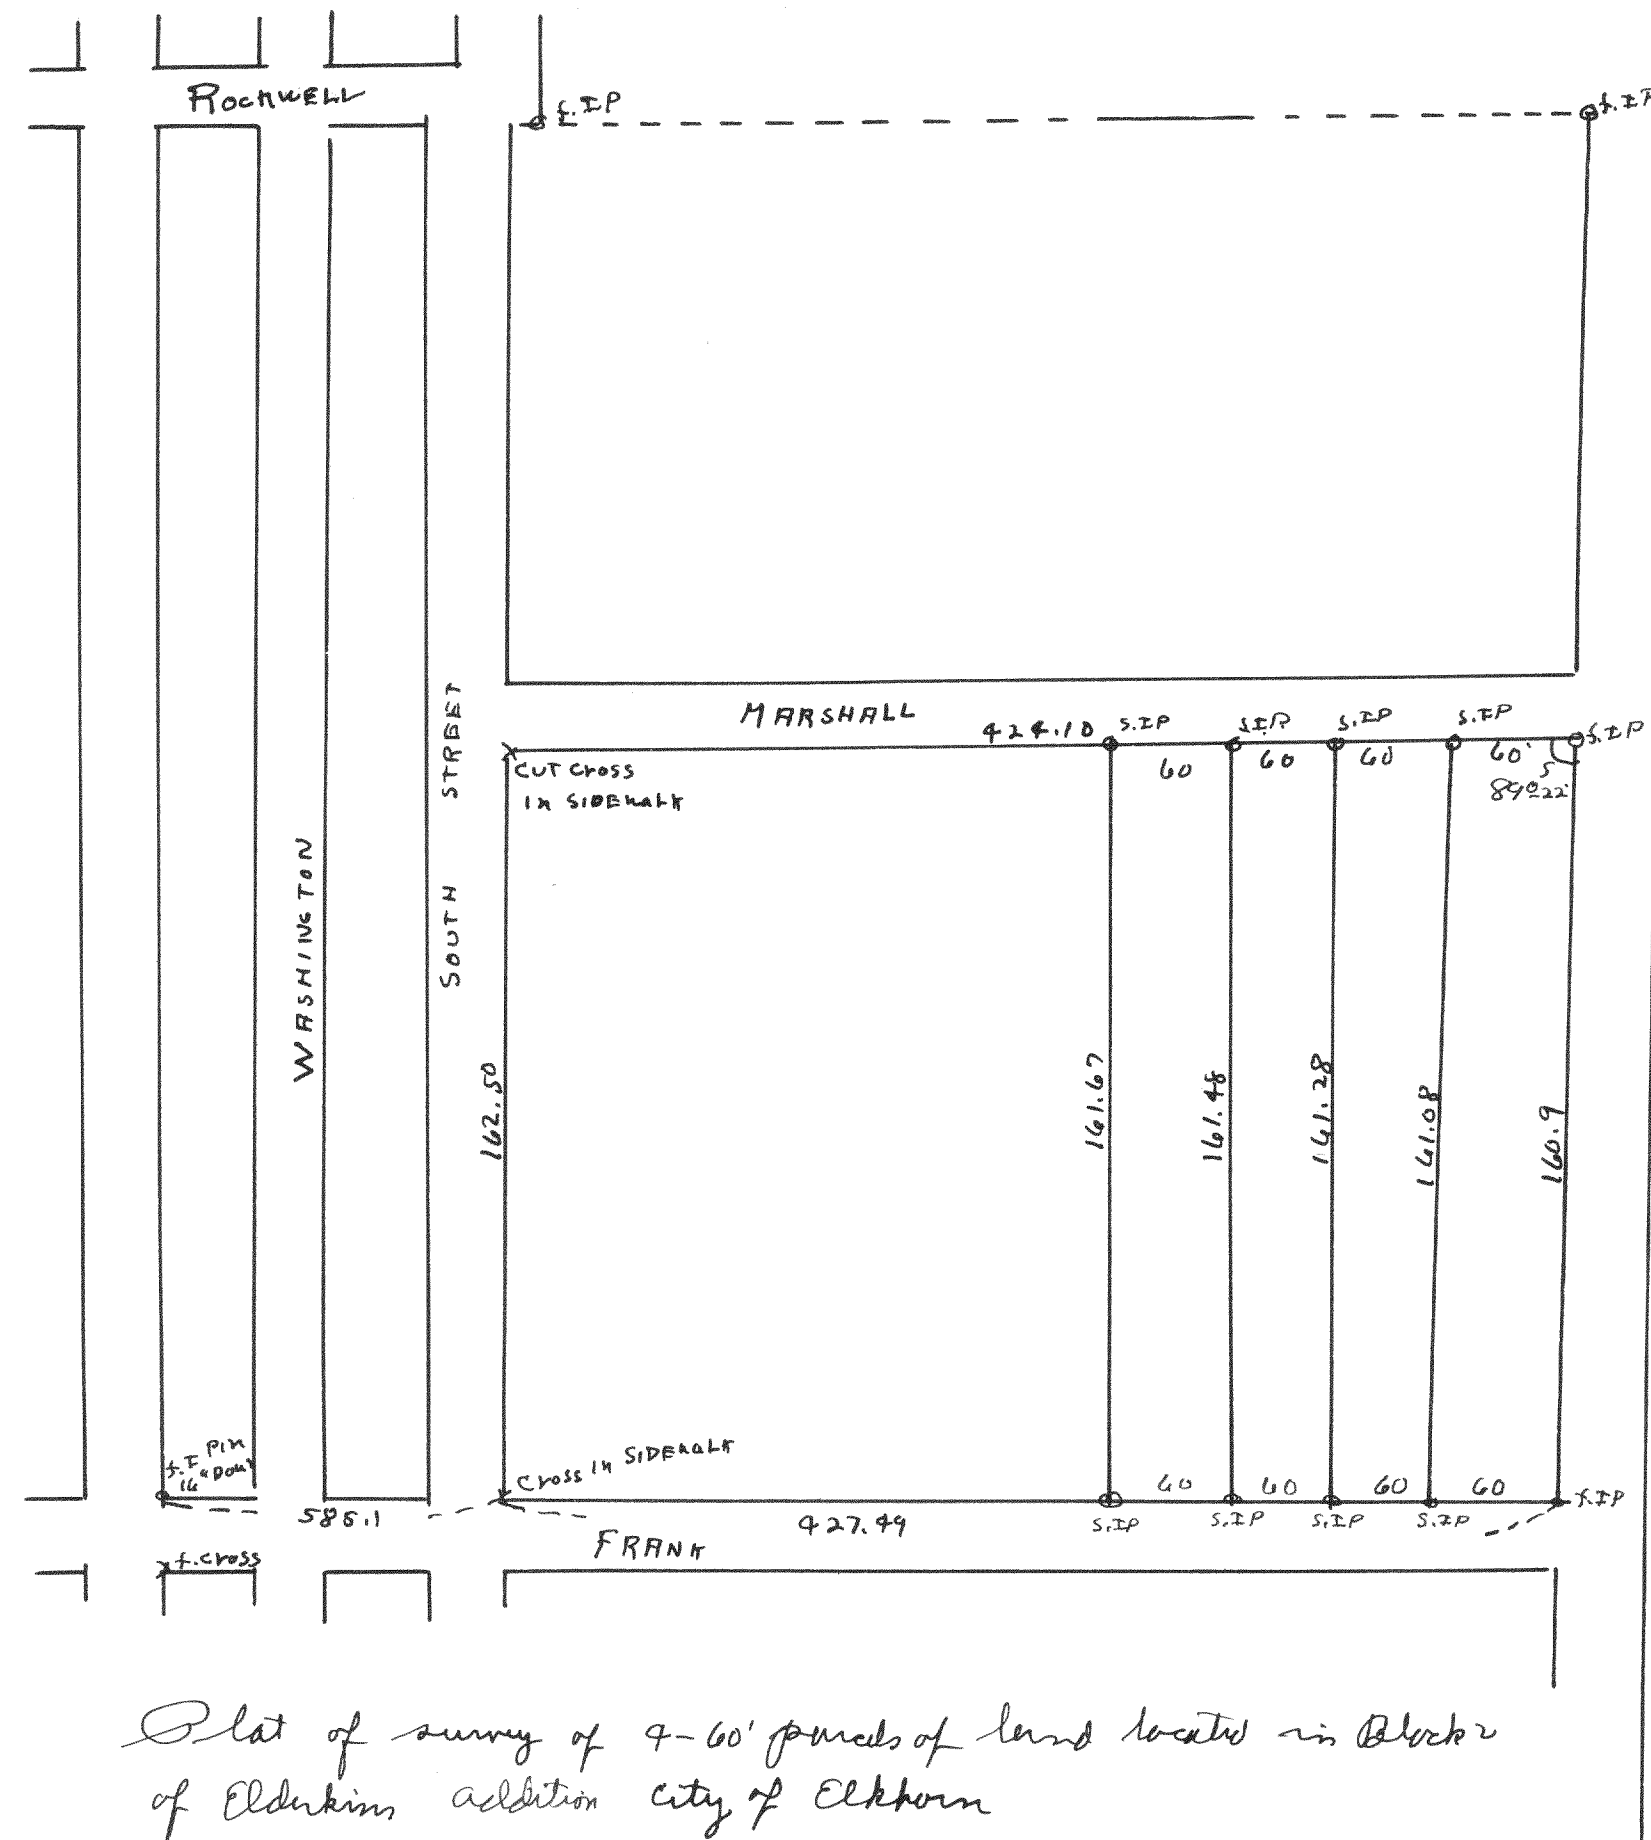

Plot of survey of 9-60' parcels of land located in Block 22
of Elderkins addition City of Elkhorn
July 30, 1948

Lloyd S Jensen
County Surveyor
L.S.J.