



1990

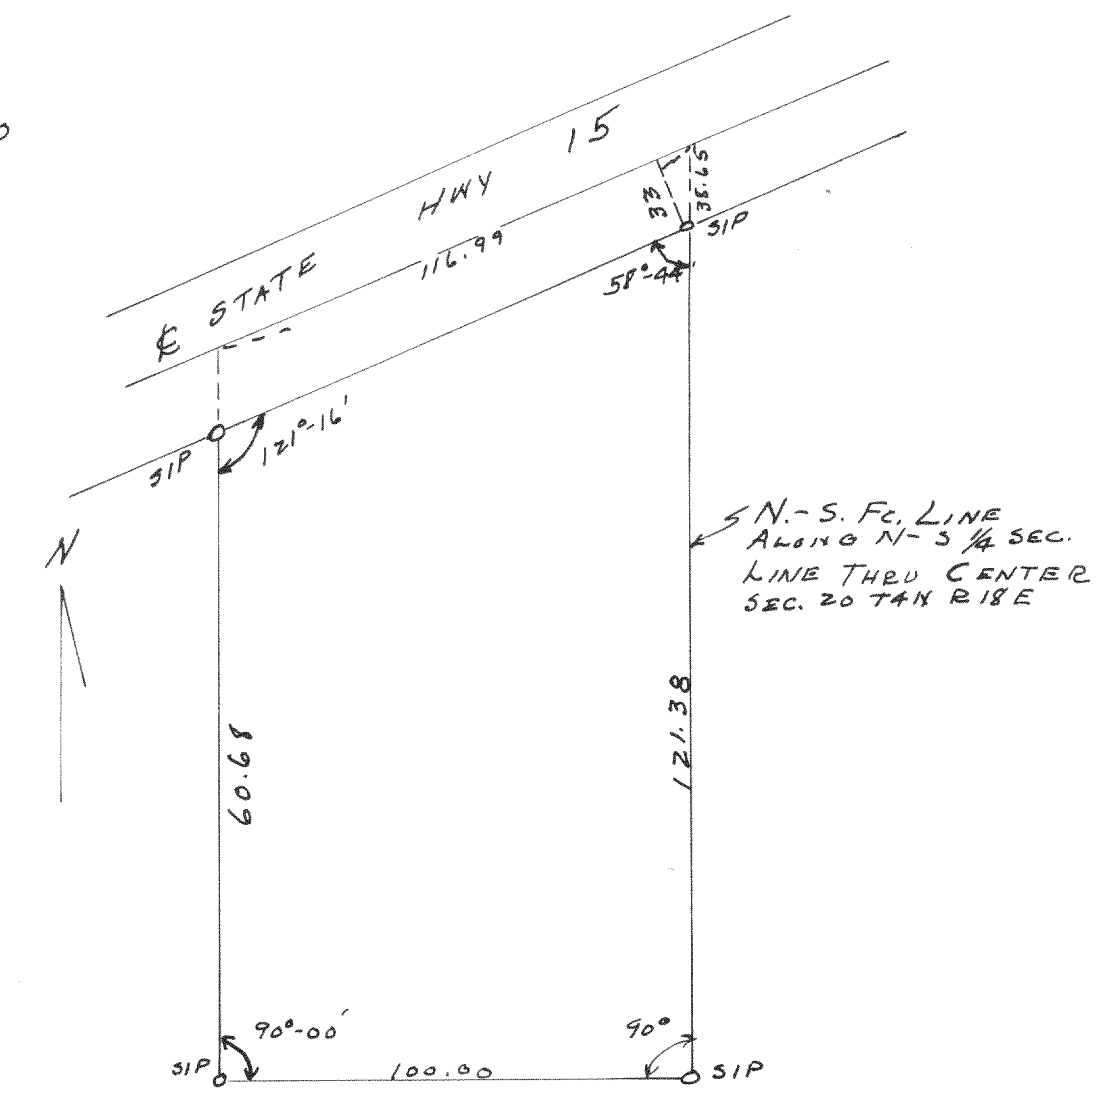

Plot of survey of a parcel of land located in the SW 1/4 of
Section 20, T4N R18E Walworth County.
April 1947 *Floyd L. Jensen*
Civil E.

1991

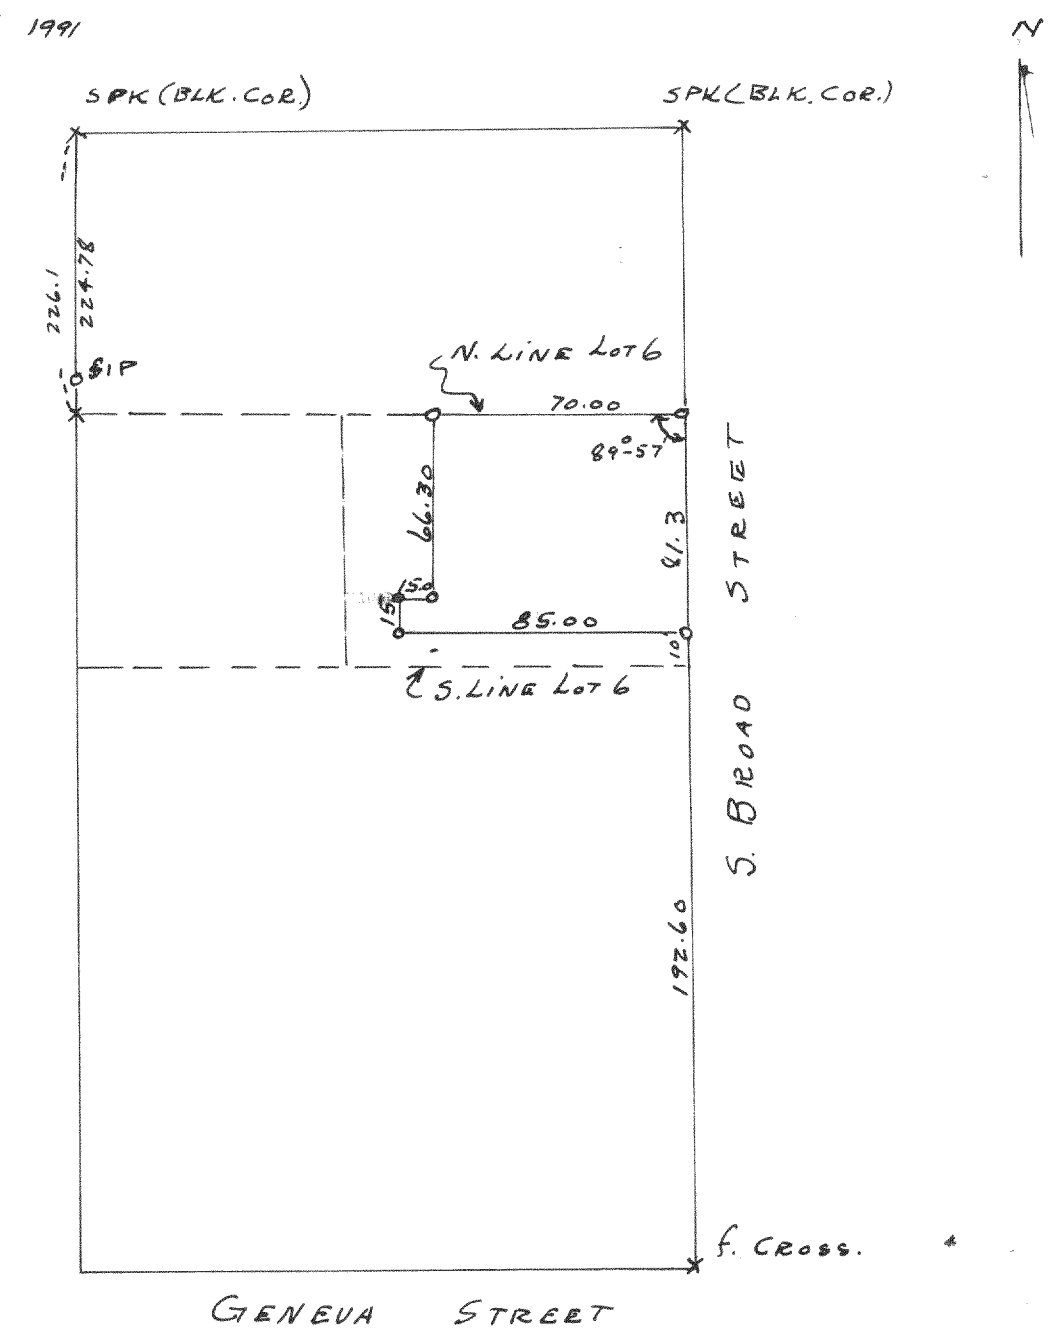

Plot of survey of part of lot 6 Blk 27 of the
Original Town, City of Elkhorn, Walworth County
January 1949 *Floyd L. Jensen*
Civil E.