



1992

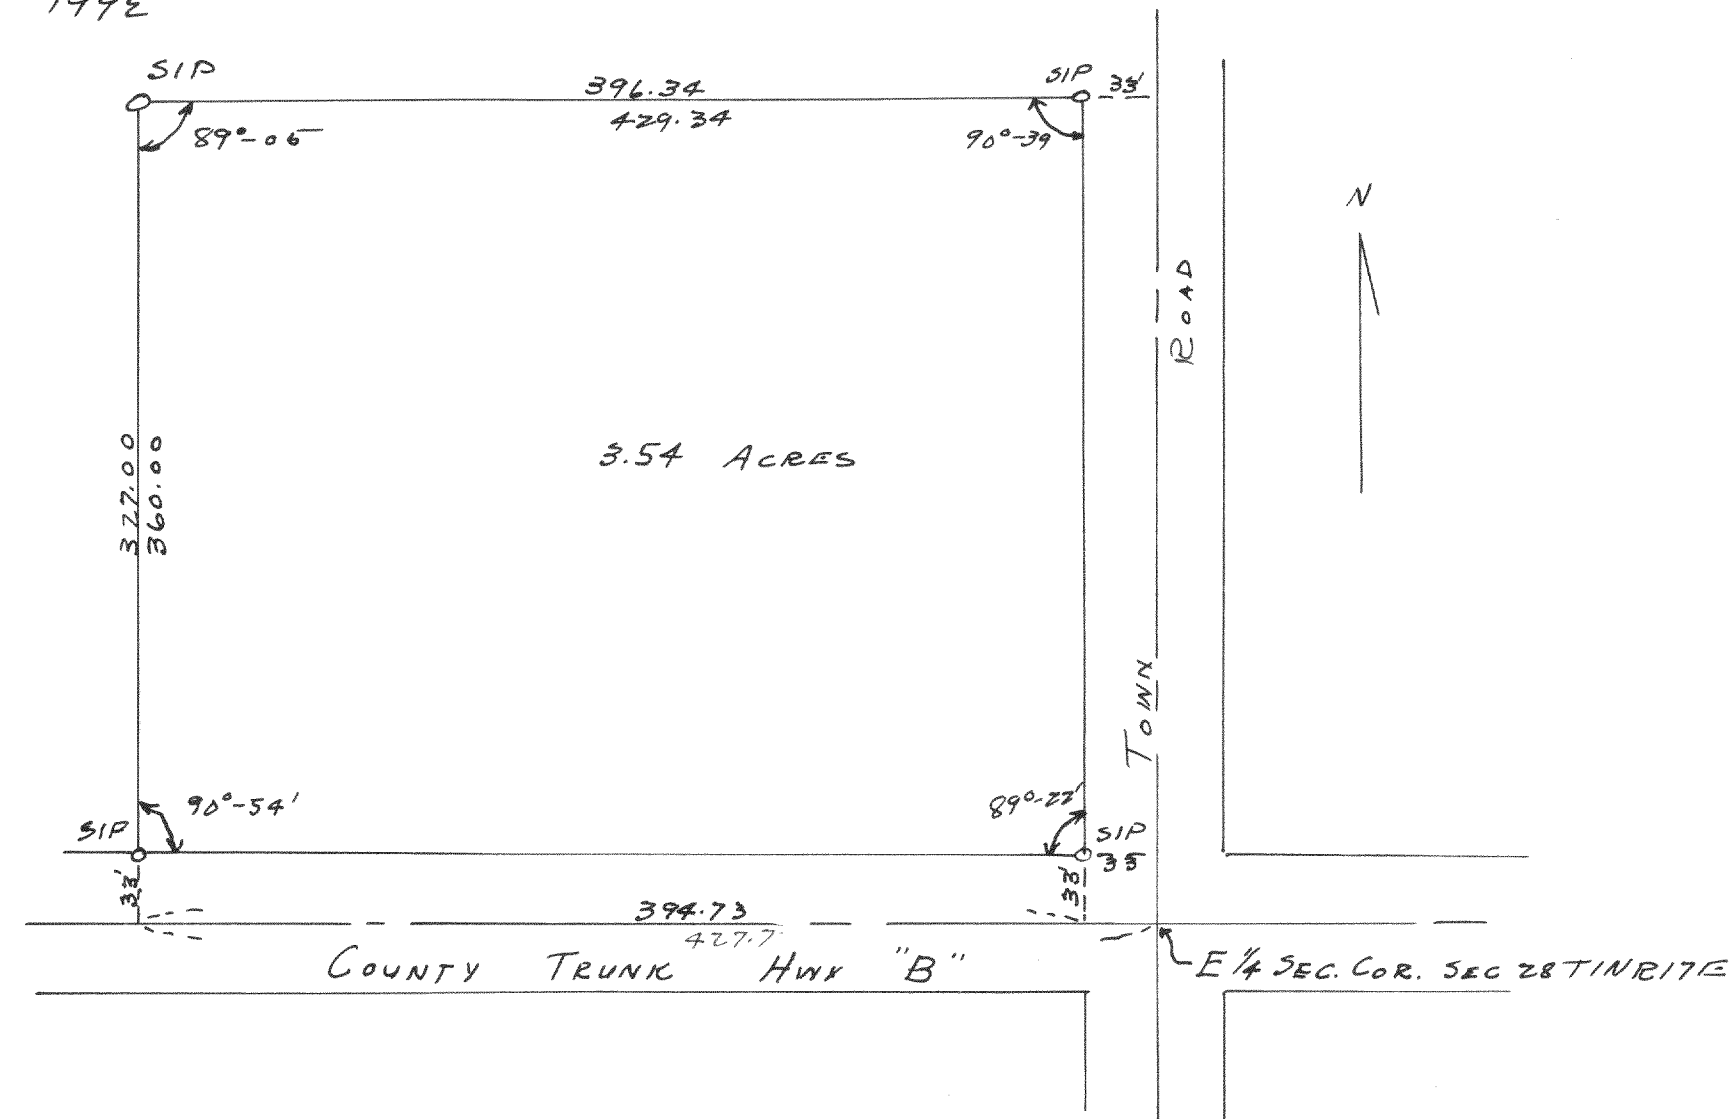

Plot of Survey of a parcel of land located in the NE 1/4 of
 Section 28 T1N R17E Walworth County
 April 7, 1948 Lloyd L. Jensen
 C.S.S.

1993

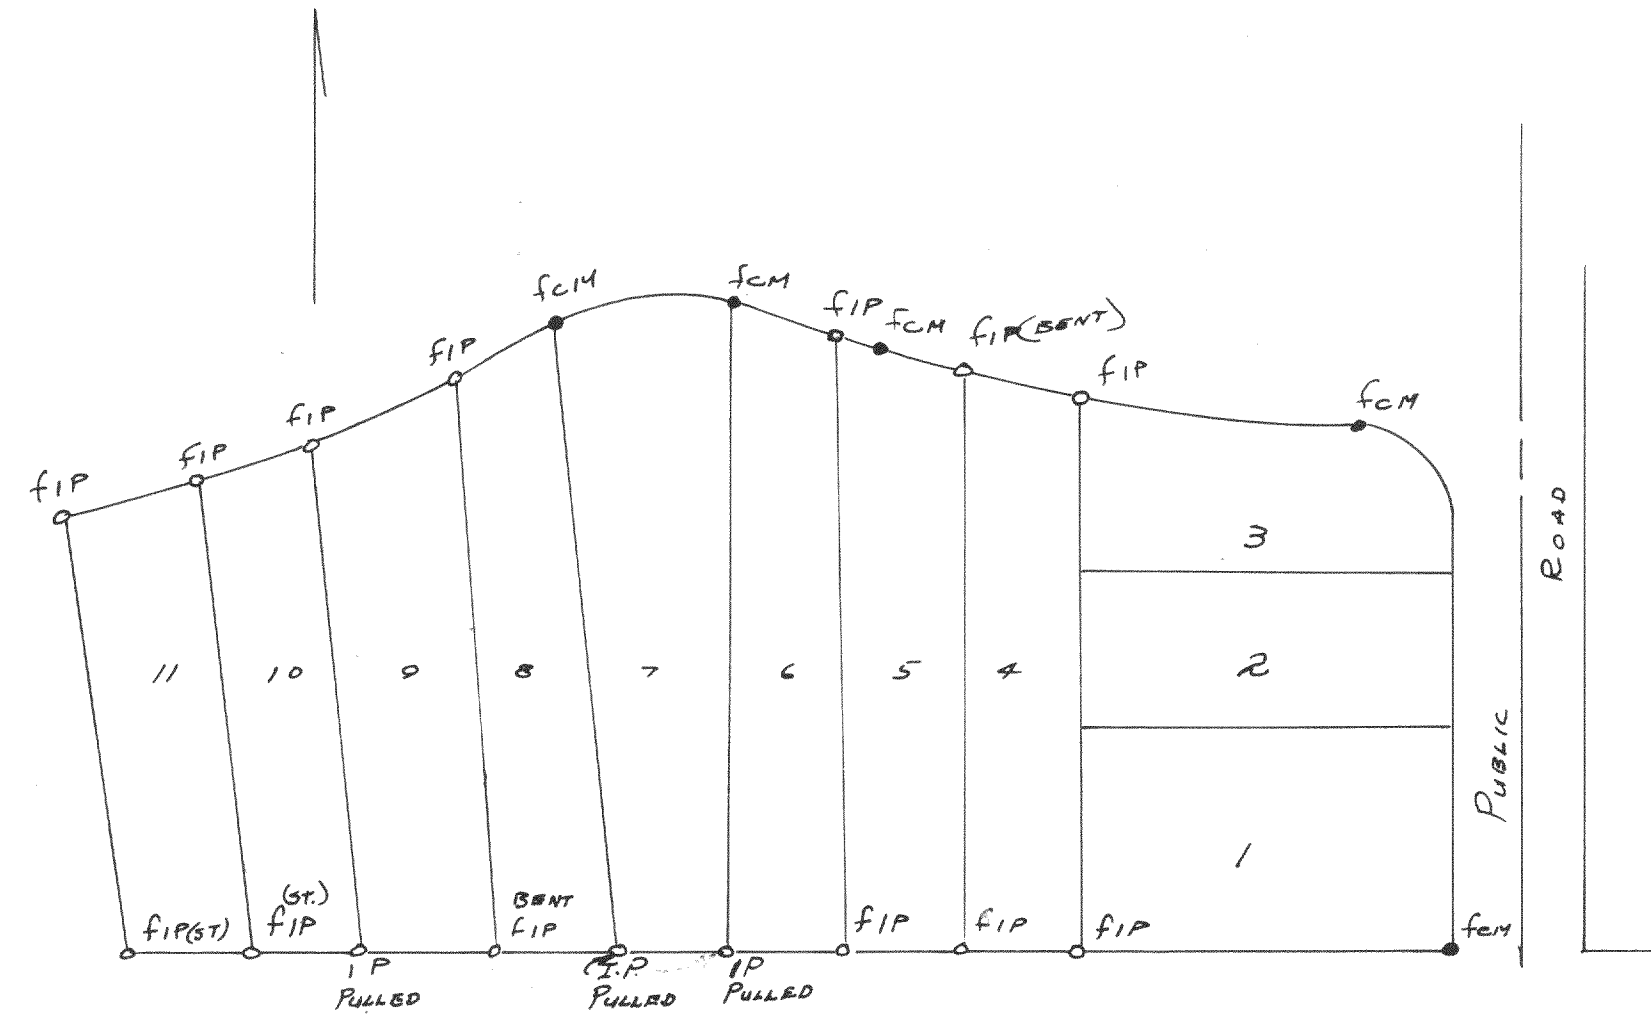

Plot of relocating the corners of lots 1-11, Block 2 Lakeview Park
 Subdivision located in the NE 1/4 of Section 16 T1N R17E
 June 1948 Lloyd L. Jensen
 C.S.S.