


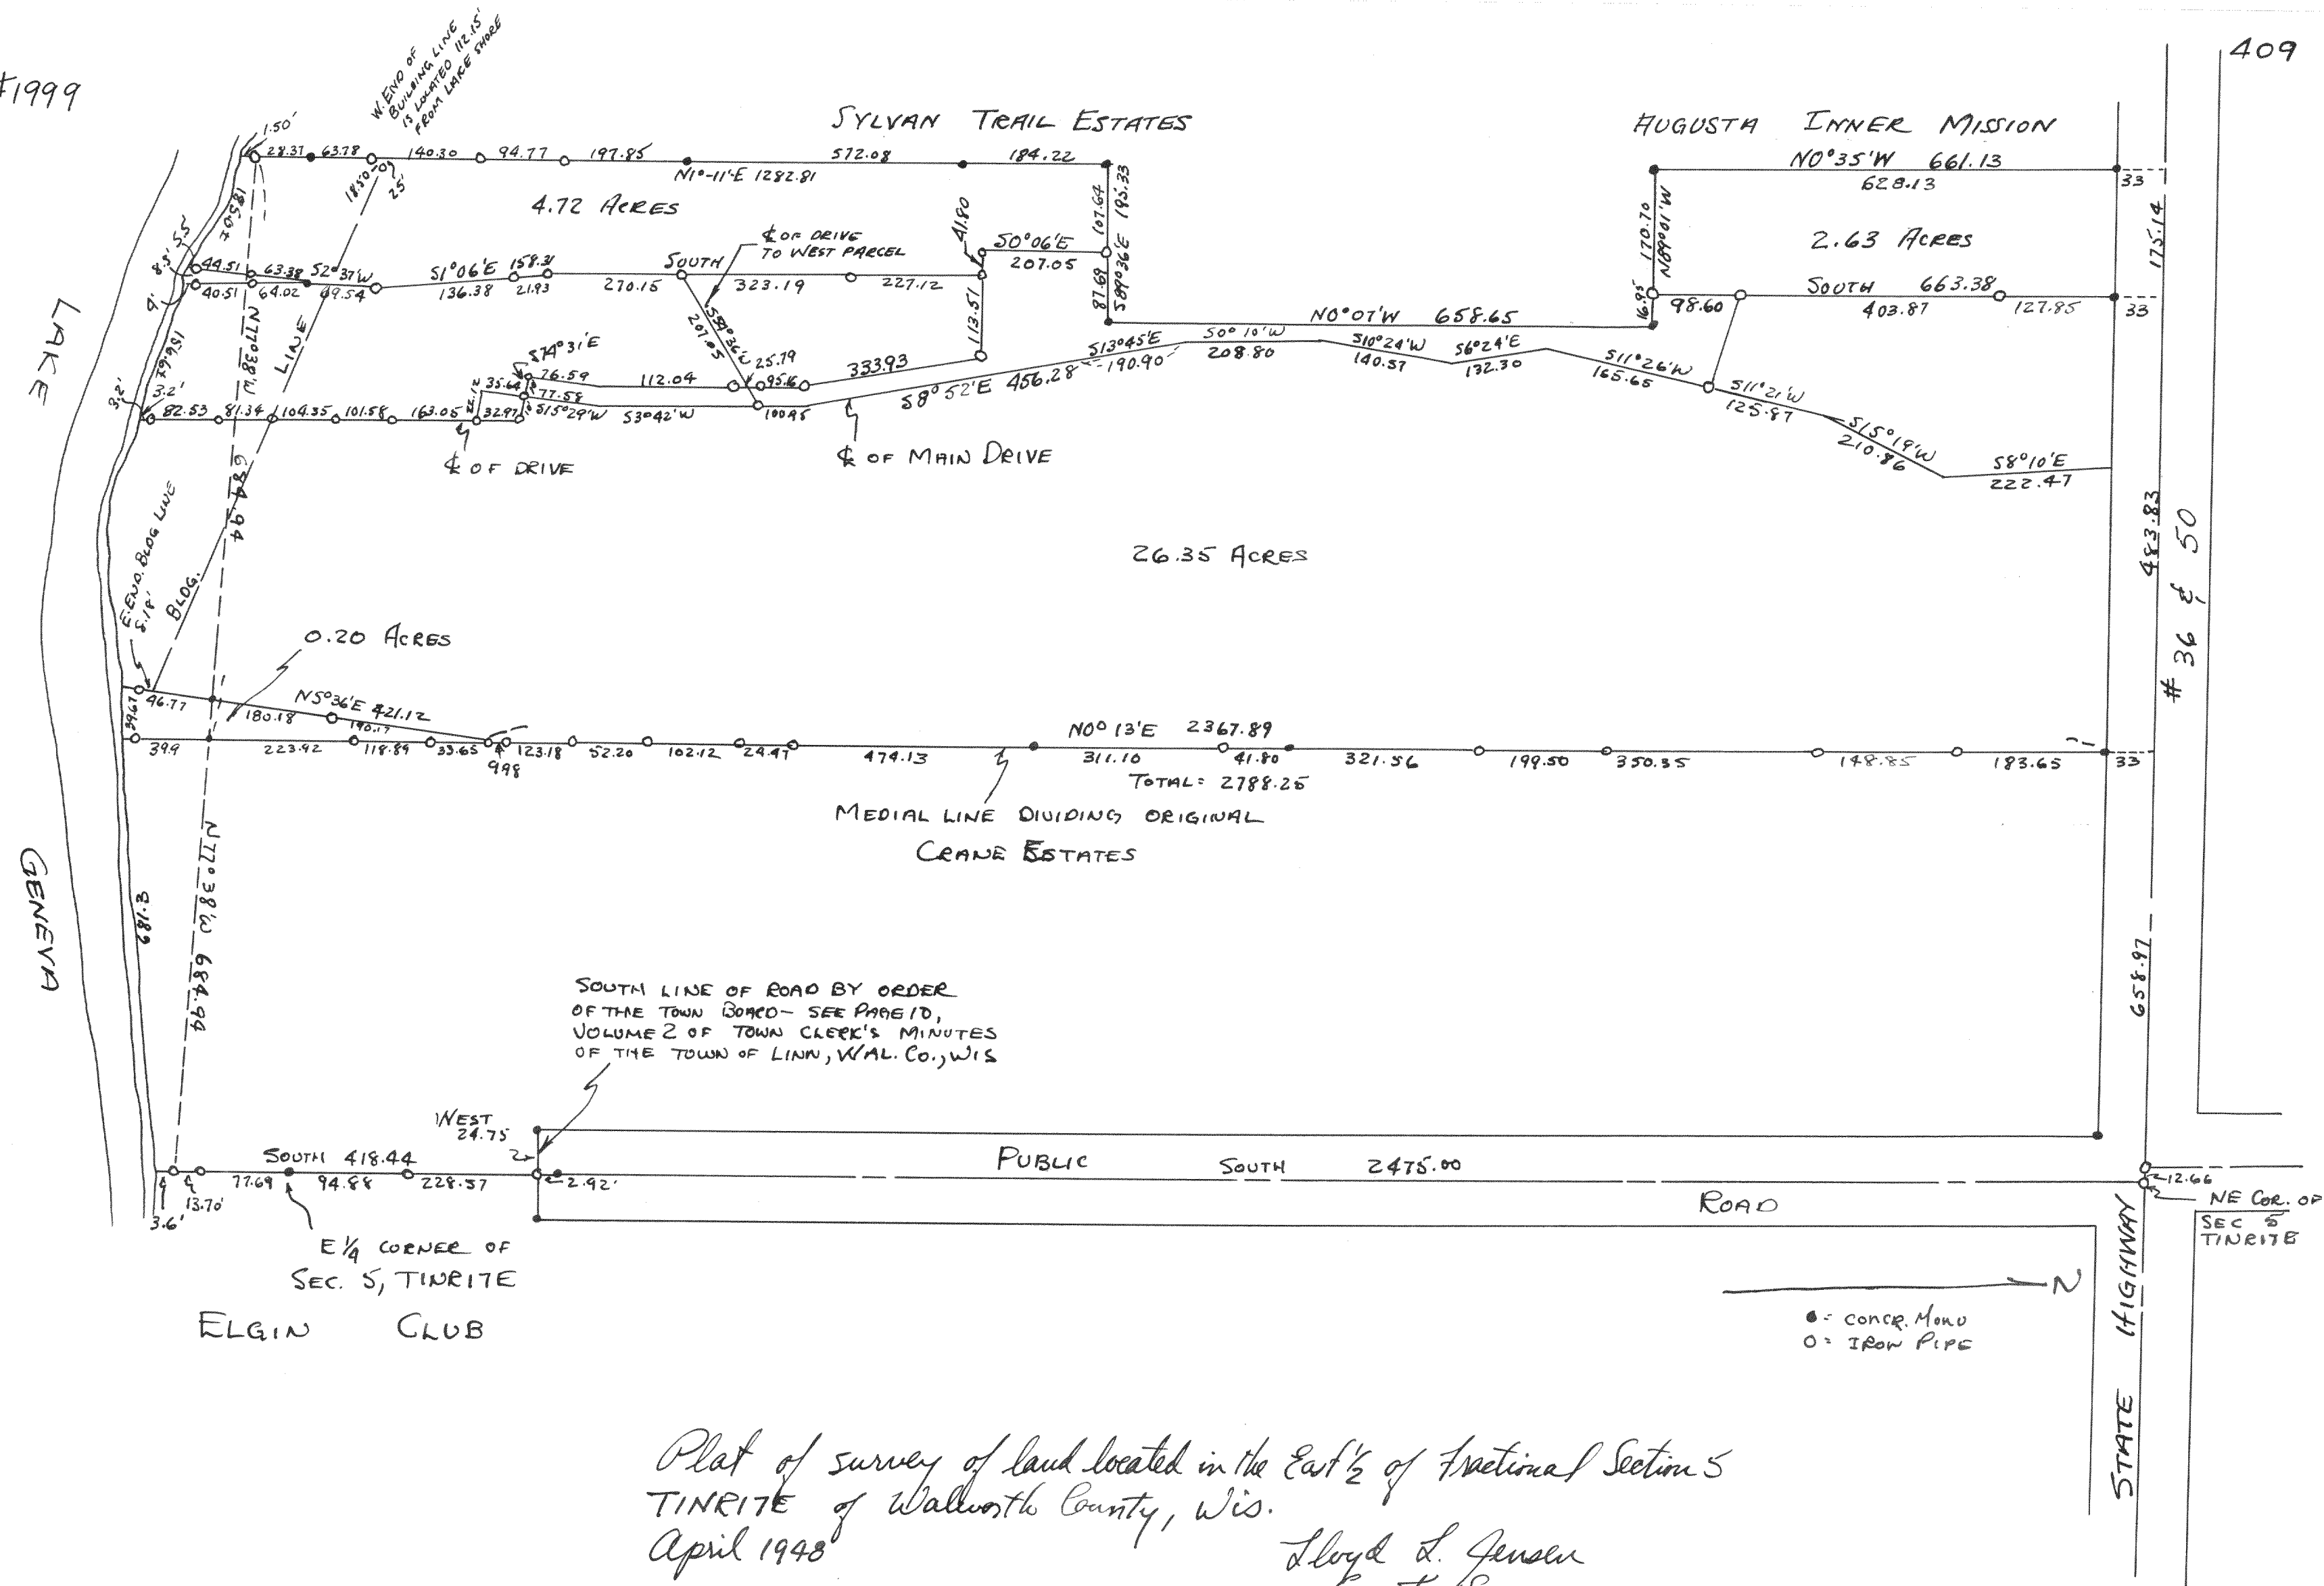

Plat of survey of land located in the East $\frac{1}{2}$ of Fractional Section 5
TINKITE of Walworth County, Wis.
April 1948 Lloyd L. Jensen

Lloyd L. Jensen
County Surveyor
9RB